

SKETCH-MAP OF NORTH DAKOTA
SHOWING COUNTIES



NORTH DAKOTA STATE HIGHWAY DEPARTMENT

PLANS

FOR THE PROPOSED IMPROVEMENT OF A
STATE HIGHWAY
IN TRAILL COUNTY
FEDERAL AID PROJ. NO. ROS-6-200(10)388

GRADING, SURFACING & STRUCTURE

SCALES

LAYOUT SHEET: 1 IN. = 5,200 FT.
PLAN AND PROFILE DRAWINGS (HOR. 1 IN. = 10 FT.
VERT. 1 IN. = 10 FT.)
STRUCTURAL DRAWINGS: AS SHOWN
CROSS SECTION SHEETS: 1 IN. = 10 FT.

LENGTH OF PROJECT		
PROJECT	MILES-GROSS	MILES-NET
ROS-6-200(10)	0.464	0.464
TOTALS	0.464	0.464

GOVERNING SPECIFICATIONS:



Standard Specifications adopted by the North Dakota State Highway department July 1971 and approved as standard by the Federal Highway Administration Sept. 29, 1971 Required Contract Provisions (Form PR-1273) dated Sept. 1975 and others submitted herewith.

DESIGN DATA

TRAFFIC	AVERAGE DAILY	EST. 30TH MAX. HR.
CURRENT TRAFFIC (1976)	1220 PASS. 230 TRUCKS 1450 TOTAL	200
TRAFFIC FORECAST (1996)	1850 PASS. 350 TRUCKS 2200 TOTAL	310
DESIGN SPEED	70	MPH
TRAFFIC CLASSIFICATION	"M"	
MINIMUM SIGHT DISTANCE (STOPPING)	850'	
MINIMUM SIGHT DISTANCE (SAFE PASSING)	3200'	
MINIMUM PASSING SIGHT DISTANCE FOR MARKING	1200'	
STA. R.C. Box 185+61.6		DESIGN LOADING HS 20

BEG. ROS-6-200(10) STA. 171+00=
Sta. 171+00 on F-5(14)
A point 1198.6' West of the N.E. Cor. of
Sec. 2, Twp. 146N, Rge. 52W.


END ROS-6-200(10) STA. 195+50=
Sta. 195+50 on F-5(14)
A point 1251.4' East of the N.W. Cor. of
Sec. 1, Twp. 146N, Rge. 52W.

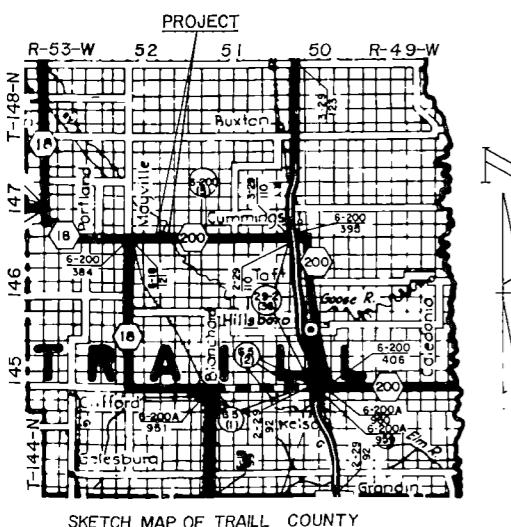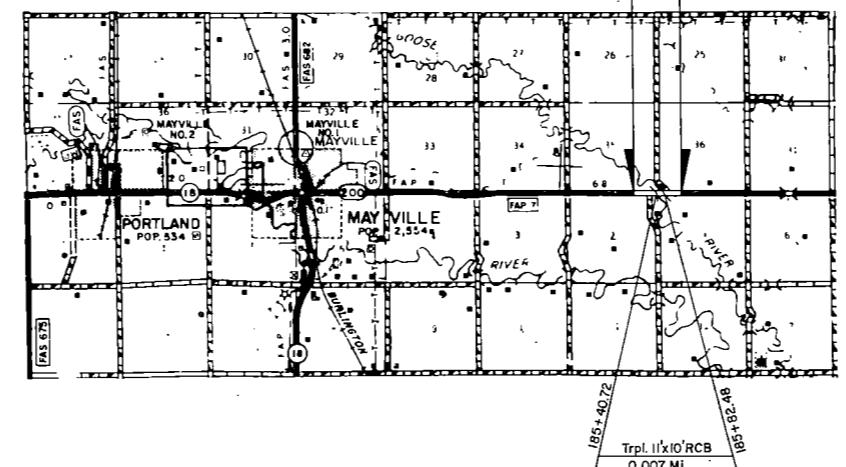

SKETCH MAP OF TRAILL COUNTY

APPROVED DATE 6-1-76

R. B. Bradley
CHIEF ENGINEER
NORTH DAKOTA
STATE HIGHWAY DEPARTMENT

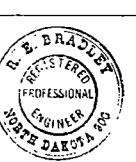


U. S. DEPARTMENT OF TRANSPORTATION
FEDERAL HIGHWAY ADMINISTRATION

APPROVED

DIVISION ENGINEER DATE

ROS-6-200(10)388



SYMBOLS

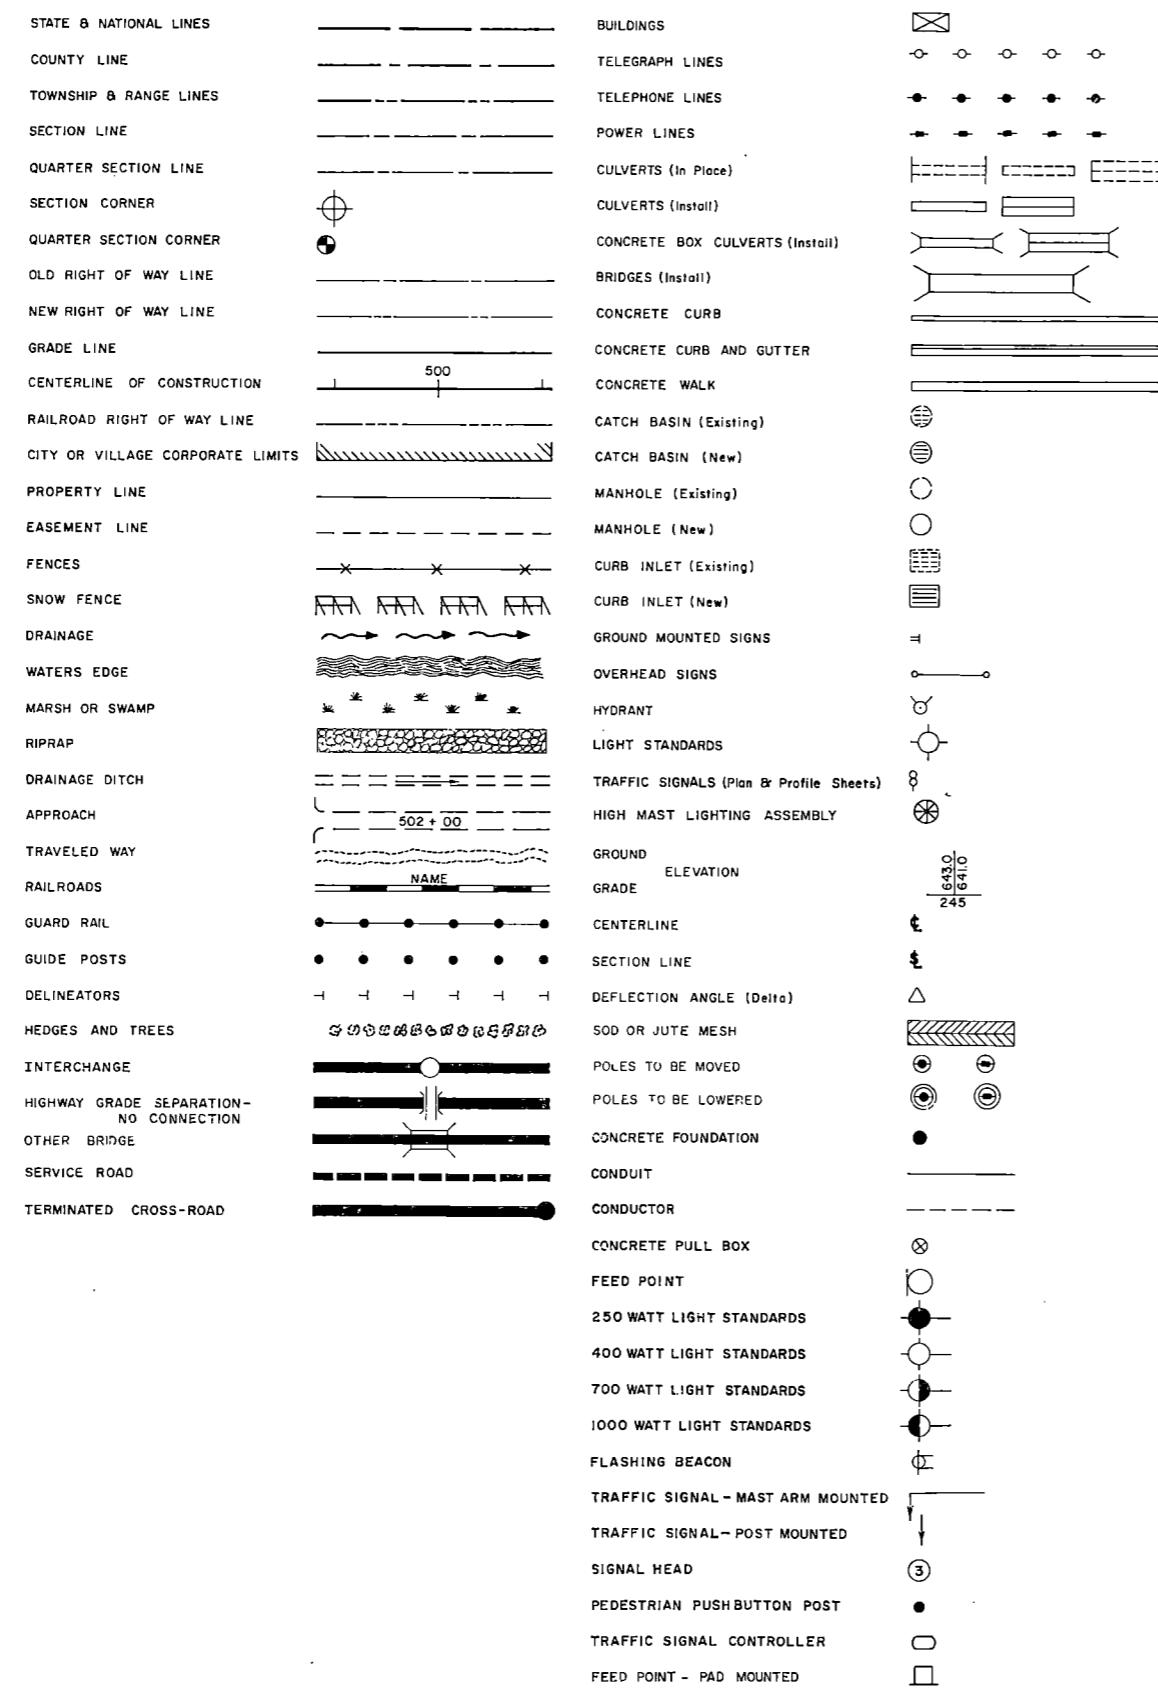


ABBREVIATIONS

Aggr.	Aggregate	M. L.	Main Line
Ahd.	Ahead	N. R.	North Roadway
Alt.	Alternate	Off. Loc.	Office Location
Approx.	Approximate or Approximately	O. to O.	Out to Out
Appr.	Approach	P. B. P.	Plan and Profile
Asph. Cem. or A.C.	Asphalt Cement	P. C.	Point of Curvature
Asph. Conc.	Asphaltic Concrete	P.C.C.	Point of Compound Curve
Bit.	Bituminous or Bitumen	P.C.C. Pvm't	Portland Cement Concrete Pavement
Bx.	Back	P. D.	Private Drive
B. M.	Bench Mark	Pen.	Penetration
Bldg.	Building	Perf.	Perforated
Br.	Bridge	P. I.	Point of Intersection
C.A.E.S.	Corrugated Aluminum End Section	P. O. C.	Point on Curve
C.A.P.	Corrugated Aluminum Pipe	P. O. T.	Point on Tangent
C. B.	Curb Basin	P. P.	Power Pole
C. B. G.	Curb and Gutter	P. R. C.	Point of Reverse Curvature
Ch. Blk.	Channel Block	Pref.	Preformed
Ch. Ch.	Channel Change	P.S.D.	Passing Sight Distance
C. I.	Curb Inlet	P.T.	Point of Tangency
C.I.P.	Cast Iron Pipe	P.V.C.	Polyvinyl Chloride Sewer Pipe
Cl.	Class	Quant.	Quantity or Quantities
C.S.E.S.	Corrugated Steel End Section	R	Radius
C.S.P.	Corrugated Steel Pipe	R or Rge.	Range
CMS	Cationic Medium Setting	R.C.	Rapid Curing
Comp.	Compression	R.C.E.S.	Reinforced Concrete End Section
Const.	Construction	R.C.P.	Reinforced Concrete Pipe
Conc.	Concrete	R.C.P.S.	Reinforced Concrete Pipe Sewer
Cont. Reinf. Conc.	Continuously Reinforced Concrete	Rd.	Road
	Pvm't	Rdbd.	Roodbed
Contn.	Pavement	Rdw.	Roadway
Crn.	Contraction	Refl.	Reflected
CRS	Crown	R. R.	Railroad
Crse.	Cationic Rapid Setting	Rt.	Right
C. S.	Course	R/W	Right of Way
C. to C.	Curve to Spiral	Solv.	Salvage
C.Y.	Center to Center	San.	Sanitary
D	Cubic Yard	S.C.	Spiral to Curve
D-Load	Degree of Curvature	SC	Slow Curing
D.B.	Dead Load	Sc	Spiral Deflection Angle
Def.	Ditch Block	S.D.	Sight Distance
Del.	Deformed	S.E.	Superelevation
D.G.	Deliver	Sec.	Section
E.I. or Elev.	Ditch Grade	Sec. Line Appr.	Section Line Approach
Ellipt.	Elevation	Sep.	Separation
Emb.	Elliptical	Serv.	Service
Emul.	Embankment	Sgr. Prep.	Subgrade Preparation
Engr.	Emulsified	Shldr.	Shoulder
Eq.	Engineer	SP	Special Provision
E. R.	Equation	S.P.P.	Structural Plate Pipe
E.S.	East Roadway	S.P.P.A.	Structural Plate Pipe Arch
Esm.	End Section	S.R.	South Roadway
Exc.	Easement	SS	Slow Setting or Supplement Specification
Exp.	Excavation	S.S.D.	Stopping Sight Distance
F. D.	Expansion	S.T.	Spiral to Tangent
Found.	Field Drive	Sta.	Station
F. P.	Foundation	Std.	Standard
Furn.	Fence Post	Std. Specs.	Standard Specifications
Go.	Furnish	Struct.	Structure
Gr.	Gage or Gauge	Surf.	Surface or Surfacing
Grd.	Gravel	Surv.	Survey
G. V.	Graded	S.W.	Sidewalk
Hel.	Gate Valve	S.Y.	Square Yard
Hyd.	Helical	T.	Tangential Length (circular curve)
Ident.	Hydrant	T or Twp.	Township
Inch.	Identification	Tel.	Telephone
I. M.	Interchange	Temp.	Temporary
Inst.	Iron Monument	T.P.	Telephone Pole
Inter.	Install	Tr.	Traffic
Inv.	Intersection	Trans.	Transverse or Transition
Jt.	Invert	Trid.	Treated
L	Joint	Ts	Tangent Length (curve with spirals)
Lc	Length of Curve	T. S.	Tangent to Spiral
Levg.	Length of Spiral	U.S.C. & G.S.	United States Coast and Geodetic Survey
L. F.	Leveling	V.C.	Vertical Curve
Liq.	Linear or Lineal Foot	V.C.P.	Vitrified Clay Pipe
Long	Liquid	W.M.	Water Main
L. P.	Longitudinal	W.M.V.	Water Main Valve
L.	Light Pole	W. R.	West Roadway
"M"	Left	Wrg.	Wearing
Matl.	One Thousand	W.S.V.	Water Service Valve
Max.	Material	X-Sec.	Cross Section
MC	Maximum	Xc	Spiral Coordinate
M.H.	Medium Curing	Yc	Spiral Coordinate
Min.	Manhole		
	Minimum		


BENCH MARKS		
NO	DESCRIPTION	LOCATION
ELEV.		
2	Iron Pin by T.P.	177+95 - 95' R.R.
M-434	S.E. Cor. of Granary	180+54 - 117' Lt.
Br	S.W. Cor. of S.W. Wing Wall	185+30 - 14' R.R.
3	Iron Pin by F.P.	188+28 - 126' Lt.
4	Iron Pin by T.P.	194+60 - 98' R.R.

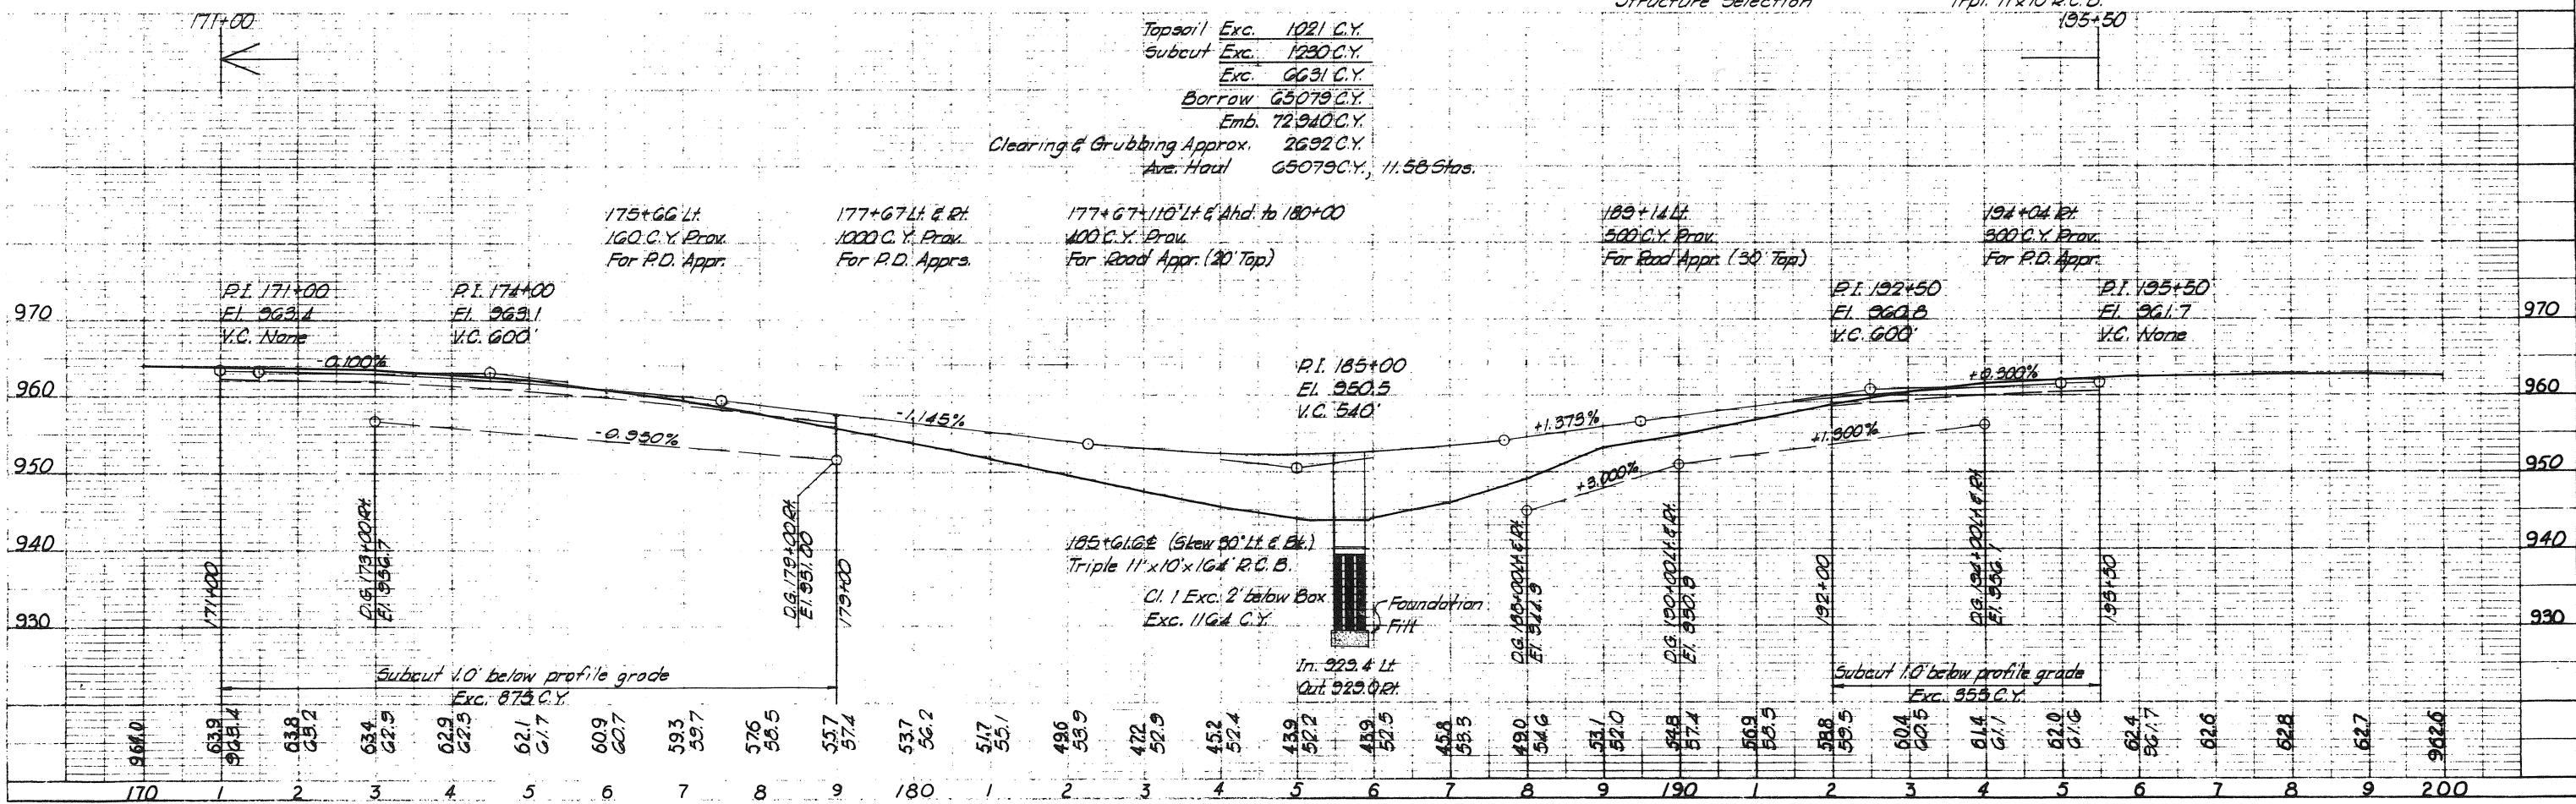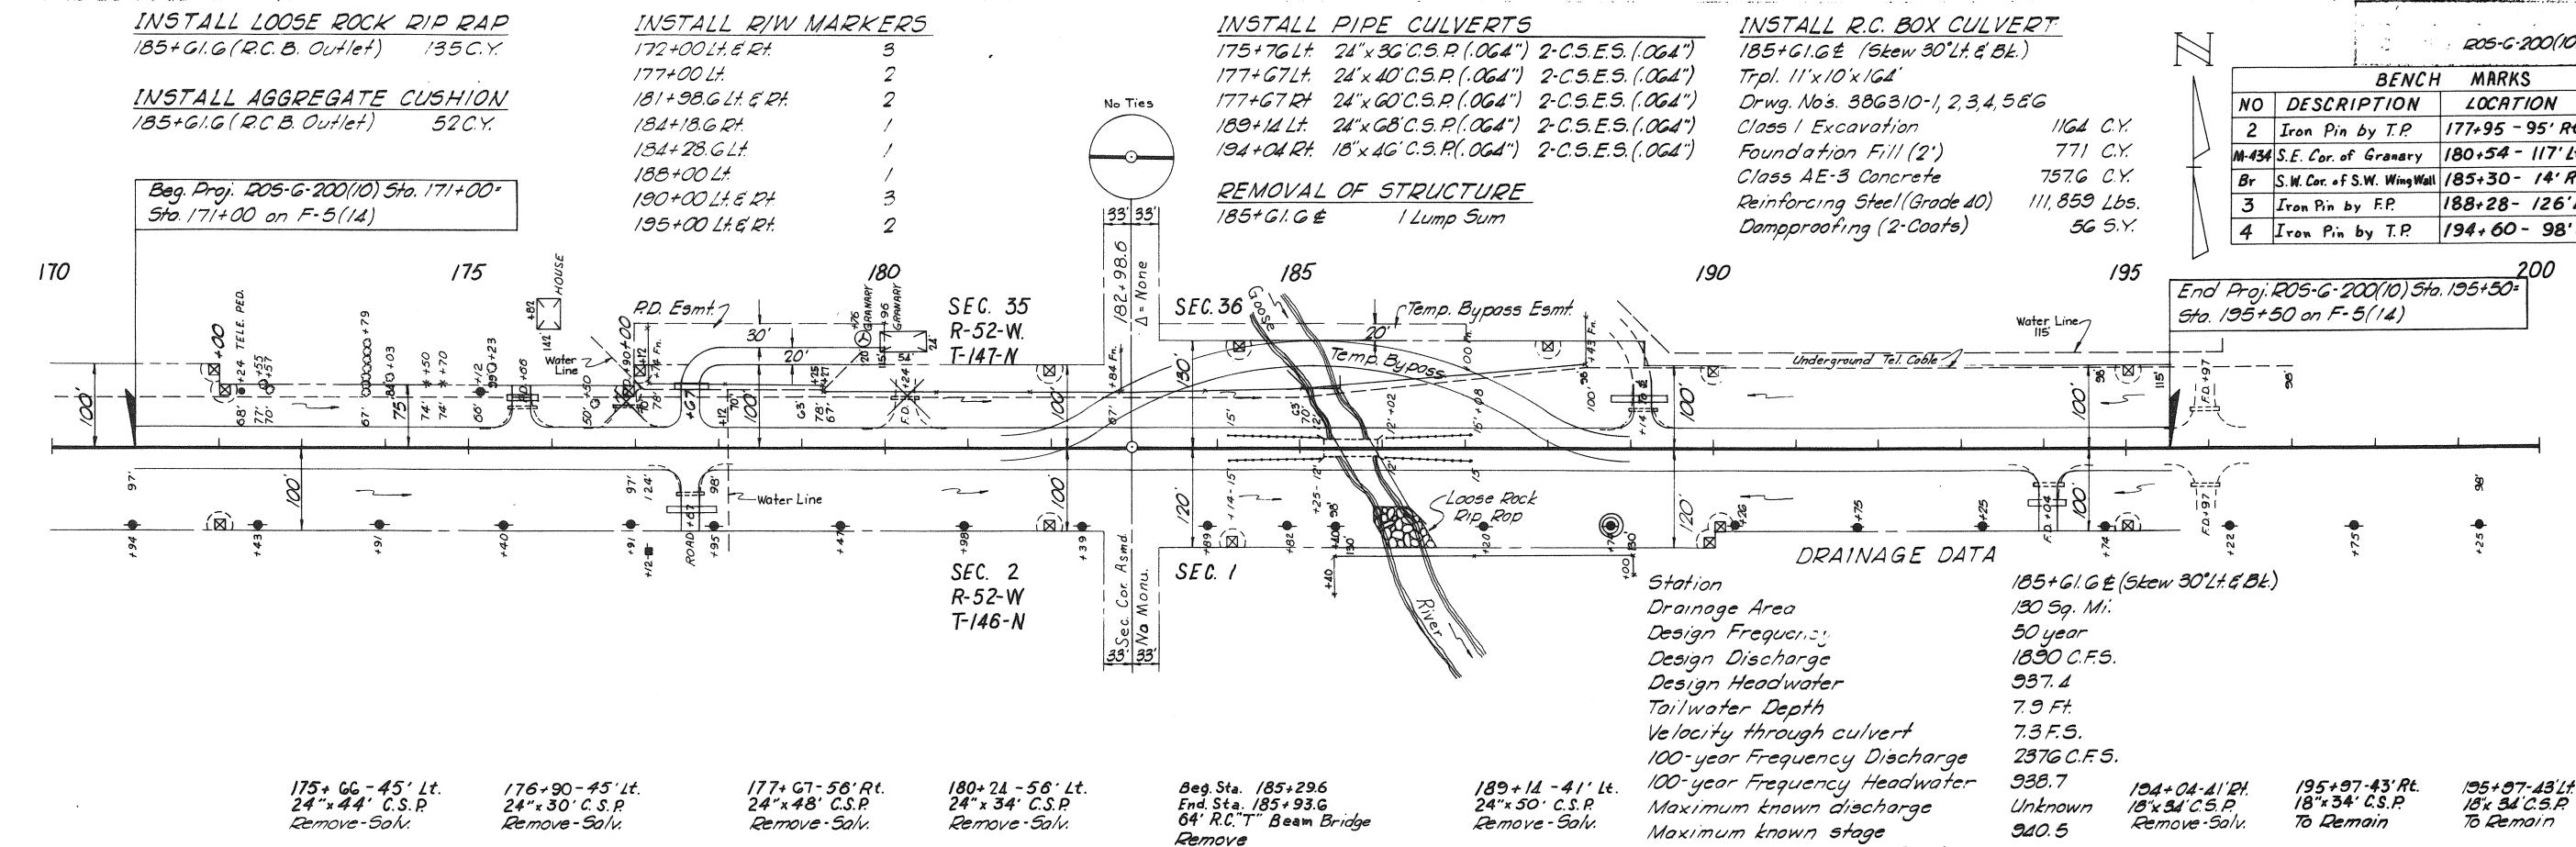


500

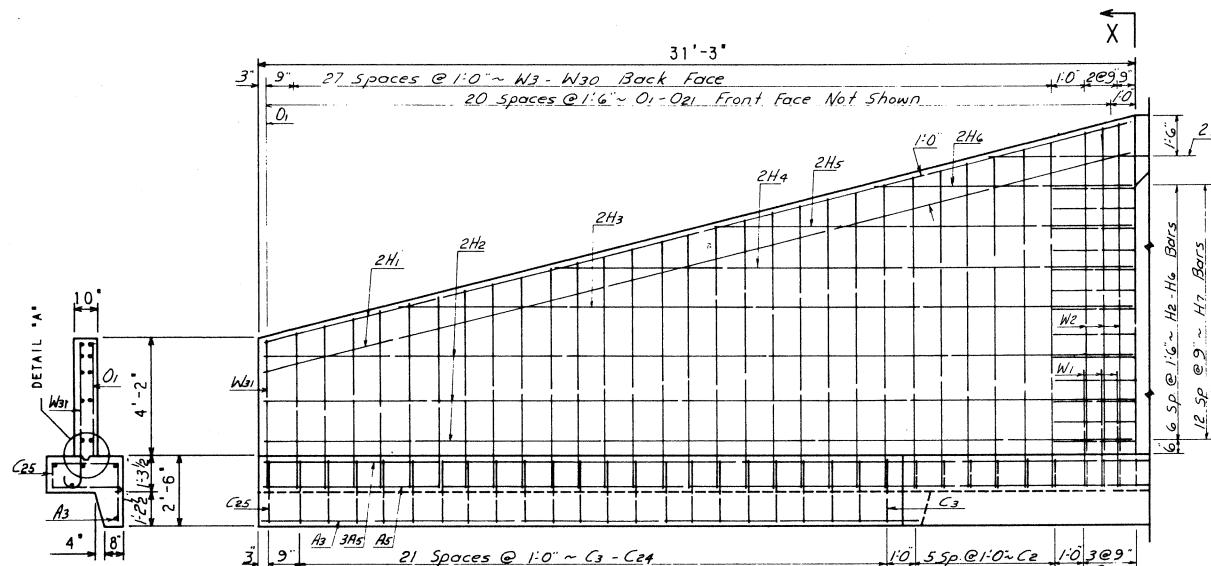


LONG WING ELEVATION

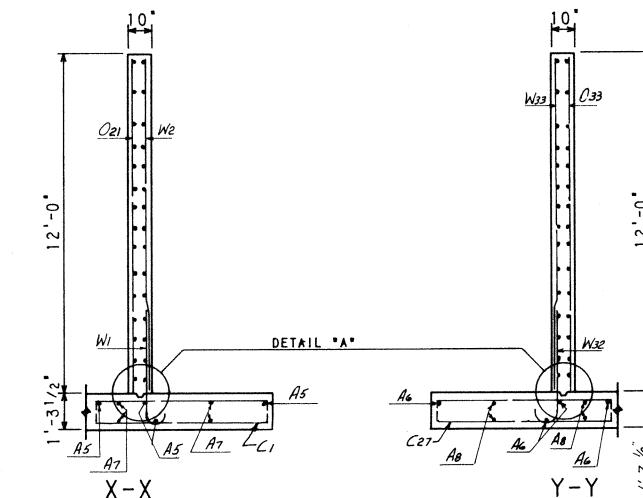

SHORT WING ELEVATION

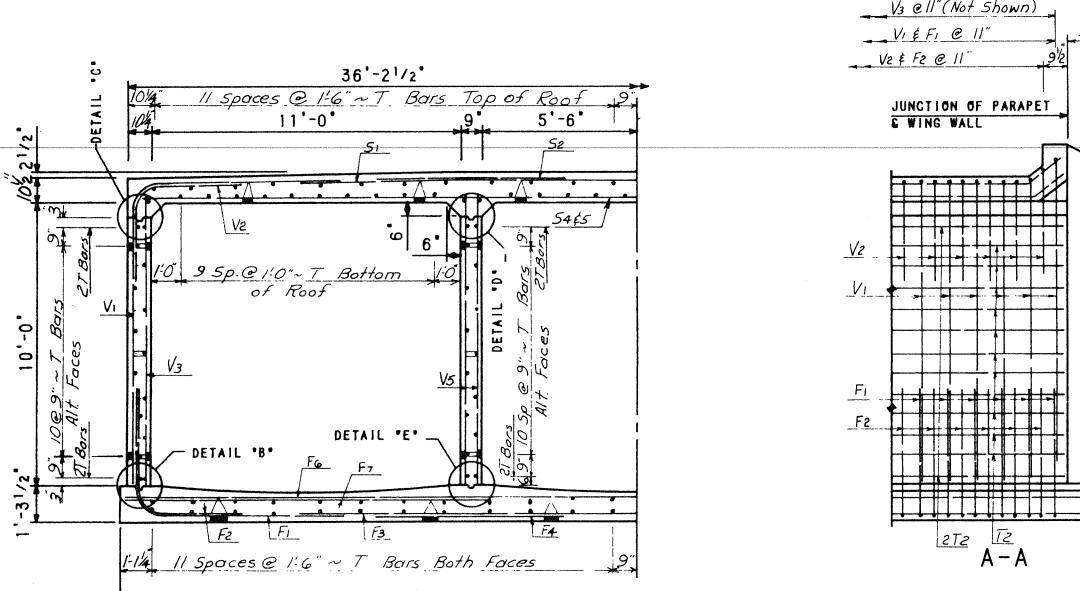


HALF SECTION OF BARREL

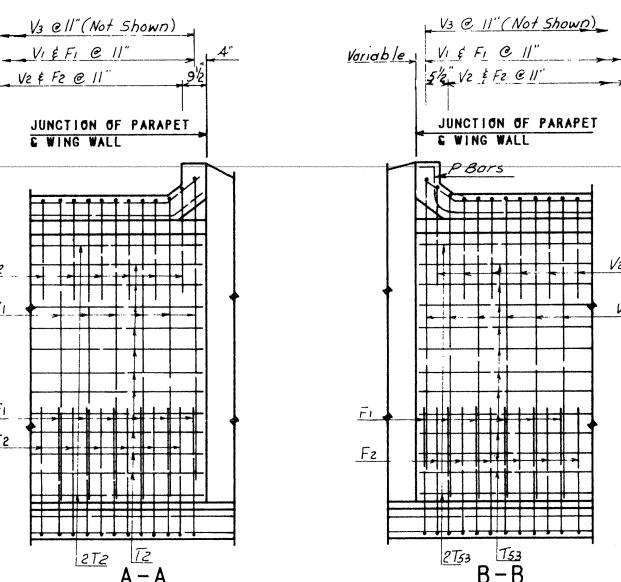

Architectural drawing of a wall section C-C. The wall height is 9'-6". The top horizontal dimension is 6'-8". The thickness of the wall is 5 1/4". The drawing shows a stepped profile with a vertical reinforcement of 2 F53 at the base. The wall is divided into 10 horizontal layers. Reinforcement is placed in the first seven layers, labeled as follows:

- Layer 1: 2 V6
- Layer 2: 2 V7
- Layer 3: 2 V8
- Layer 4: 2 V9
- Layer 5: 2 V10
- Layer 6: 2 V11
- Layer 7: 2 V12

At the top right, there is a note: *T4-Tis This Wall
T17-Tes Other End*. At the bottom right, there is a note: *2 T3 This Wall
2 T16 Other End*. The bottom horizontal dimension is 1'-0".

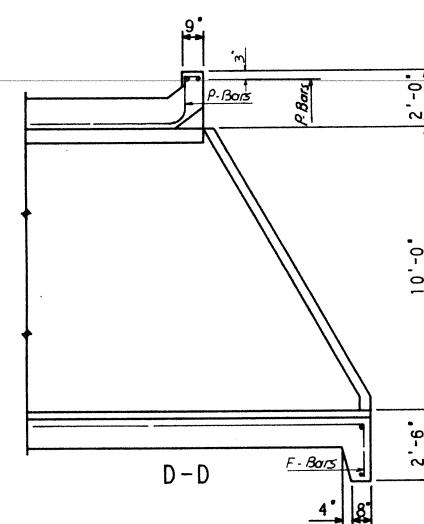


1-10
NORTH DAKOTA
STATE HIGHWAY DEPARTMENT
STANDARD
REINFORCED CONCRETE
TRIPLE BOX CULVERT
SKewed 30°
CLEAR SPAN 3x11' CLEAR HEIGHT 10'
MAXIMUM FILL 15'



PRO. NO.	STATE	PRO. NO.	OWNER	DATE
8	N.D.	EDS-G-200(10)	9	

MADE BY
QUANTITIES CHECKED BY

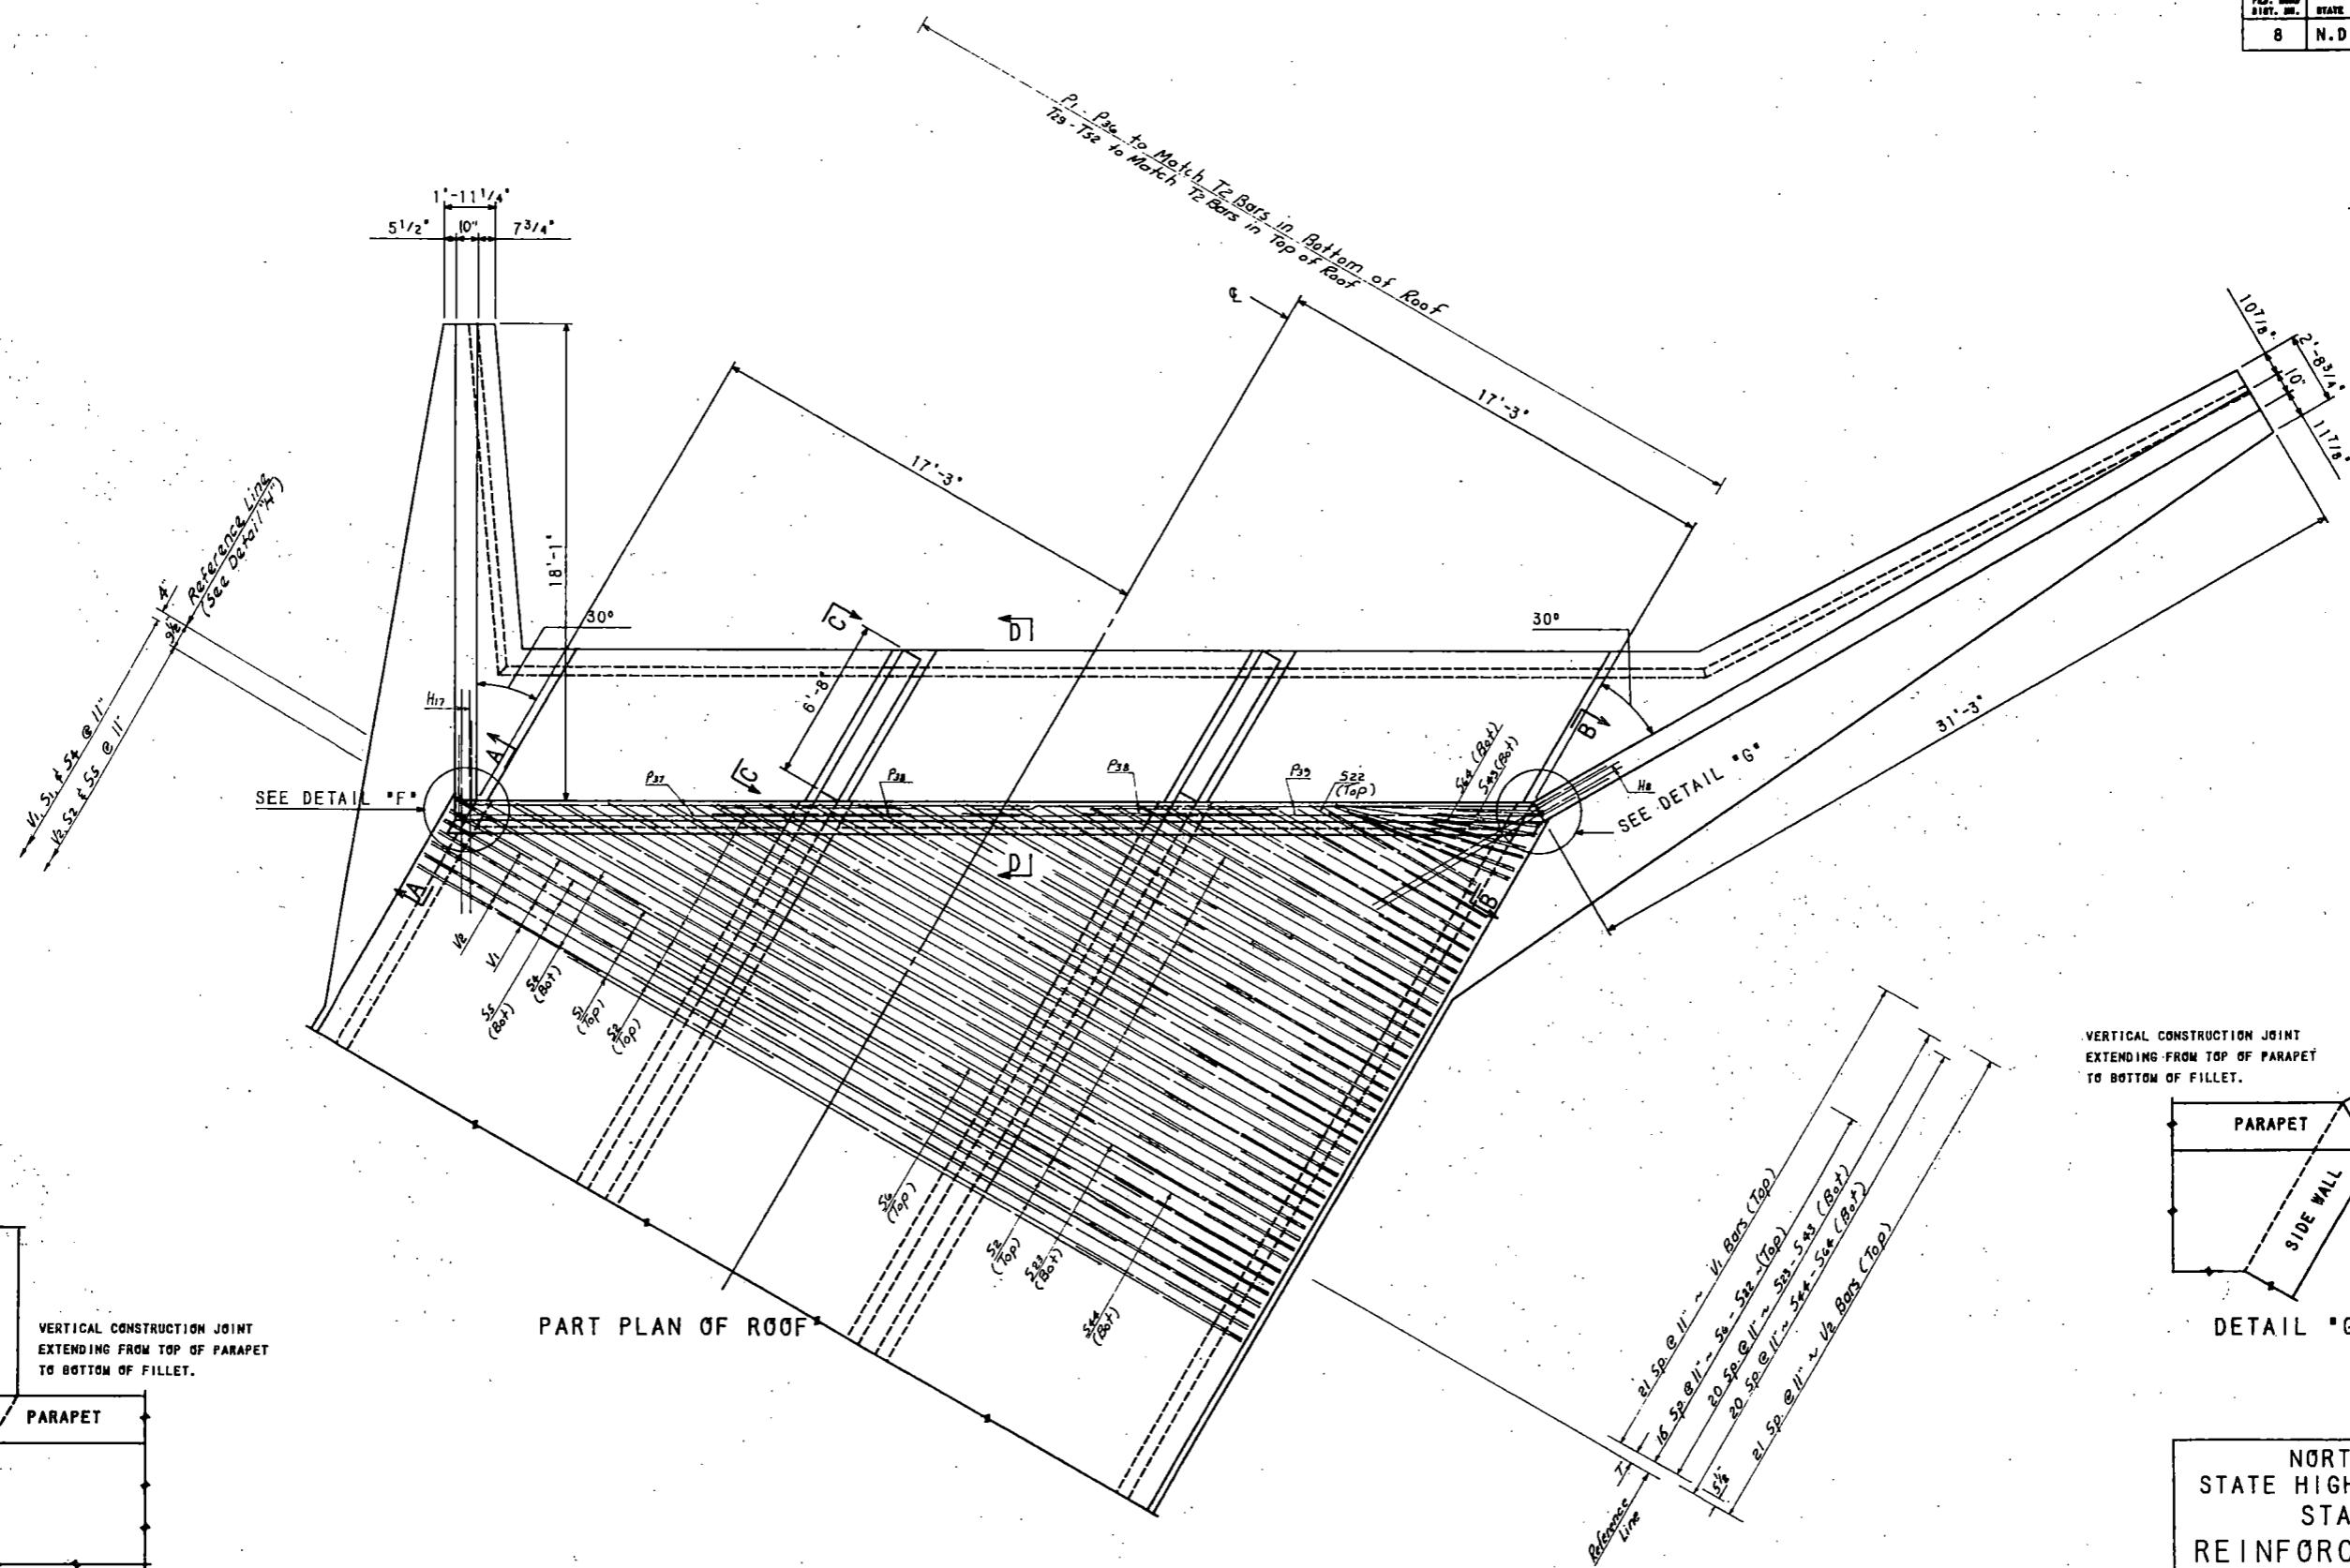


NORTH DAKOTA
STATE HIGHWAY DEPARTMENT
STANDARD
REINFORCED CONCRETE
TRIPLE BOX CULVERT
SKEWED 30°
CLEAR SPAN 3x11' CLEAR HEIGHT 10'
MAXIMUM FILL 15'

APPROVED 5-10 1926 S. 1/2" C. 1/2" 1/2" Bars (Top)
BRIDGE ENGINEER



PER. REGD. DIST. REC.	STATE	PER. A 10 PER. REC.		NET REC.	TOTAL AMOUNT
8	N.D.	205-6-200(10)		10	

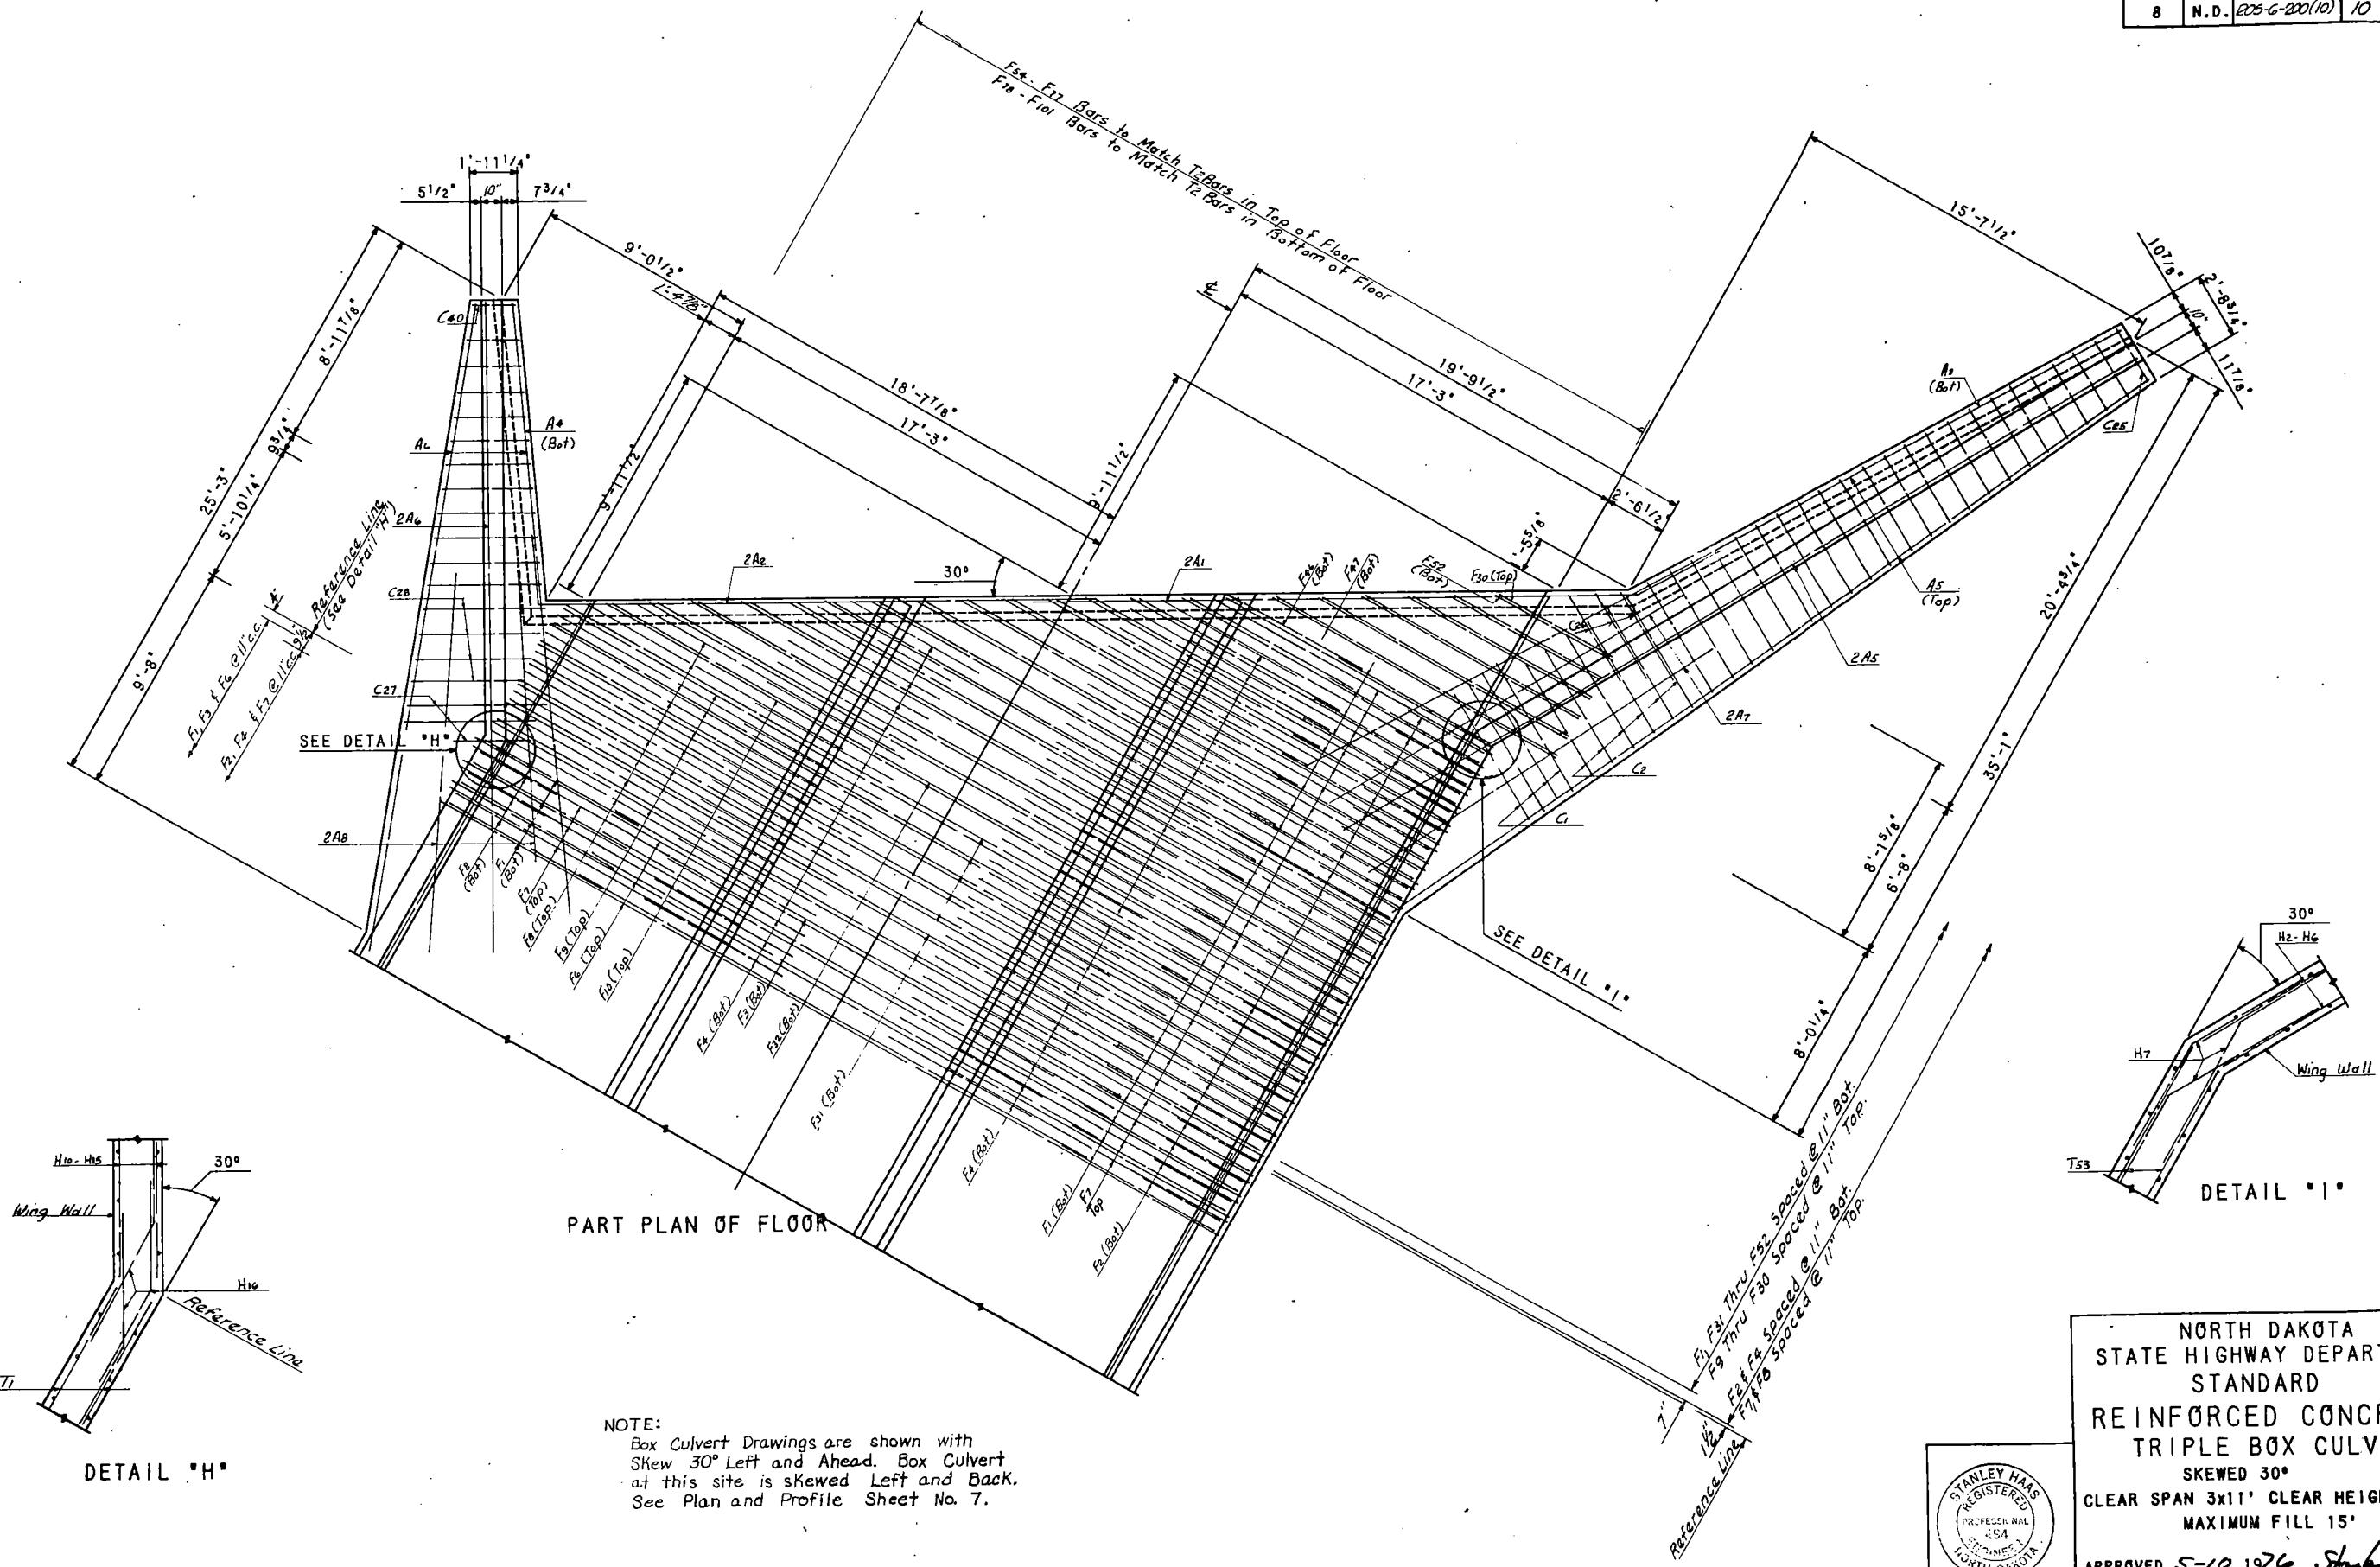


NOTE: Box Culvert Drawings are shown with Skew 30° Left and Ahead. Box Culvert at this site is skewed Left and Back. See Plan and Profile Sheet No. 7.


NORTH DAKOTA
STATE HIGHWAY DEPARTMENT
STANDARD
REINFORCED CONCRETE
TRIPLE BOX CULVERT
SKewed 30°
CLEAR SPAN 3x11' CLEAR HEIGHT 10
MAXIMUM FILL 15'




FDL. ROAD DIST. NO.	STATE	FDL. AID PROJ. NO.					
8	N.D.	625-G-20070	11				

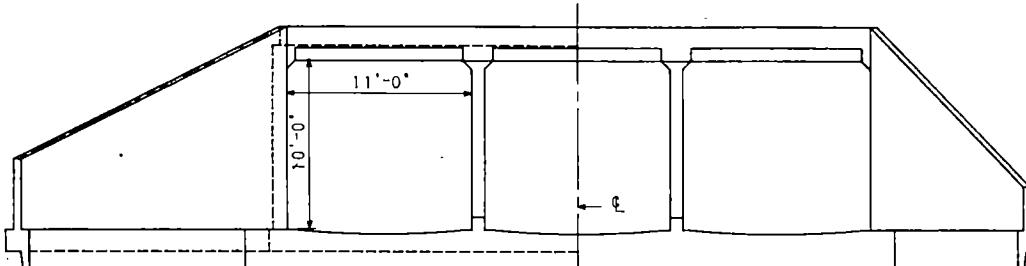


END VIEW

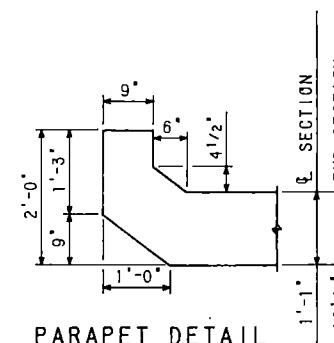


PARAPET DETAIL

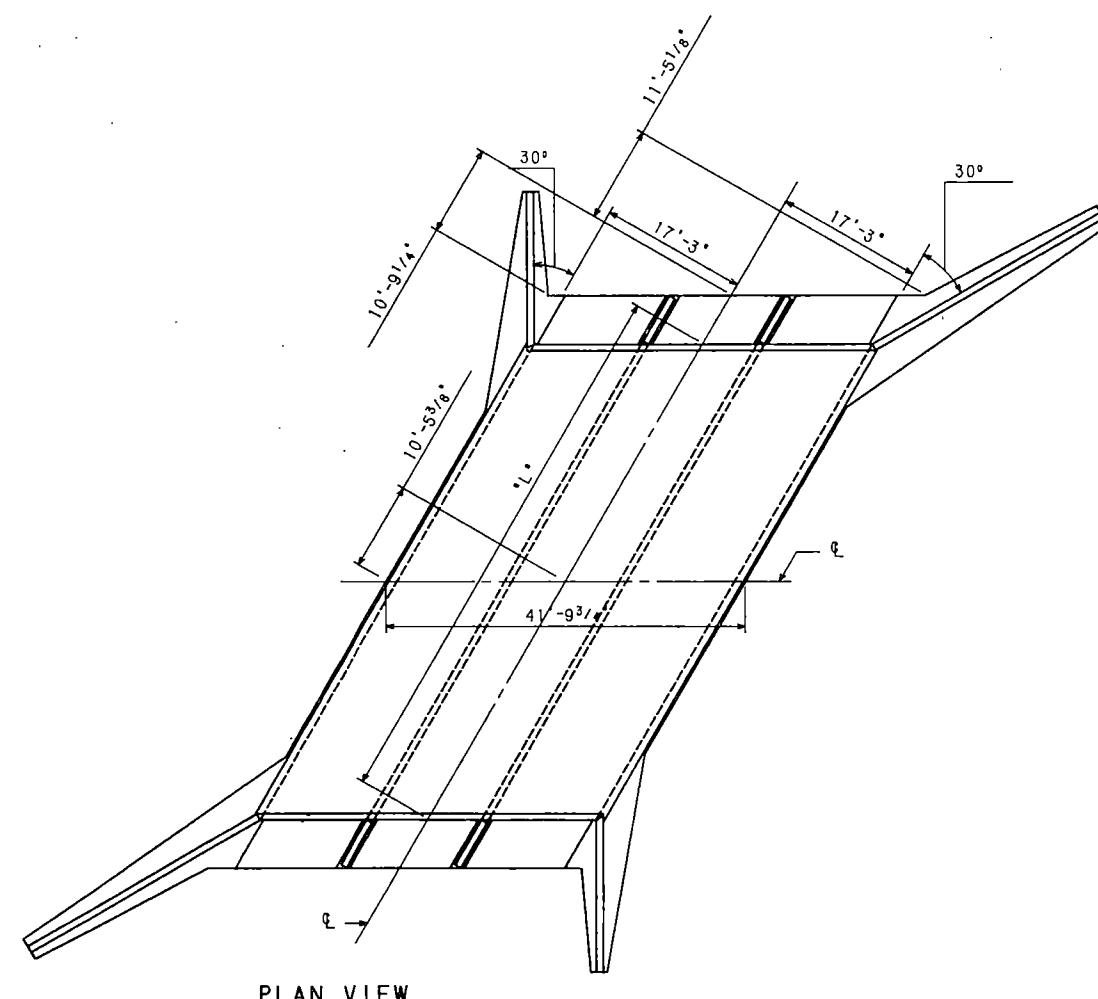

PLAN VIEW

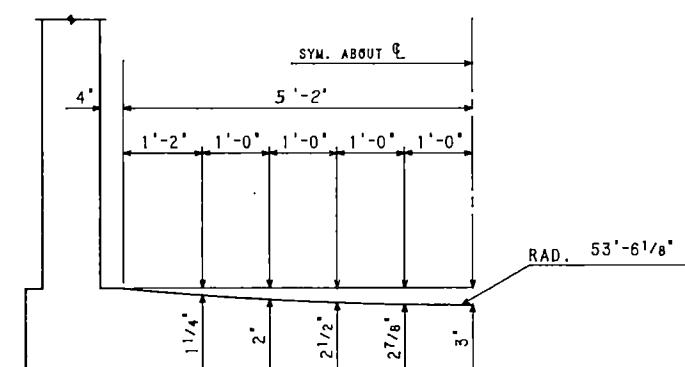

CURVED FLOOR OFF-SETS

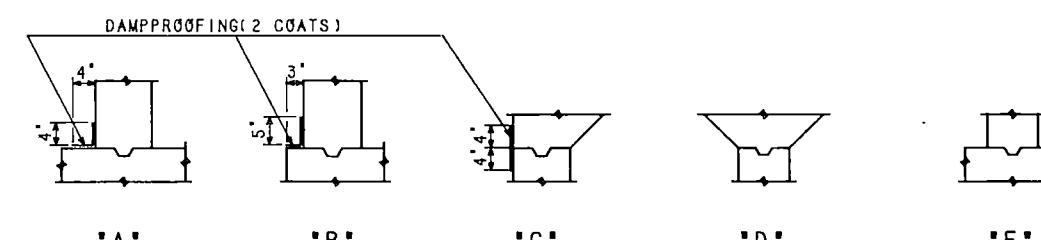

DAMPROOFING & KEY DETAILS
ALL KEYS SHOWN ARE
1 1/2" X 3 1/2"

NORTH DAKOTA
STATE HIGHWAY DEPARTMENT
STANDARD
REINFORCED CONCRETE
TRIPLE BOX CULVERT
SKEWED 30°
CLEAR SPAN 3x11' CLEAR HEIGHT 10'
MAXIMUM FILL 15'



APPROVED 5-10-1976 *Stanley Haas*
BRIDGE ENGINEER

BAR LIST (CONSTANT)									
MARK	SIZE	NO.	LENGTH	SHAPE	MARK	SIZE	NO.	LENGTH	SHAPE
W 1	7	6	4'-10"	BENT	C24	4	2	8'- 5"	BENT
W 2	6	6	11'- 2"	STR.	C25	4	2	8'- 3"	BENT
W 3	7	2	12'-11"	BENT	C26	4	6	6'- 6"	BENT
W 4	7	2	12'- 8"	BENT	H 1	7	8	31'- 9"	STR.
W 5	7	2	12'- 5"	BENT	H 2	4	12	30'- 9"	STR.
W 6	7	2	12'- 2"	BENT	H 3	4	4	27'- 5"	STR.
W 7	7	2	11'-11"	BENT	H 4	4	4	21'- 5"	STR.
W 8	7	2	11'- 8"	BENT	H 5	4	4	15'- 5"	STR.
W 9	7	2	11'- 5"	BENT	H 6	4	4	9'- 6"	STR.
W10	7	2	11'- 2"	BENT	H 7	4	78	6'- 0"	BENT
W11	6	2	10'-10"	BENT	H 8	6	4	12'- 0"	STR.
W12	6	2	10'- 7"	BENT	G 1-021	4	2 SETS	164'- 6"	STR.
W13	6	2	10'- 4"	BENT	W32	7	4	4'-10"	BENT
W14	6	2	10'- 1"	BENT	W33	6	4	11'- 0"	STR.
W15	5	2	9'- 9"	BENT	W34	7	2	12'- 5"	BENT
W16	5	2	9'- 6"	BENT	W35	7	2	11'-11"	BENT
W17	5	2	9'- 3"	BENT	W36	7	2	11'- 4"	BENT
W18	5	2	9'- 0"	BENT	W37	7	2	10'-10"	BENT
W19	4	2	8'- 8"	BENT	W38	6	2	10'- 3"	BENT
W20	4	2	8'- 5"	BENT	W39	6	2	9'- 9"	BENT
W21	4	2	8'- 2"	BENT	W40	5	2	9'- 1"	BENT
W22	4	2	7'-11"	BENT	W41	5	2	8'- 7"	BENT
W23	4	2	7'- 8"	BENT	W42	4	2	8'- 0"	BENT
W24	4	2	7'- 5"	BENT	W43	4	2	7'- 6"	BENT
W25	4	2	7'- 2"	BENT	W44	4	2	6'-11"	BENT
W26	4	2	6'-11"	BENT	W45	4	2	6'- 5"	BENT
W27	4	2	6'- 8"	BENT	W46	4	2	5'-11"	BENT
W28	4	2	6'- 5"	BENT	W47	4	2	5'- 5"	BENT
W29	4	2	6'- 2"	BENT	W48	4	2	4'-10"	BENT
W30	4	2	5'-11"	BENT	W49	4	2	4'- 2"	BENT
W31	4	2	5'- 8"	BENT	C27	6	6	14'- 2"	BENT
C 1	6	8	14'- 4"	BENT	C28	5	8	12'- 2"	BENT
C 2	5	12	12'-10"	BENT	C29	5	2	12'- 8"	BENT
C 3	5	2	13'-10"	BENT	C30	5	2	12'- 2"	BENT
C 4	5	2	13'- 6"	BENT	C31	4	2	11'- 7"	BENT
C 5	5	2	13'- 4"	BENT	C32	4	2	11'- 1"	BENT
C 6	5	2	13'- 0"	BENT	C33	4	2	10'- 7"	BENT
C 7	5	2	12'-10"	BENT	C34	4	2	10'- 1"	BENT
C 8	5	2	12'- 6"	BENT	C35	4	2	9'- 7"	BENT
C 9	4	2	12'- 3"	BENT	C36	4	2	9'- 1"	BENT
C 10	4	2	11'-11"	BENT	C37	4	2	8'- 5"	BENT
C 11	4	2	11'- 9"	BENT	C38	4	2	7'-11"	BENT
C 12	4	2	11'- 5"	BENT	C39	4	2	7'- 5"	BENT
C 13	4	2	11'- 3"	BENT	C40	4	2	6'- 7"	BENT
C 14	4	2	10'-11"	BENT					
C 15	4	2	10'- 9"	BENT	H 9	7	8	19'-11"	STR.
C 16	4	2	10'- 5"	BENT	H10	4	8	17'- 7"	STR.
C 17	4	2	10'- 3"	BENT	H11	4	4	15'-10"	STR.
C 18	4	2	9'-11"	BENT	H12	4	4	12'-11"	STR.
C 19	4	2	9'- 9"	BENT	H13	4	4	10'- 1"	STR.
C 20	4	2	9'- 5"	BENT	H14	4	4	7'- 2"	STR.
C 21	4	2	9'- 3"	BENT	H15	4	4	4'- 4"	STR.
C 22	4	2	8'-11"	BENT	H16	4	78	6'- 0"	BENT
C 23	4	2	8'- 9"	BENT	H17	6	4	7'-10"	STR.

BAR LIST (VARIABLE)

"L"

157'

164'

164'

PER. NO.	STATE	PER. NO.	OWNER	TOTAL LENGTH
8	N.D.	E75-G-20010	13	

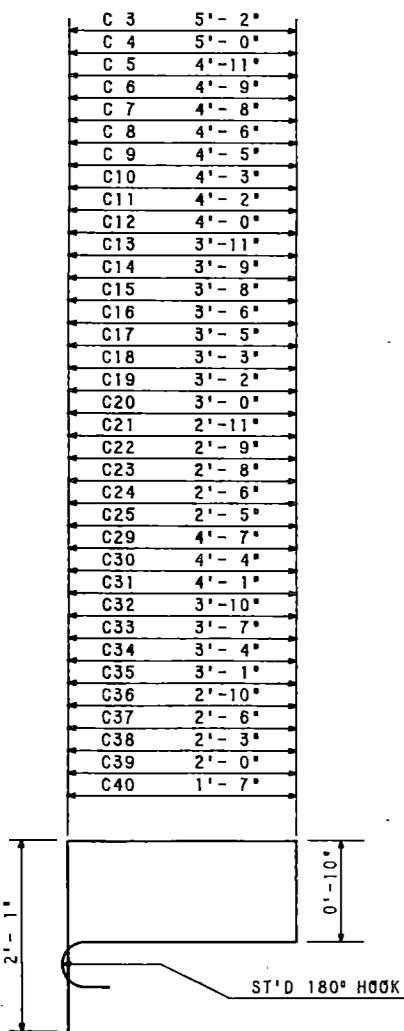

C BARS

W 1	4'- 1"
W 3	12'- 2"
W 4	11'-11"
W 5	11'- 8"
W 6	11'- 5"
W 7	11'- 2"
W 8	10'-11"
W 9	10'- 8"
W10	10'- 5"
W11	10'- 2"
W12	9'-11"
W13	9'- 8"
W14	9'- 5"
W15	9'- 2"
W16	8'-11"
W17	8'- 8"
W18	8'- 5"
W19	8'- 2"
W20	7'-11"
W21	7'- 8"
W22	7'- 5"
W23	7'- 2"
W24	6'-11"
W25	6'- 8"
W26	6'- 5"
W27	6'- 2"
W28	5'-11"
W29	5'- 8"
W30	5'- 5"
W31	5'- 2"
W32	4'- 1"
W34	11'- 8"
W35	11'- 2"
W36	10'- 7"
W37	10'- 1"
W38	9'- 7"
W39	9'- 1"
W40	8'- 6"
W41	8'- 0"
W42	7'- 6"
W43	7'- 0"
W44	6'- 5"
W45	5'-11"
W46	5'- 5"
W47	4'-11"
W48	4'- 4"
W49	3'- 8"


W BARS

ST'D 180° HOOK

MARK	LENGTH 1 SET	BL1	BL2	SPACES
G 1-021	164'- 6"	4'- 1"	11'- 7"	20
G 22-033	82'- 6"	2'- 7"	11'- 2"	11
F 10-F 30	413'- 9"	34'- 7"	4'-10"	20
F 32-F 46	286'-10"	30'- 3"	8'- 0"	14
F 47-F 52	53'- 3"	12'-10"	4'-11"	5
F 78-F 101	431'- 0"	7'-11"	28'- 0"	23
S 6-S22	268'- 4"	28'- 6"	3'- 1"	16
S 23-S43	375'- 4"	33'- 9"	2'- 0"	20
S 44-S64	392'-10"	34'- 7"	2'-10"	20
T 4-T 15	135'- 0"	14'- 0"	8'- 6"	11
T 17-T 28	216'- 0"	20'- 9"	15'- 3"	11
T 29-T 52	287'- 0"	2'- 0"	21'-11"	23

2 SETS SHOWN


BAR CUTTING DETAILS

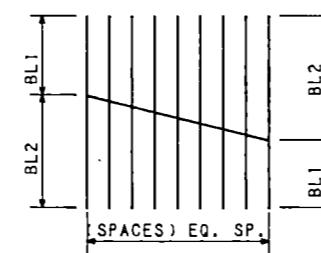


C BARS

C 1	6'- 0"
C 2	5'- 3"
C 27	5'-11"
C 28	4'-11"










C BARS

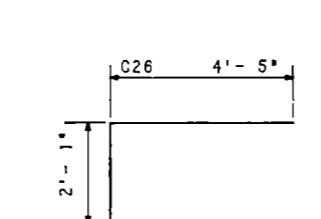

C BARS

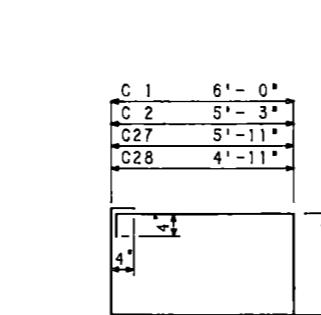

C BARS

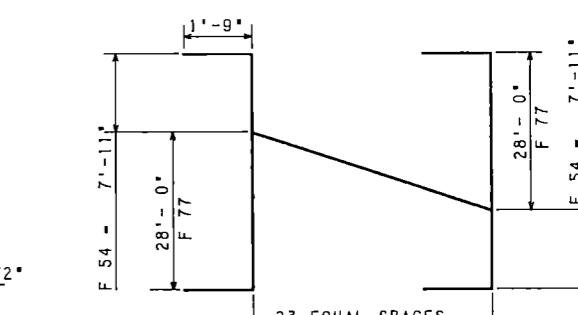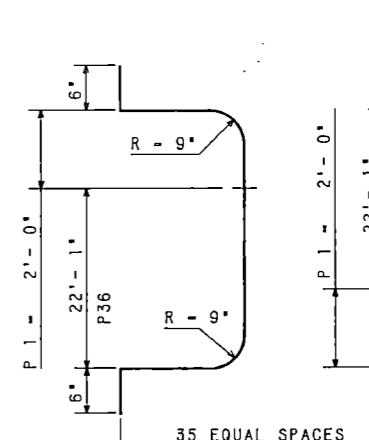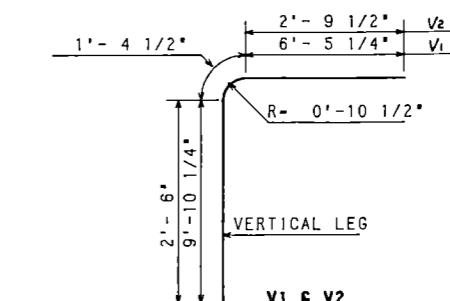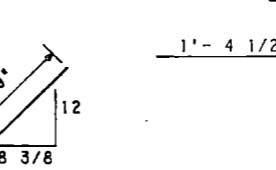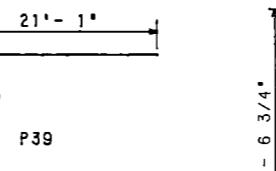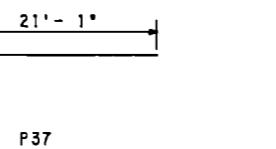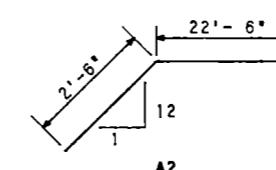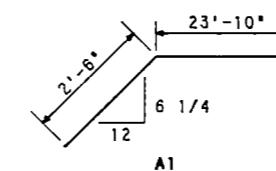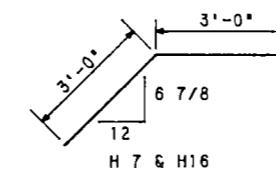


NORTH DAKOTA
STATE HIGHWAY DEPARTMENT
STANDARD
REINFORCED CONCRETE
TRIPLE BOX CULVERT
SKewed 30°
CLEAR SPAN 3x11' CLEAR HEIGHT 10'
MAXIMUM FILL 15'
APPROVED 5-10 1976 *Stanley H. Haas*
BY THE ENGINEER
STANLEY H. HAAS
REGISTERED PROFESSIONAL
ENGINEER
NORTH DAKOTA


SECTION LINE & PRIVATE DRIVE APPROACHES (RURAL)

SHWA REGION	STATE	FED. AID PROJ. NO.	PROJ. NO.
8	N.D.	ROS-6-200 (10)	14

D-203-8

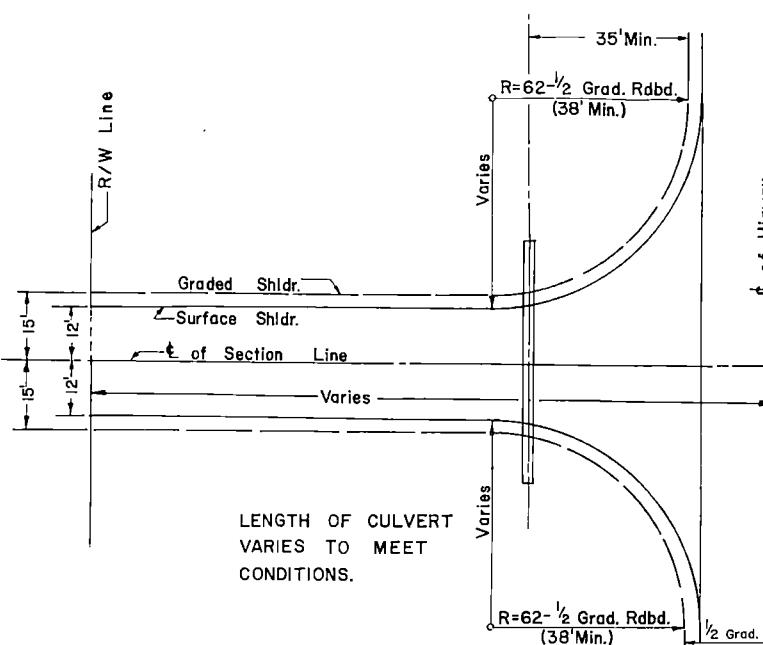

PLAN VIEW SECTION LINE APPROACH (WITHOUT SKEW)

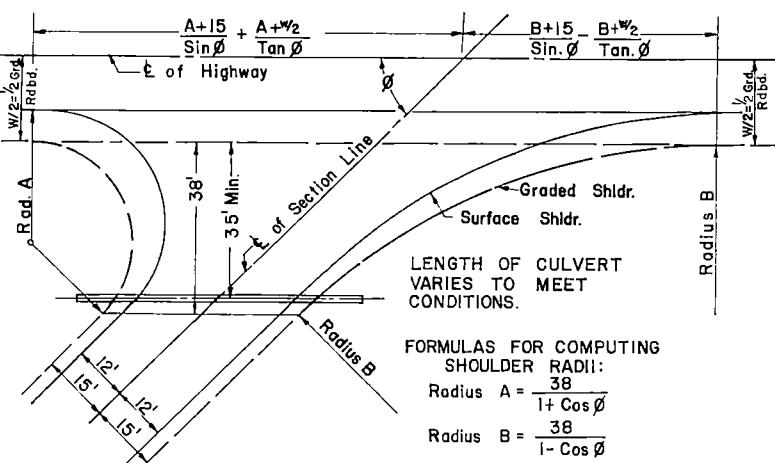


PLAN VIEW SECTION LINE APPROACH (SKEWED)


NOTE:
DIMENSIONS SHOWN FOR SURFACING ARE FOR AGGREGATE SURFACE COURSE OR BITUMINOUS SURFACE CONSTRUCTED WITH GRADING CONTRACT. APPR. GRADES AND TYPICAL SECTIONS APPLY TO BOTH PRIVATE DRIVES AND SECTION LINE APPROACHES.

FOOT NOTES


- ① 10% Max. on Field Drives.
- ② 3:1 Slope - 20' to 30' Fill
2:1 Slope on Fills over 30'
- ③ 15' on Sec. Line Apps.
- ④ 12' on Sec. Line Apps.

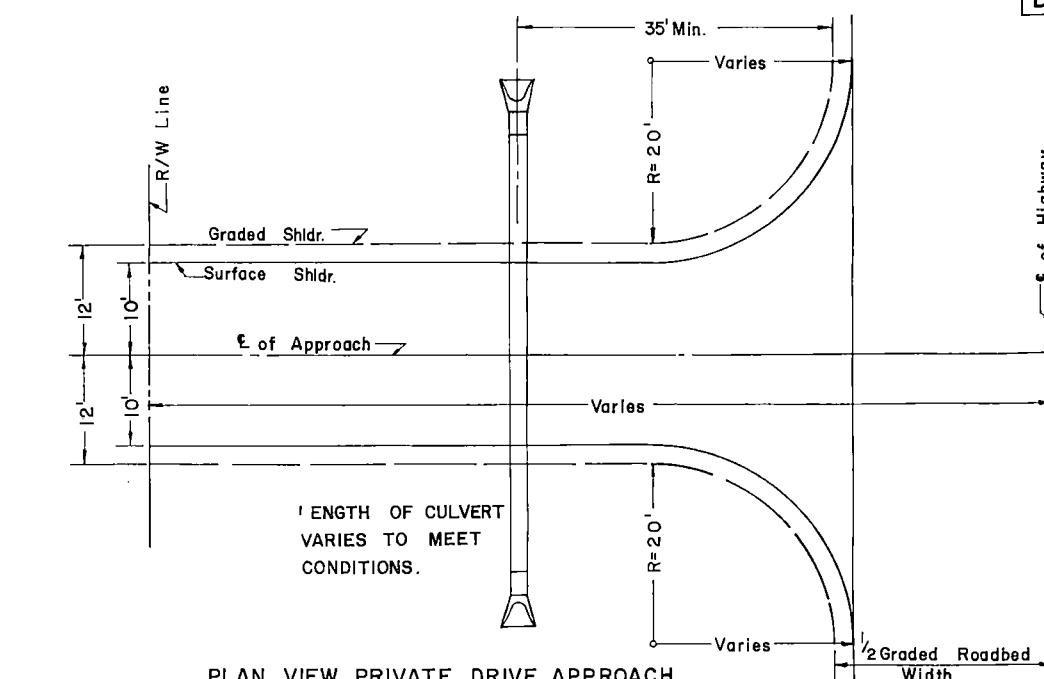


PLAN VIEW PRIVATE DRIVE APPROACH

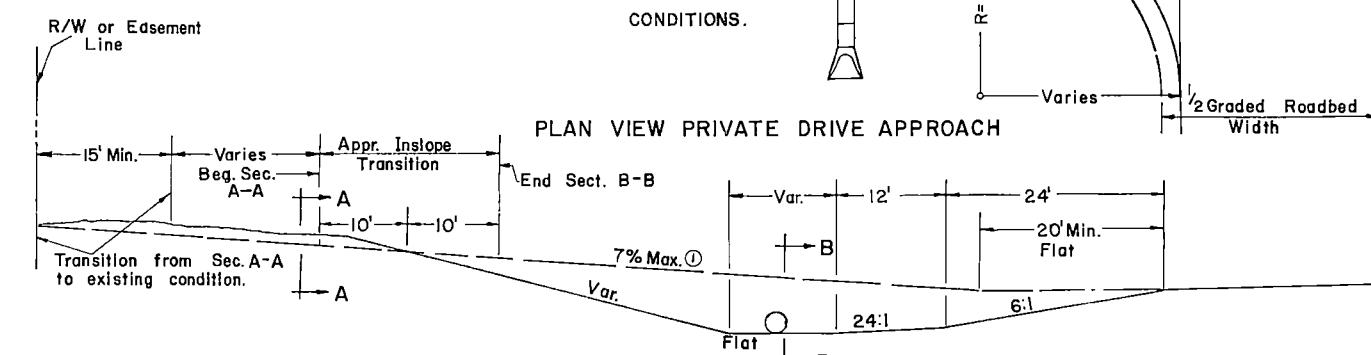



APPROACH GRADE ON CUT SECTION

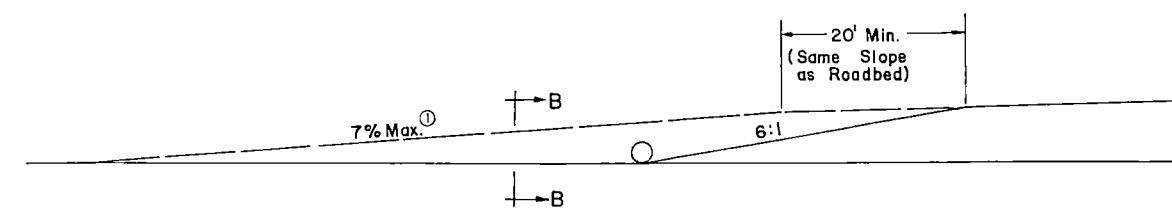


APPROACH GRADE ON FILL SECTION 12 FEET OR LESS

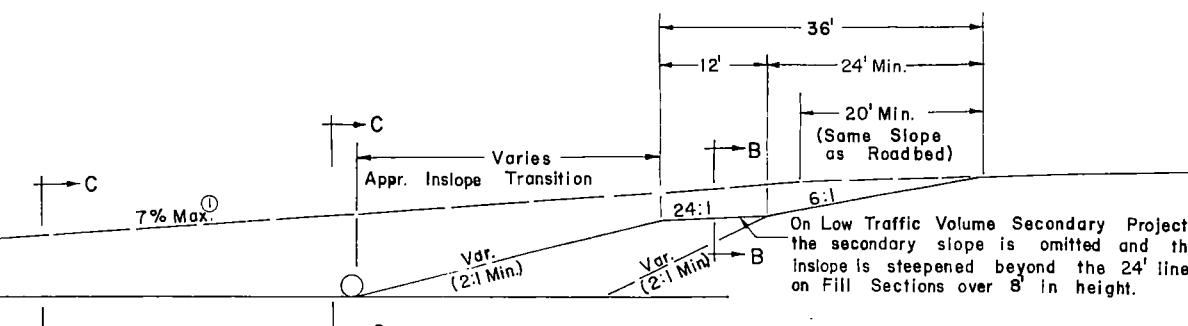

APPROACH GRADE ON FILL SECTION OVER 12 FEET

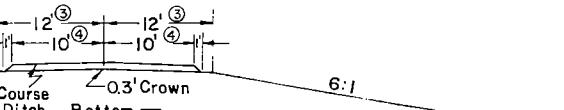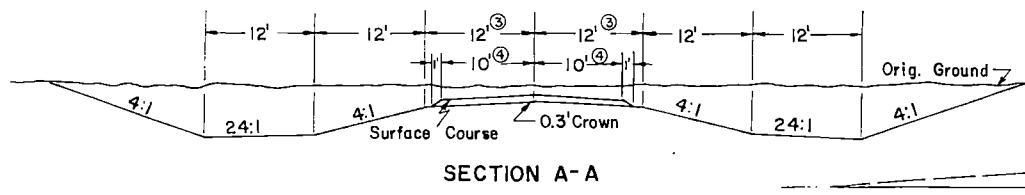


SECTION B-B

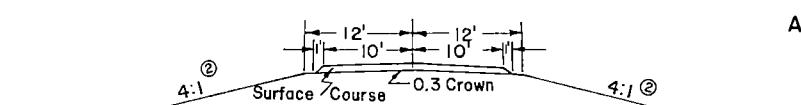


SECTION C-C

1-1-75		REVISIONS	DATE	CHANGE
NORTH DAKOTA STATE HIGHWAY DEPARTMENT				
Submitted:	John Doe			Design Engineer
Recommended:				Asst. Chief Engineer Pre-Construction
Approved:	John Doe			Chief Engineer

FED. ROAD DIV. NO.	STATE	FED. AID PROJ. NO.	HEET NO.
5	N.D.	F-6-200 (05)	1

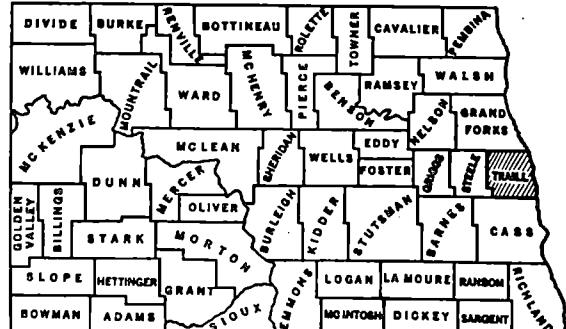

SKETCH-MAP OF NORTH DAKOTA
SHOWING COUNTIES

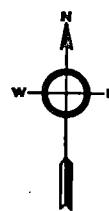

NORTH DAKOTA STATE HIGHWAY DEPARTMENT

PLANS

FOR THE PROPOSED IMPROVEMENT OF A

STATE HIGHWAY

IN TRAILL COUNTY

FEDERAL AID PROJECT NO. F-6-200(05) 389 OR F-5(19)
GRADE, BIT. BASE, & STRUCTURE

SCALES

LAYOUT SHEET: 1 IN. = 2000 FT.
PLAN AND PROFILE DRAWINGS (VERT. 1 IN. = 10 FT.
STRUCTURAL DRAWINGS: AS SHOWN
CROSS SECTION SHEETS: 1 IN. = 10 FT.

LENGTH OF PROJECT		
PROJECT	MILES-GROSS	MILES-NET
F-6-200(05)	0.255	0.255
TOTALS	0.255	0.255

Install Construction Identification Signs:
Sta. 252+00 Rt. 8 265+50 Lt.

GOVERNING SPECIFICATIONS:

Standard Specifications adopted by the North Dakota State Highway department Jan. 1965 and approved as standard by the Fed. Hwy. Admin. June 23, 1965. Required Contract Provision (Form PR-273) dated Oct. 1969 and others submitted herewith.



DESIGN DATA

TRAFFIC AVERAGE DAILY EST. 30TH MAX. HR.

CURRENT TRAFFIC (1971) 935 PASS. 165 TRUCKS 1100 TOTAL 145
TRAFFIC FORECAST (1991) 1400 PASS. 250 TRUCKS 1650 TOTAL 215

DESIGN SPEED 70 MPH
TRAFFIC CLASSIFICATION "M"
MINIMUM SIGHT DISTANCE (STOPPING) 600'
MINIMUM SIGHT DISTANCE (SAFE PASSING) 3200'
MINIMUM PASSING SIGHT DISTANCE FOR MARKING 1200'
R.C. BOX CULVERT-DESIGN LOADING-HS20-44

200 28

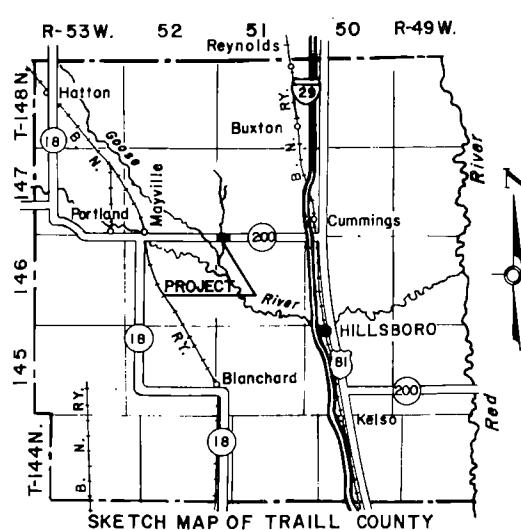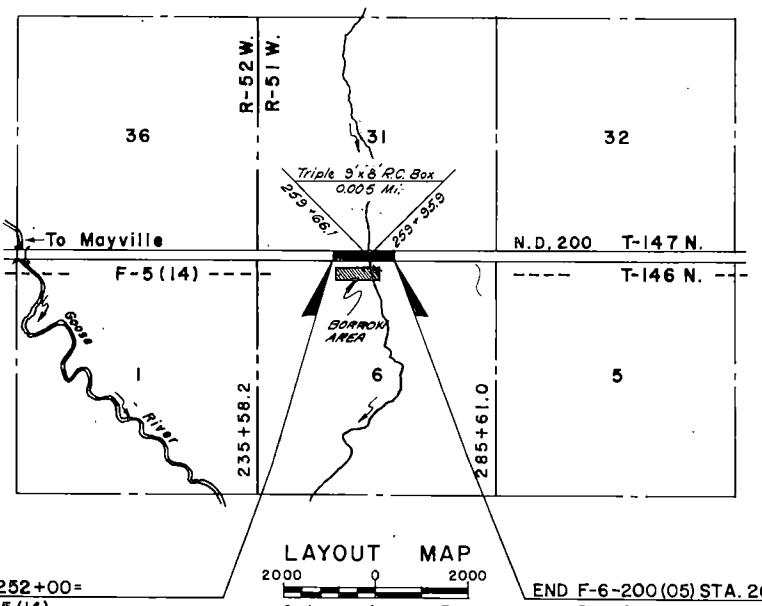

APPROVED	DATE 2-4-71
<i>Rehney</i>	
CHIEF ENGINEER NORTH DAKOTA STATE HIGHWAY DEPARTMENT	

U.S. DEPARTMENT OF TRANSPORTATION FEDERAL HIGHWAY ADMINISTRATION	
APPROVED	DATE
DIVISION ENGINEER	

F-6-200(05)389

SYMBOLS

STATE & NATIONAL LINES	— — — —	BUILDINGS	☒
COUNTY LINE	— — — —	TELEGRAPH LINES	○ ○ ○ ○ ○
TOWNSHIP & RANGE LINES	— — — —	TELEPHONE LINES	● ● ● ● ●
SECTION LINE	— — — —	POWER LINES	— — — —
QUARTER SECTION LINE	— — — —	CULVERTS (in Place)	██████████
SECTION CORNER	○ ○	CULVERTS (Install)	██████████
QUARTER SECTION CORNER	○ ○	CONCRETE BOX CULVERTS (Install)	██████████
OLD RIGHT OF WAY LINE	— — — —	BRIDGES (Install)	██████████
NEW RIGHT OF WAY LINE	— — — —	CONCRETE CURB	— — — —
GRADE LINE	— — — —	CONCRETE CURB AND GUTTER	— — — —
CENTERLINE OF CONSTRUCTION	— 500 —	CONCRETE WALK	— — — —
RAILROAD RIGHT OF WAY LINE	— — — —	CATCH BASIN (Existing)	○ ○ ○ ○ ○
CITY OR VILLAGE CORPORATE LIMITS	██████████	CATCH BASIN (New)	○ ○ ○ ○ ○
PROPERTY LINE	— — — —	MANHOLE (Existing)	○ ○ ○ ○ ○
EASEMENT LINE	— — — —	MANHOLE (New)	○ ○ ○ ○ ○
FENCES	× × × ×	CURB INLET (Existing)	██████████
SNOW FENCE	████████████████	CURB INLET (New)	██████████
DRAINAGE	~~~~~	GROUND MOUNTED SIGNS	— — — —
WATERS EDGE	~~~~~	OVERHEAD SIGNS	— — — —
MARSH OR SWAMP	● ● ● ● ●	HYDRANT	○ ○
RIPRAP	████████████████	LIGHT STANDARDS	○ ○ ○ ○ ○
DRAINAGE DITCH	— — — —	TRAFFIC SIGNALS (Plan & Profile Sheets)	8
APPROACH	— — — —	TRAFFIC SIGNALS (Lighting Plan Sheets)	(R) (G)
TRAVELED WAY	— — — —	GROUND ELEVATION	6430
RAILROADS	— — — —	GRADE	245
GUARD RAIL	● ● ● ● ●	CENTERLINE	— — — —
GUIDE POSTS	● ● ● ● ●	SECTION LINE	— — — —
DELINATEATORS	— — — —	DEFLECTION ANGLE (Delta)	△
HEDGES AND TREES	████████████████	SOD OR JUTE MESH	██████████
INTERCHANGE	— — — —		
HIGHWAY GRADE SEPARATION- NO CONNECTION	— — — —		
OTHER BRIDGE	— — — —		
SERVICE ROAD	— — — —		
TERMINATED CROSS-ROAD	— — — —		
RAILROAD GRADE SEPARATION	△		

ABBREVIATIONS

Aggr.	Aggregate	M. L.	Main Line
Ahd.	Ahead	N. R.	North Roadway
Alt.	Alternate	Off. Loc.	Office Location
Approx.	Approximate or Approximately	O. to O.	Out to Out
Appr.	Approach	P. B. P.	Plan and Profile
Asph. Cem. or A.C.	Asphalt Cement	P. C.	Point of Curvature
Asph. Conc.	Asphaltic Concrete	P.C.C.	Point of Compound Curve
Bit.	Bituminous or Bitumen	P.C.C. Pvm'	Portland Cement Concrete Pavement
Bk.	Bock	P. D.	Private Drive
B. M.	Bench Mark	Pen.	Penetration
Bldg.	Building	Perf.	Perforated
Br.	Bridge	P. I.	Point of Intersection
C.A.E.S.	Corrugated Aluminum End Section	P. O. C.	Point on Curve
C.A.P.	Corrugated Aluminum Pipe	P. O. T.	Point on Tangent
C. B.	Ditch Basin	P. P.	Power Pole
C. & G.	Curb and Gutter	P. R. C.	Point of Reverse Curvature
Ch. Blk.	Channel Block	Pref.	Preformed
Ch. Ch.	Channel Change	P. S. D.	Passing Sight Distance
C. I.	Curb Inlet	P. T.	Point of Tangency
C.I.P.	Cast Iron Pipe	P.V.C.	Polyvinyl Chloride Sewer Pipe
Cl.	Class	Quan.	Quantity or Quantities
C.M.E.S.	Corrugated Metal End Section	R	Radius
C.M.P.	Corrugated Metal Pipe	R or Rge.	Range
CMS	Cationic Medium Setting	R.C.E.S.	Rapid Curing
Comp.	Compression	R.C.P.	Reinforced Concrete End Section
Const.	Construction	R.C.P.S.	Reinforced Concrete Pipe
Conc.	Concrete	Rd.	Reinforced Concrete Pipe Sewer
Cont. Reinf. Conc.	Continuously Reinforced Concrete	Rdbd.	Road
Pvm'	Pavement	Rdwy.	Roadbed
Contn.	Contraction	Refl.	Roadway
Crn.	Crown	R. R.	Reflectorized
CRS	Cationic Rapid Setting	Rt.	Railroad
Crs.	Course	R/W	Right
C. S.	Curve to Spiral	Salv.	Right of Way
C. to C.	Center to Center	San.	Salvage
C.Y.	Cubic Yard	S.C.	Sanitary
D	Degree of Curvature	SC	Spiral to Curve
D-Load	Dead Load	Sc	Slow Curing
D. B.	Ditch Block	S.S.D.	Spiral Deflection Angle
Def.	Deformed	S.D.	Sight Distance
Del.	Deliver	S.E.	Superelevation
D.G.	Ditch Grade	Sec.	Section
El. or Elev.	Elevation	Sec. Line Appr. Section Line Approach	
Ellipt.	Elliptical	Sep.	Separation
Emb.	Embankment	Serv.	Service
Emul.	Emulsified	Sgr. Prep.	Subgrade Preparation
Engr.	Engineer	Shdr.	Shoulder
Eq.	Equation	SP	Special Provision
E. R.	East Roadway	S.P.P.	Structural Plate Pipe
E. S.	End Section	S.R.	Structural Plate Pipe Arch
Esmt.	Easement	SS	South Roadway
Exc.	Excavation	S.S.D.	Slow Setting or Supplement Specification
Exp.	Expansion	S.T.	Stopping Sight Distance
F. D.	Field Drive	Sta.	Spiral to Tangent
Found.	Foundation	Std.	Station
F. P.	Fence Post	Std. Specs.	Standard
Furn.	Furnish	Struct.	Standard Specifications
Go.	Gage or Gauge	Surf.	Structure
Gr.	Gravel	Surv.	Surface or Surfacing
Grd.	Graded	S.W.	Survey
G.V.	Gate Valve	S.Y.	Sidewalk
Hel.	Helical	T.	Square Yard
Hyd.	Hydrant	T or Twp.	Tangent Length (circular curve)
Ident.	Identification	Tel.	Township
Inchq.	Interchange	Temp.	Telephone
I. M.	Iron Monument	T.P.	Temporary
Inst.	Install	Tr.	Telephone Pole
Inter.	Intersection	Trans.	Traffic
Inv.	Invert	Trd.	Transverse or Transition
Jt.	Joint	Ts	Treated
L	Length of Curve	T.S.	Tangent Length (curve with spirals)
Lc	Length of Spiral	U.S.C. & G.S.	Tangent to Spiral
Levg.	Leveling	United States Coast and Geodetic Survey	
L. F.	Linear or Lineal Foot	V.C.	Vertical Curve
Liq.	Liquid	V.C.P.	Vitrified Clay Pipe
Long	Longitudinal	W.M.	Water Main
L. P.	Light Pole	W.M.V.	Water Main Valve
Lt.	Left	W. R.	West Roadway
"M"	One Thousand	Wrng.	Wearing
Matt.	Material	W.S.V.	Water Service Valve
Max.	Maximum	X-Sec.	Cross Section
MC	Medium Curing	Xc	Spiral Coordinate
M. H.	Manhole	Yc	Spiral Coordinate
Min.	Minimum		

FED. A.D.	STATE	F.D. A.D.	PROJECT NO.	SHEET NO.	TOTAL SHEETS
DIV. NO.					
5	N.D.	F-6	200103	5	

FINAL SURVEY SURVEYED PLOTTED

NOTE BOOK NO.

AREAS CHECKED

BY DATE

BY

DATE


ORIGINAL SURVEY SURVEYED PLOTTED

NOTE BOOK NO.

AREAS CHECKED

BY

DATE

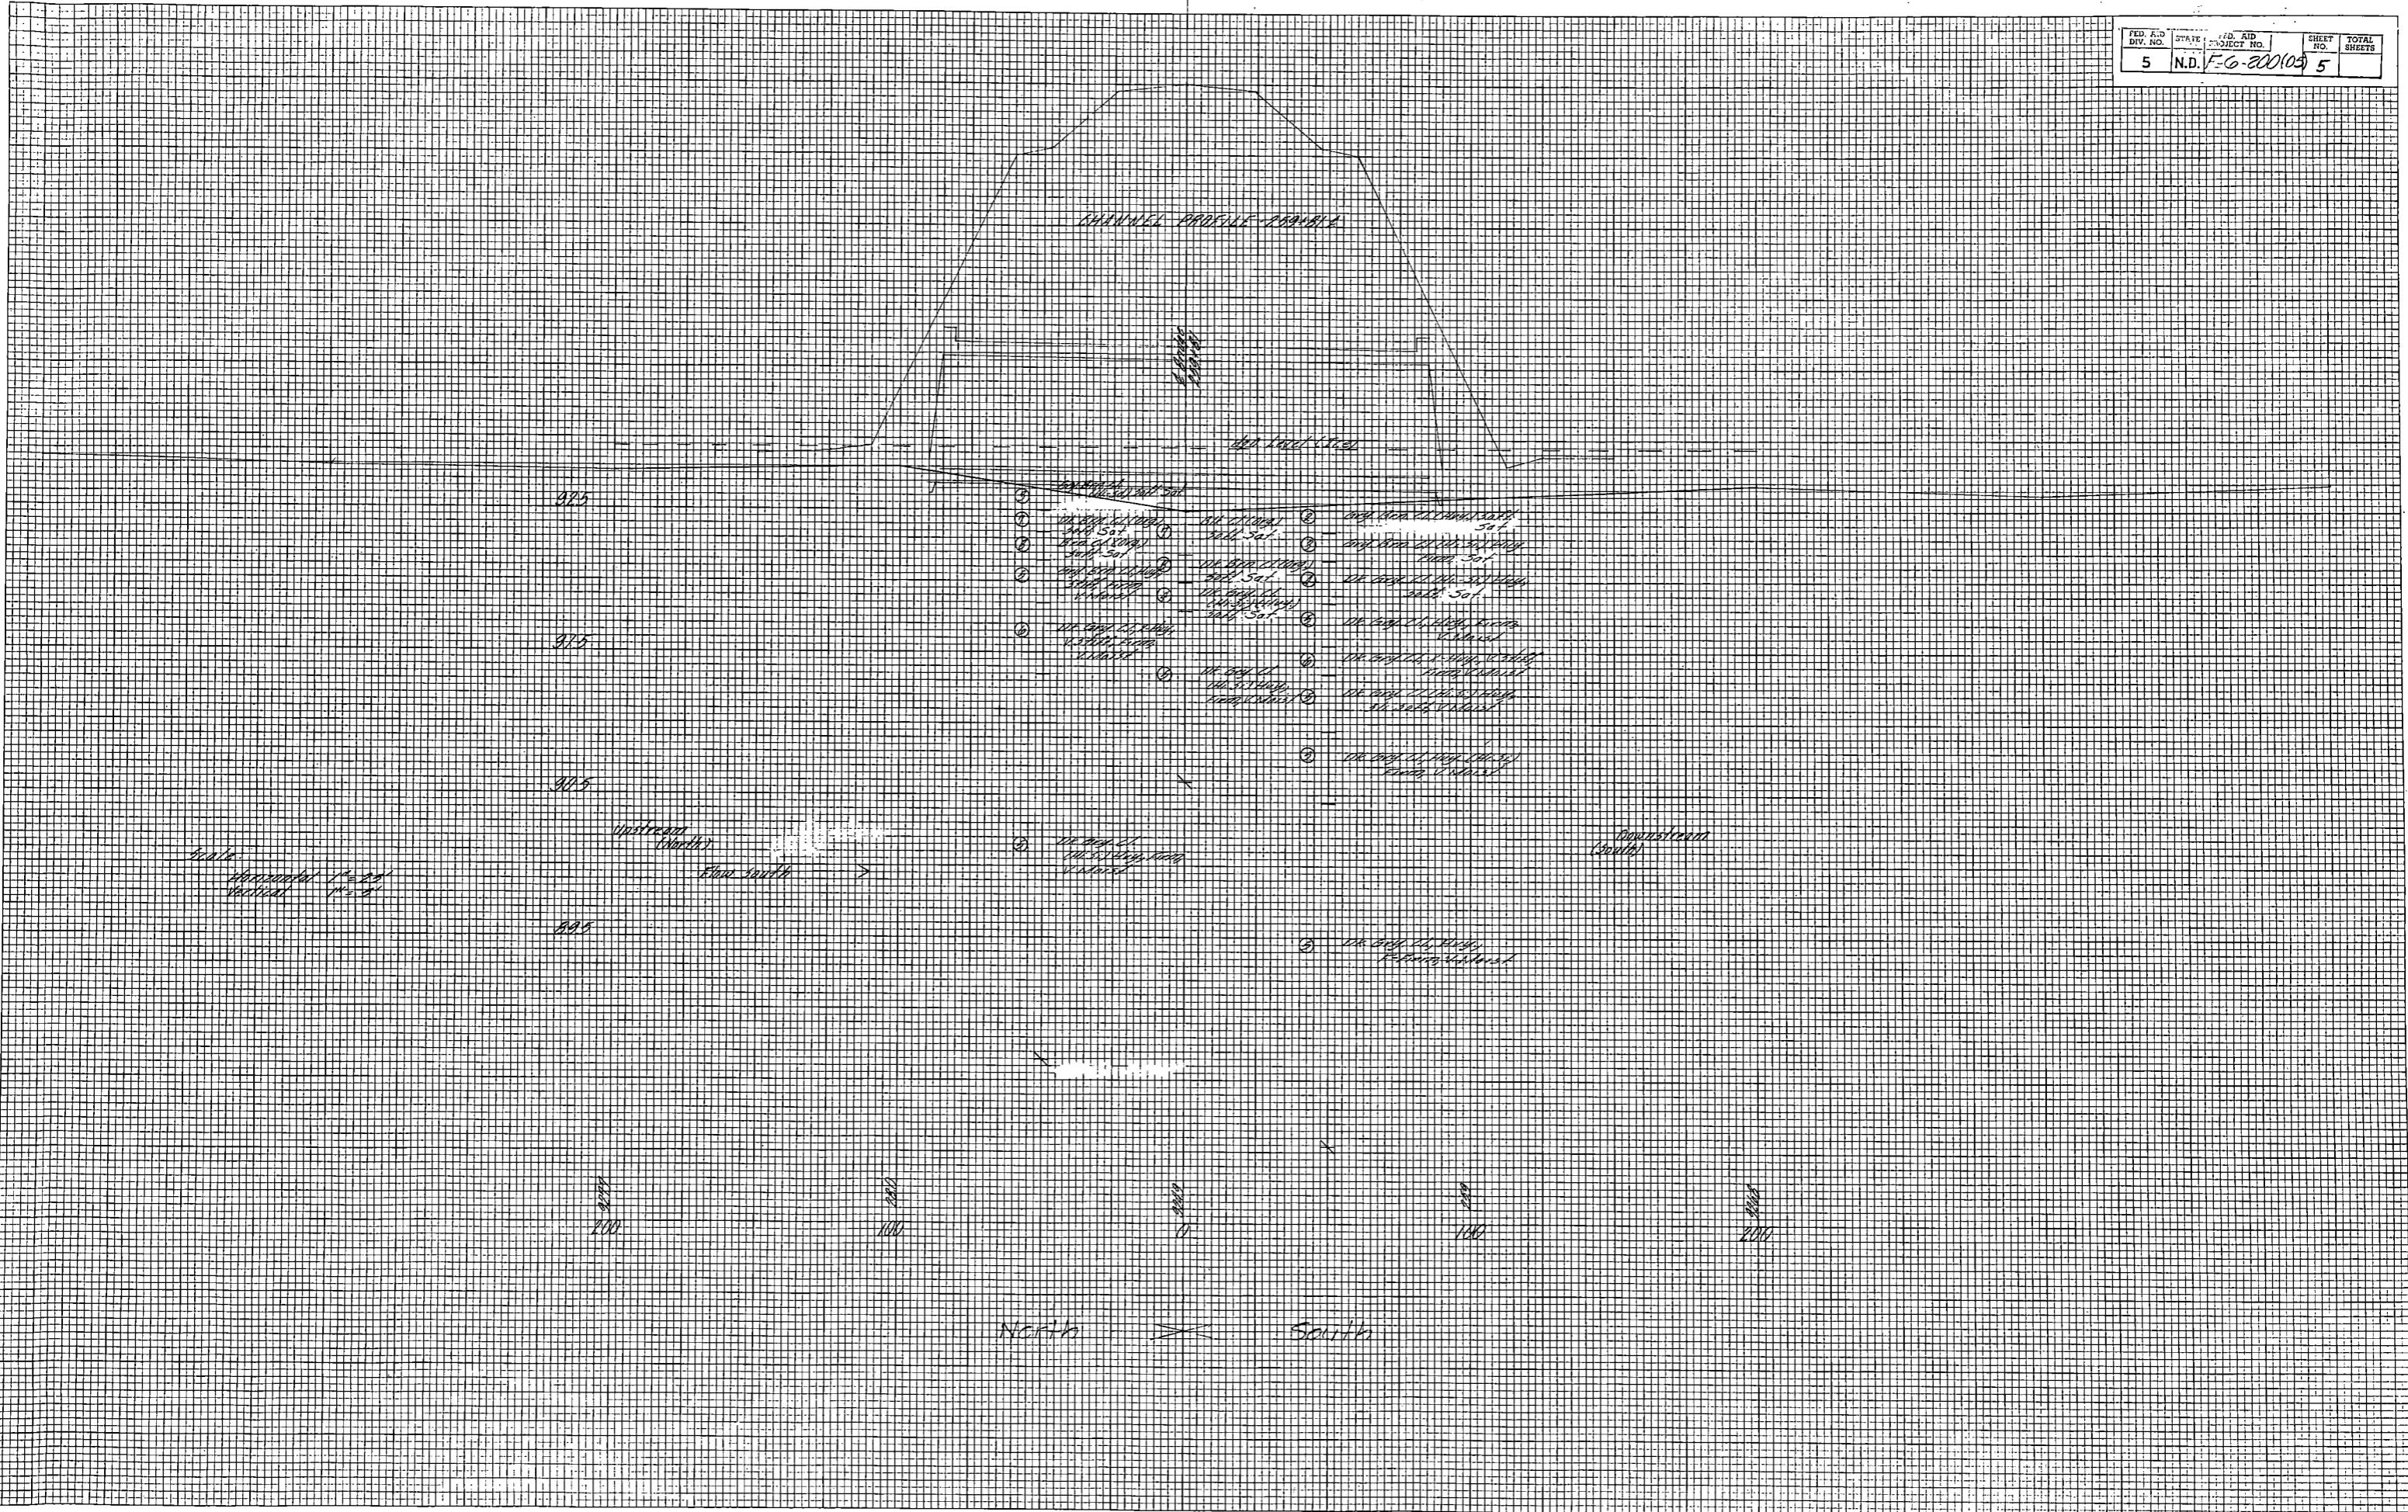

BAR LIST (CONSTANT)			
MARK	SIZE	LENGTH	SHAPE
A1	8	6	Bent
A2	4	6	11'-9"
A3	16	4	22'-9"
A4	8	4	15'-0"
F5	24	5	32'-0" Str.
F6	28	5	12'-0" "
F7	28	6	5'-8" "
H1	24	4	17'-9" Str.
H2	8	4	13'-8" "
H3	8	4	9'-8" "
H4	16	7	18'-9" "
H5	8	6	9'-0" "
H6	120	5	6'-0" Bent
O1-06	85sets	4	37'-0" Str.
O7	4	4	9'-6" "
P1	8	6	18'-0" Bent
P2	60	4	3'-10" "
P3	8	6	9'-6" Str.
P4	8	6	5'-0" Bent
P5	42	4	8'-1" "
T2	58	4	6'-4" Str.
T3	12	4	4'-9" "
T8	12	4	3'-5" "
V6	8	4	2'-9" Str.
V7	8	4	4'-0" "
V8	8	4	5'-0" "
V9	8	4	6'-0" "
W1-W9	12sets	4	33'-0" Bent
W6-W8	12sets	5	29'-7" "
W9	24	5	4'-1" "
G-C18	4sets	4	17'-8" Bent
G19	24	4	11'-9" "
Total = 6717#			
*S46	1	4	3'-8" Str.
*S48	1	5	4'-0" "
*S46	1	6	4'-6" "
*S47	1	7	5'-0" "

* Sample replacement bar to be spliced to bar from which a 6' sample has been cut. (Non Pay Item)

Total Length One Set W1-W9 = 33'-0"
Total Length One Set W6-W8 = 29'-7"

W1 - W9

BAR BENDING & CUTTING DETAILS

QUANTITIES MADE BY C.F.S.


CONCRETE FORMULAS

Entire Floor	= "L" x 1.1053 + 31.50 CU.YD.
Inner Walls	= "L" x 0.3704 + 2.24 CU.YD.
O.S. Walls	= "L" x 0.4282 + 12.15 CU.YD.
Entire Roof	= "L" x 1.1234 + 1.76 CU.YD.
Total	= "L" x 3.1273 + 47.65 CU.YD.

DAMPROOFING FORMULA

Total	= "L" x 0.296 + 5.3 SQ.YD.
-------	----------------------------

5 5 N.D. F-6-2000(08)06 6

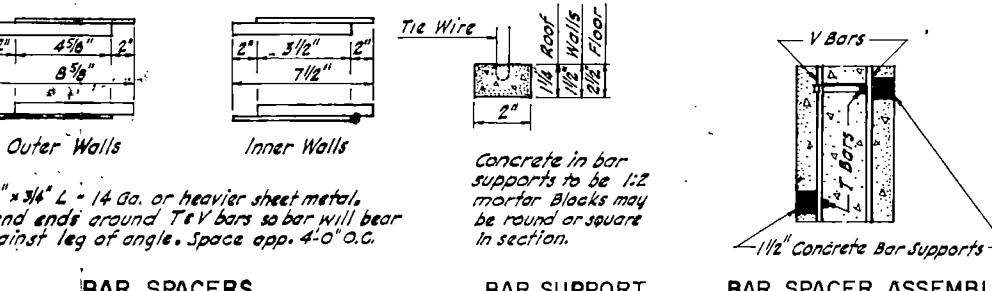


BAR SPACERS

BAR SUPPORT

BAR SPACER ASSEMBLY

BAR SUPPORT DETAILS

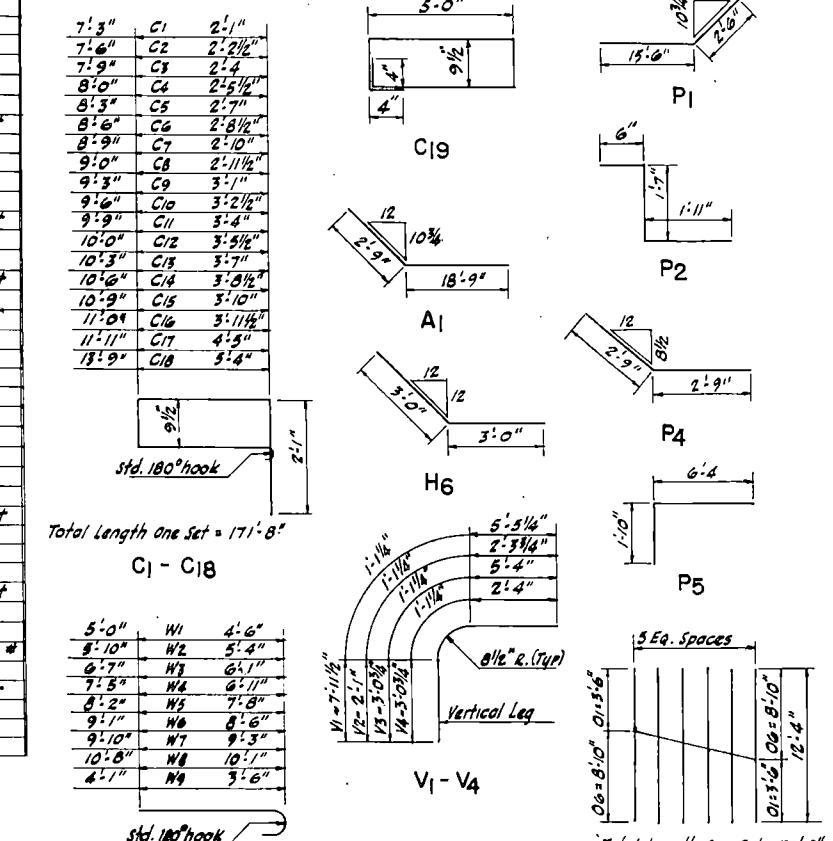

Total Length one set = 171'-8"

C1 - C18



Total Length One Set W1-W9 = 33'-0"
Total Length One Set W6-W8 = 29'-7"

W1 - W9

BAR LIST (VARIABLE)			
"L"		171'	
MARK	SIZE	SHAPE	LENGTH
F1	6	Str.	30'-0" 207
F2	5	"	10'-8" 408
F3	6	"	19'-9" 207
F4	6	"	5'-8" 408
S1	5	Str.	29'-0" 411
S2	6	"	19'-9" 207
S3	6	"	5'-8" 408
V1	5	Bent	14'-6" 414
V2	5	"	5'-6" 408
V3	5	"	9'-6" 414
V4	5	"	6'-6" 408
V5	4	Str.	8'-4" 1044
TIA	4	Str.	405 30'
TIB	4	Str.	405 28'

+ Substitute TIA & TIB in lieu of Ti bars in standard.

CONTRACTION JOINT

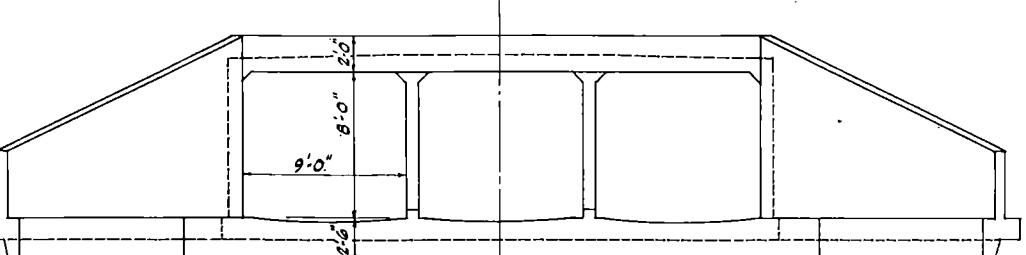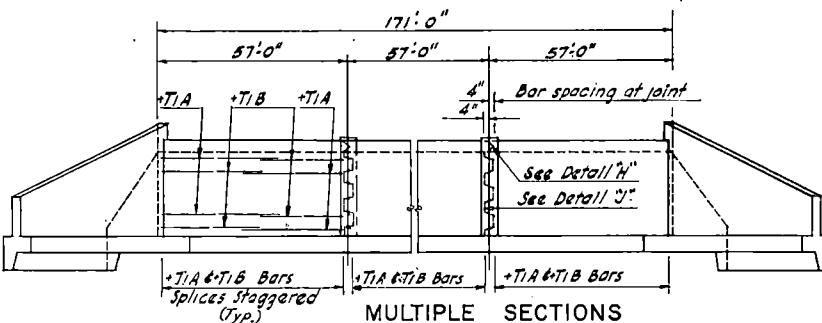

SHEET 1 OF 2

CONSTRUCTION NOTES

REINFORCEMENT:

THE CONTRACTOR SHALL VERIFY THE QUANTITY, SIZE AND SHAPE OF THE BAR REINFORCEMENT AGAINST THE DRAWINGS AND INFORM THE ENGINEER OF DISCREPANCIES BEFORE ORDERING REINFORCING BARS.

THE TRANSVERSE AND VERTICAL BARS SHALL ALWAYS BE PLACED NEAREST THE SURFACE. THE LONGITUDINAL, TEMPERATURE OR TIE BARS SHALL BE PLACED IMMEDIATELY INSIDE OF THE VERTICAL AND TRANSVERSE BARS AND THE INTERSECTIONS WIRED.

WHEN THE DISTANCE BETWEEN END BARS IS NOT EVENLY DIVISIBLE BY BAR SPACING, THE ODD DISTANCE SHOULD BE ADJUSTED BY A FEW IRREGULAR SPACES NEAR THE CENTER, NOT AT THE ENDS OF THE CULVERT OR SECTION OF CULVERT.

THE CLEAR DISTANCE FROM THE NEAREST BAR TO THE SURFACE OF THE CONCRETE SHALL BE AS FOLLOWS:

BOTTOM OF WING FOOTING	24" CLEAR
BOTTOM OF FLOOR SLAB	23" CLEAR
TOP OF FLOOR SLAB	2" CLEAR
TOP OF WING FOOTING	24" CLEAR
ALL WALLS	14" CLEAR
TOP OF ROOF SLAB (AND BOTTOM)	11" CLEAR

DIMENSIONS FOR BENT BARS ARE GIVEN OUT TO OUT. ALL BENDS ARE TO MEET ACI STANDARDS UNLESS OTHERWISE NOTED.

CONCRETE:

ALL CONCRETE SHALL BE CLASS AE-3 AND SHALL BE COMPAKTED BY VIBRATION.

THE FOLLOWING ELEMENTS OF EACH SECTION SHALL BE POURED IN ONE CONTINUOUS RUN:

1. FLOOR SLAB AND WING FOOTINGS
2. EACH INTERMEDIATE WALL UP TO BOTTOM OF FILLETS
3. EACH SIDEWALL UP TO BOTTOM OF FILLETS WITH ITS ADJACENT WINGS COMPLETE TO TOP
4. ROOF SLAB AND PARAPETS

ALL EXPOSED EDGES OF CONCRETE SHALL BE BEVELED WITH 3/4" TRIANGULAR MOLDING.

THE CONCRETE IN THE WALLS SHALL BE ALLOWED TO SET AT LEAST TWO (2) HOURS BEFORE THE ROOF SLAB IS POURED.

FOUNDATION FILL:

UNSUITABLE FOUNDATION MATERIAL SHALL BE REMOVED AND REPLACED WITH SUITABLE BACKFILL. THIS BACKFILL WILL BE PAID FOR AT THE CONTRACT PRICE BID FOR "FOUNDATION FILL".

DAMPROOFING:




TWO COATS OF DAMPROOFING SHALL BE APPLIED OVER THE ENTIRE LENGTH OF THE CONSTRUCTION JOINTS AT THE TOP AND BOTTOM OF WALLS (OUTSIDE SURFACES ONLY) AS SHOWN ON THE DETAILS. "DAMPROOFING TWO COATS" WILL BE APPLIED, MEASURED, AND PAID FOR IN ACCORDANCE WITH SECTION 736 OF THE STANDARD SPECIFICATIONS.

DESIGN LOADING HS20-44 SERIES OF 1951


QUANTITIES FOR ONE CULVERT

LENGTH "L"	CONCRETE FEET	REINF. STEEL CU.YD.	DAMPROOFING FEET	CONCRETE 2 COATS SO.YD.	REINF. STEEL 2 COATS SO.YD.	DAMPROOFING 2 COATS SO.YD.
171	582.4	89.207	56			


 NORTH DAKOTA STATE HIGHWAY DEPARTMENT STANDARD REINFORCED CONCRETE TRIPLE BOX CULVERT CLEAR SPAN 3x9' CLEAR HEIGHT 8' MAXIMUM FILL 20'	APPROVED	10/10/2000
	200 - 389.78-1	200 - 389.78-1

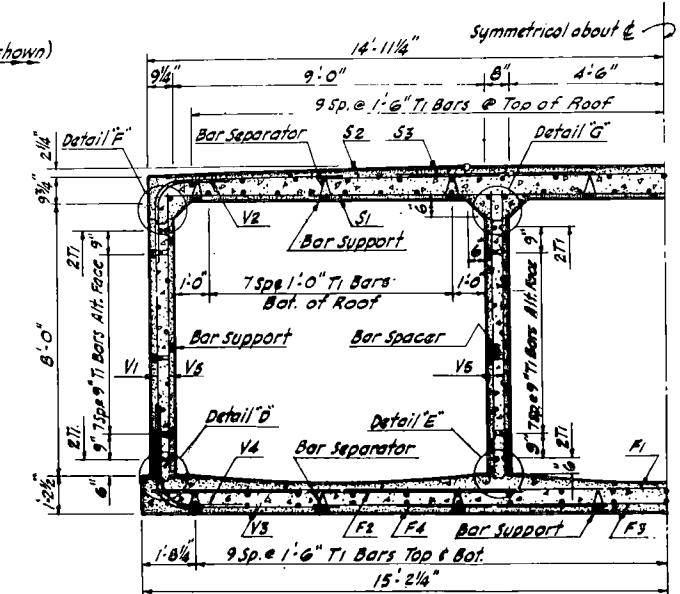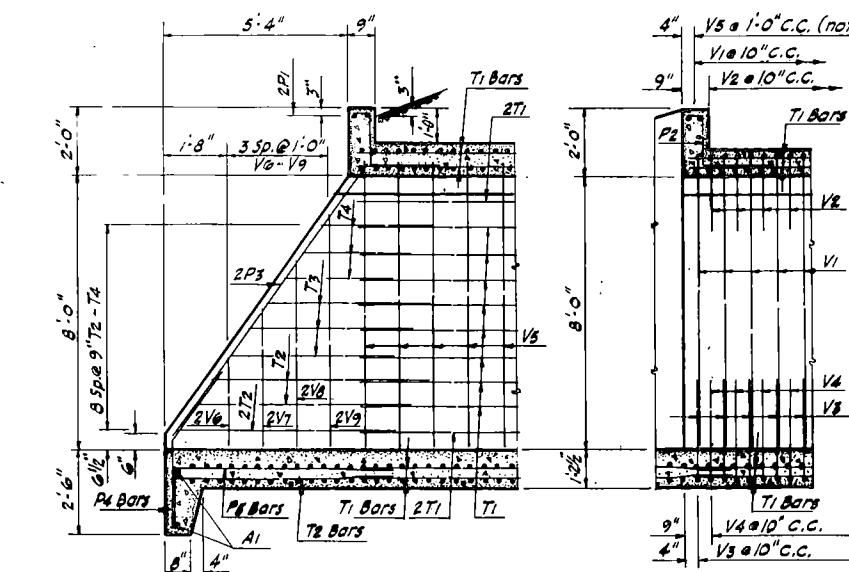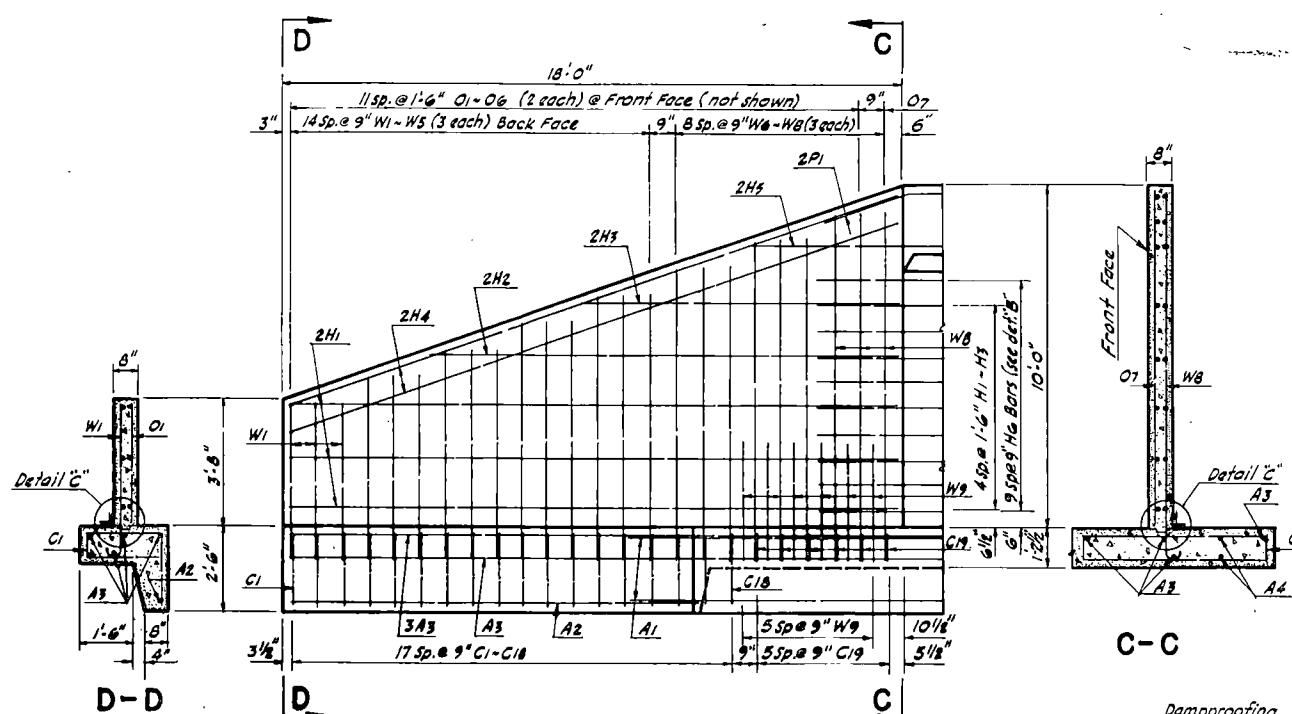


**HALF SECTION OF BARREL
135 Ti BARS/SECTION**

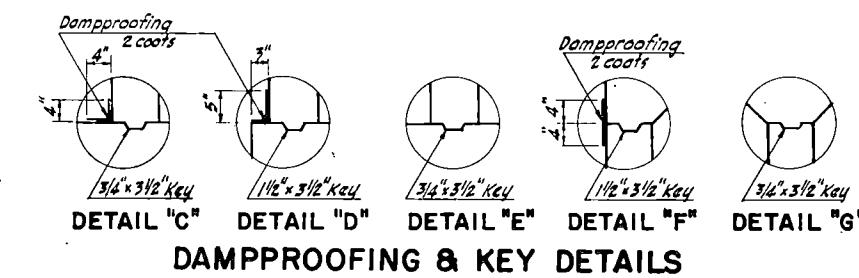


DAMPROOFING & KEY DETAILS

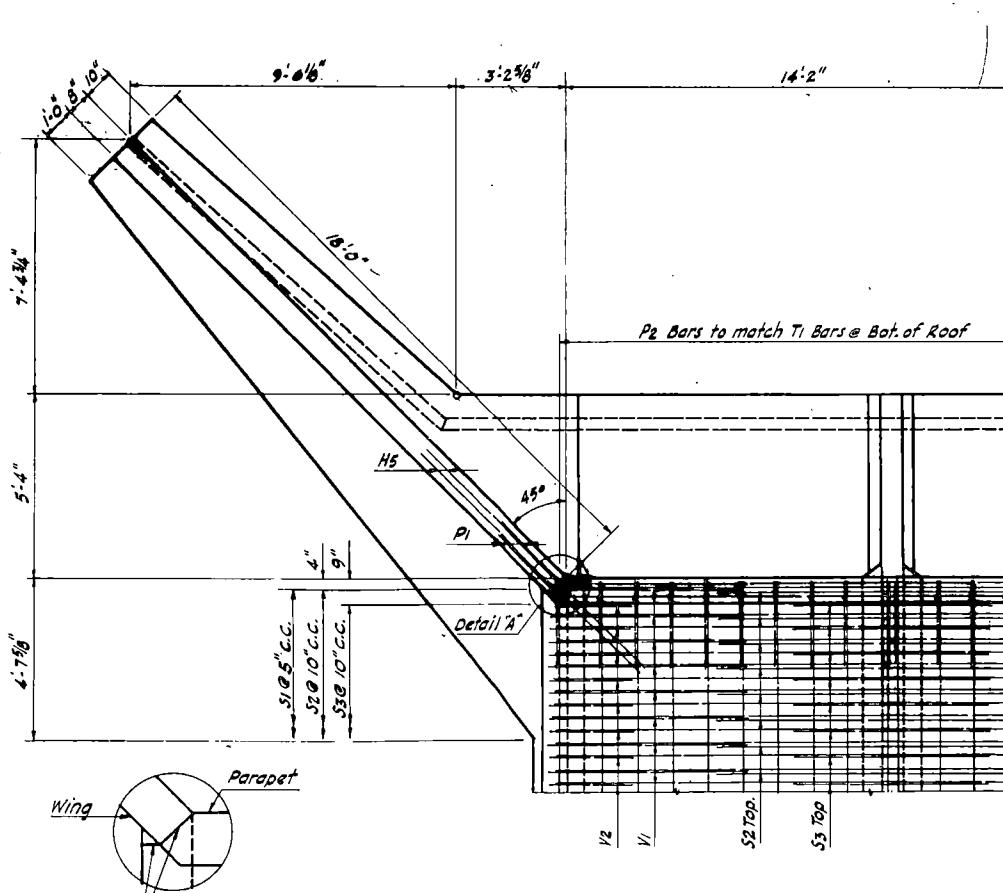


ROOF HALF PLATE

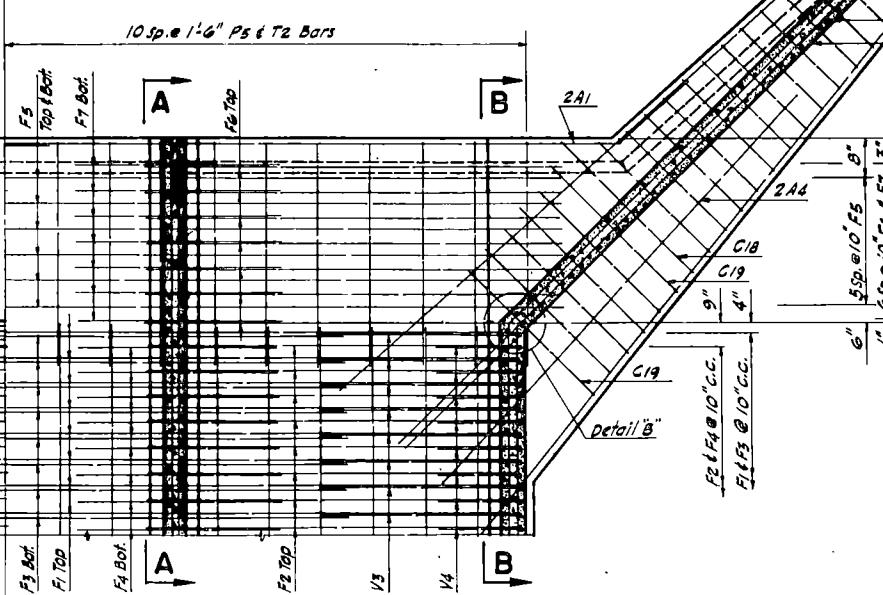

FLOOR HALF PLATE

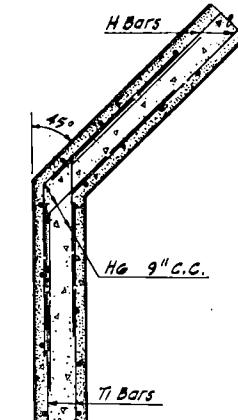

DETAIL "B"

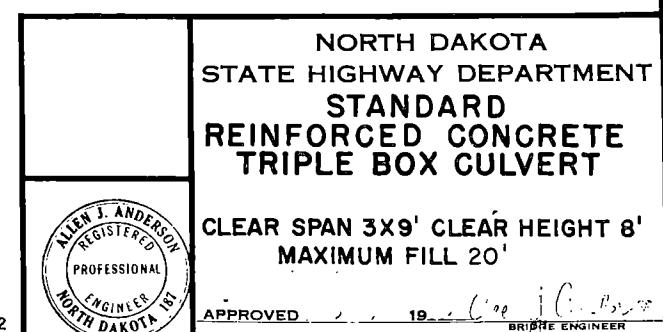


NORTH DAKOTA
STATE HIGHWAY DEPARTMENT
STANDARD
REINFORCED CONCRETE
TRIPLE BOX GULVERT

**CLEAR SPAN 3X9' CLEAR HEIGHT 8'
MAXIMUM FILL 20'**

APPROVED: 19-11-1978



SKETCH-MAP OF NORTH DAKOTA
SHOWING COUNTIES

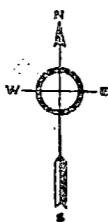

NORTH DAKOTA STATE HIGHWAY DEPARTMENT

PLANS

FOR THE PROPOSED IMPROVEMENT OF A

STATE HIGHWAY

IN LA MOURE & DICKEY COUNTIES

FEDERAL AID PROJECT NO. F-2-281(02)005 OR F-662(5)

GRADE, BIT, BASE & STRUCTURES

SCALES

LAYOUT SHEET: 1 IN. = 5000 FT
PLAN AND PROFILE: 1 IN. = 160 FT
PROFILE DRAWINGS (VERT.): 1 IN. = 10 FT
STRUCTURAL DRAWINGS: AS SHOWN
CROSS SECTION SHEETS: 1 IN. = 10 FT

LENGTH OF PROJECT		
PROJECT	MILES-GROSS	MILES-NET
F-2-281(02)	24.564	24.564
TOTALS	24.564	24.564

GOVERNING SPECIFICATIONS:

Standard Specifications adopted by the North Dakota State Highway department JULY 1971 and approved as standard by the Federal Highway Administration Sept. 29, 1971. Required Contract Provision (Form PR-1273) dated MAY 1971 and others submitted herewith.


DESIGN DATA

TRAFFIC	AVERAGE DAILY	EST. 30TH MAX. HR.
CURRENT TRAFFIC (1972)	900 PASS. 200 TRUCKS 100 TOTAL 150	
TRAFFIC FORECAST (1992)	1425 PASS. 325 TRUCKS 1750 TOTAL 235	
DESIGN SPEED	70 MPH	
TRAFFIC CLASSIFICATION	"M"	
MINIMUM SIGHT DISTANCE (STOPPING)	600'	
MINIMUM SIGHT DISTANCE (SAFE PASSING)	3200'	
MINIMUM PASSING SIGHT DISTANCE FOR MARKING	1200'	
R.C. BOX DESIGN LOADING	HS-20-44	

LIMITED CONTROL ACCESS

Access limited to points designated thus.

No access except those shown on plans. Access points as shown may be shifted slightly during construction if necessary to better serve property owners and traffic.

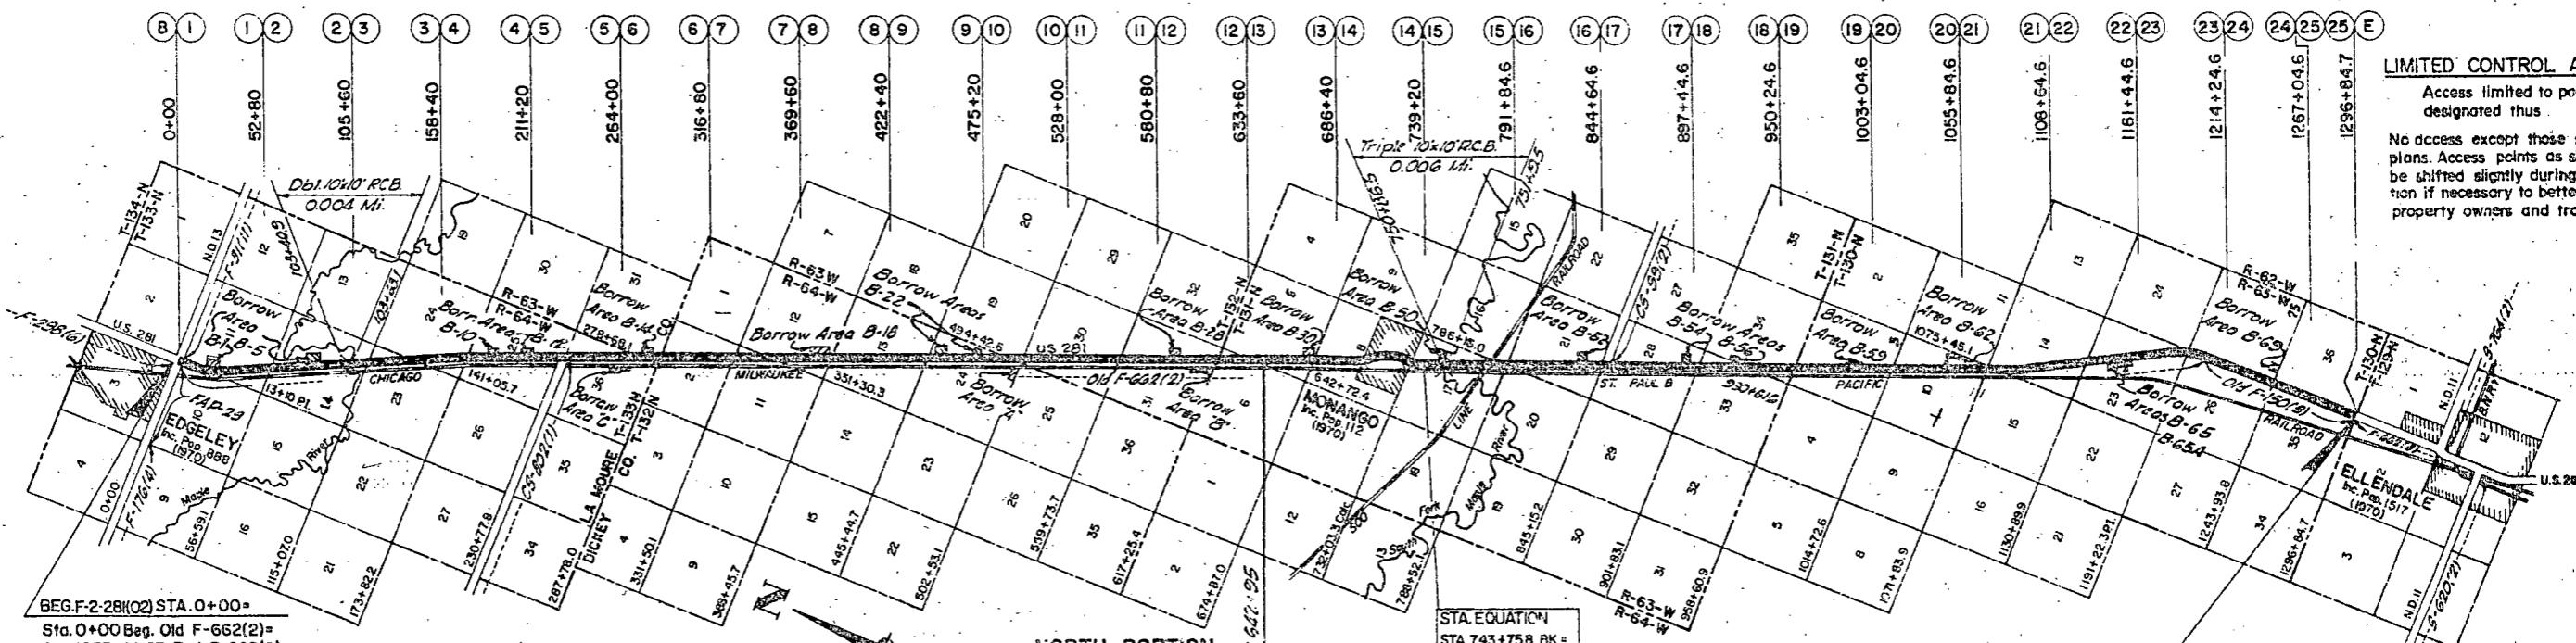

BEG F-2-281(02) STA. 0+00 =

Sta. 0+00 Beg. Old F-662(2) =

Sta. 1055+14.63 End F-298(6) =

Sta. 0100 Beg. F-3(11) =

Sta. 442+64.0 End FAP-23

A point at the N.W. Cor. of

Sec. 11, Twp. 133N., Rge. 64 W.

LAYOUT MAP

5000
SCALE IN FEET

NORTH PORTION

4 point 8.6 ft. East and 314.9 ft. North of the
SW 1/4 Cor. of the NW 1/4 Sec. 5, Twp. 131N., Rge. 63W.

STA. EQUATION
STA. 743+758 BK. =
STA. 743+60.4 AHD.

SOUTH PORTION


END F-2-281(02) STA. 1296+84.7 =

Sta. 1296+22.1 End Old F-150(3) =


Sta. 0+00 Beg. F-662(3) =

A point at the S.E. Cor. of


Sec. 35, Twp. 130N. Rge. 63W.

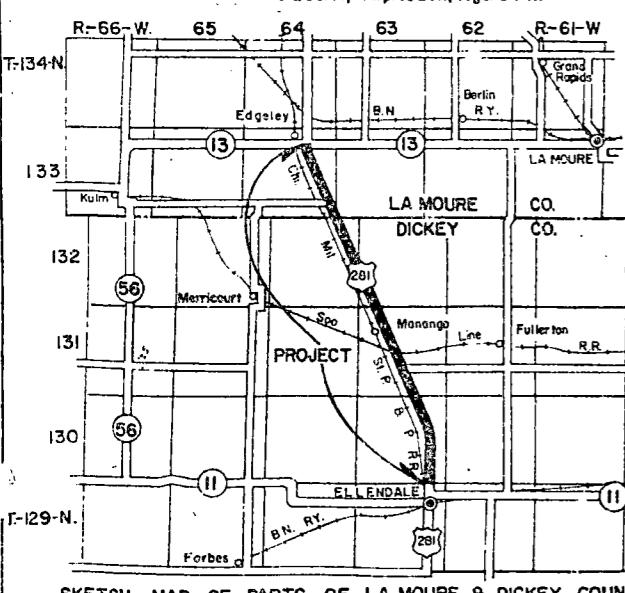


ROAD NO.	STATE	PROJ. NO.	SHEET NO.	TOTAL SHEETS
	N. D.	F-2-281(02)	101	

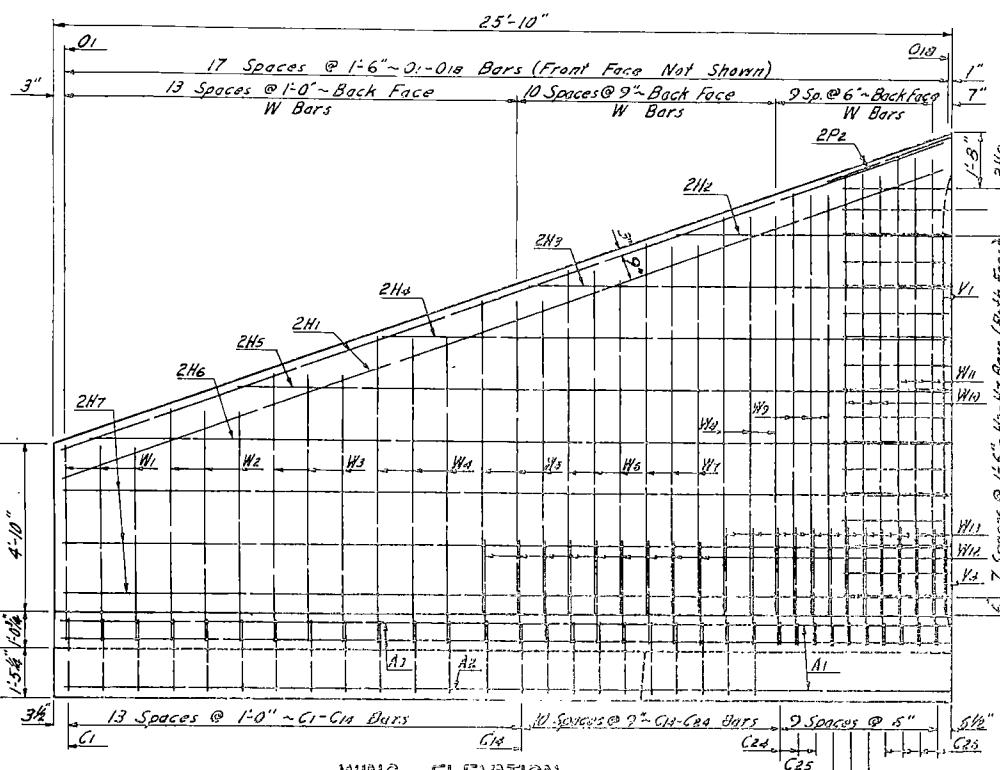


WING ELEVATIONS

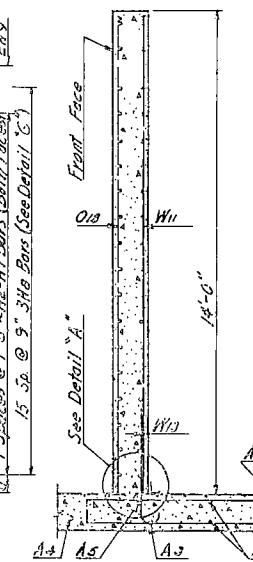


Section of high
of wing

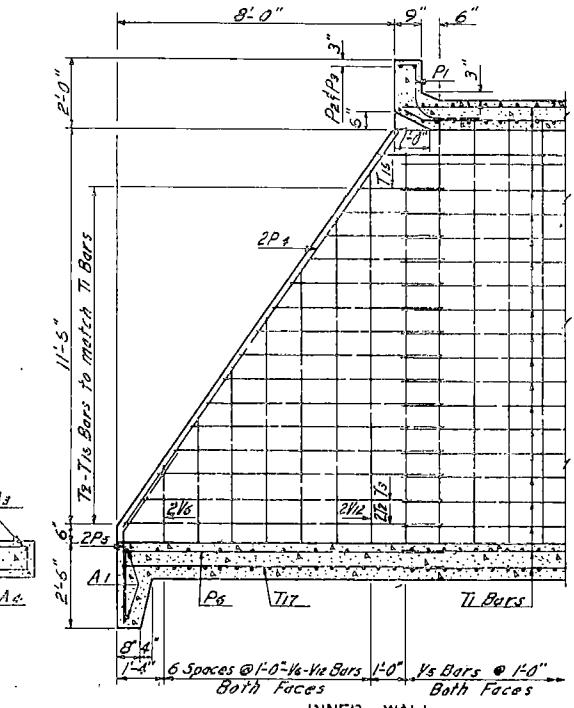


LONGITUDINAL SECTIONS OF BARREL

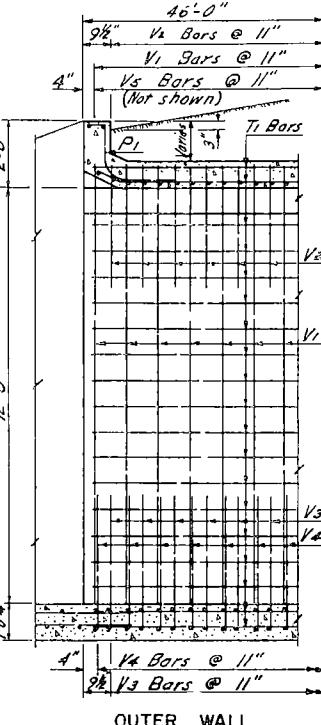


WALL

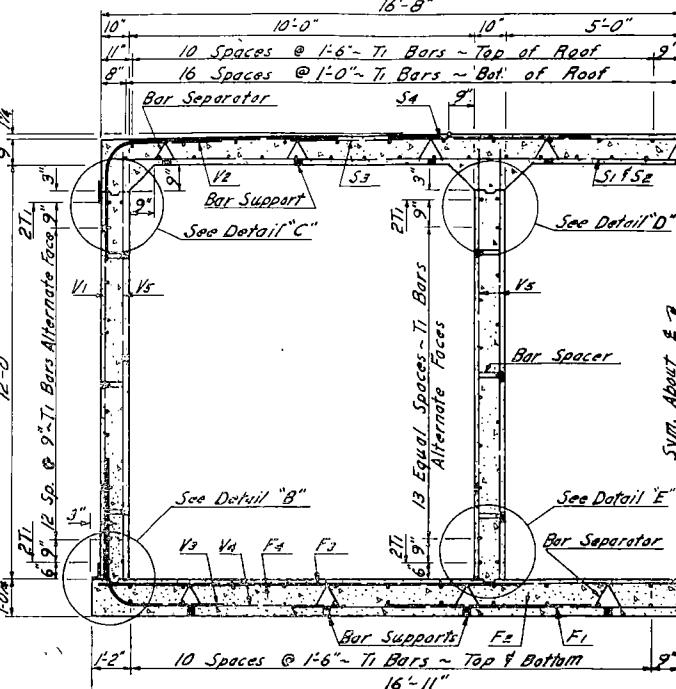

HALF BARREL SECTION

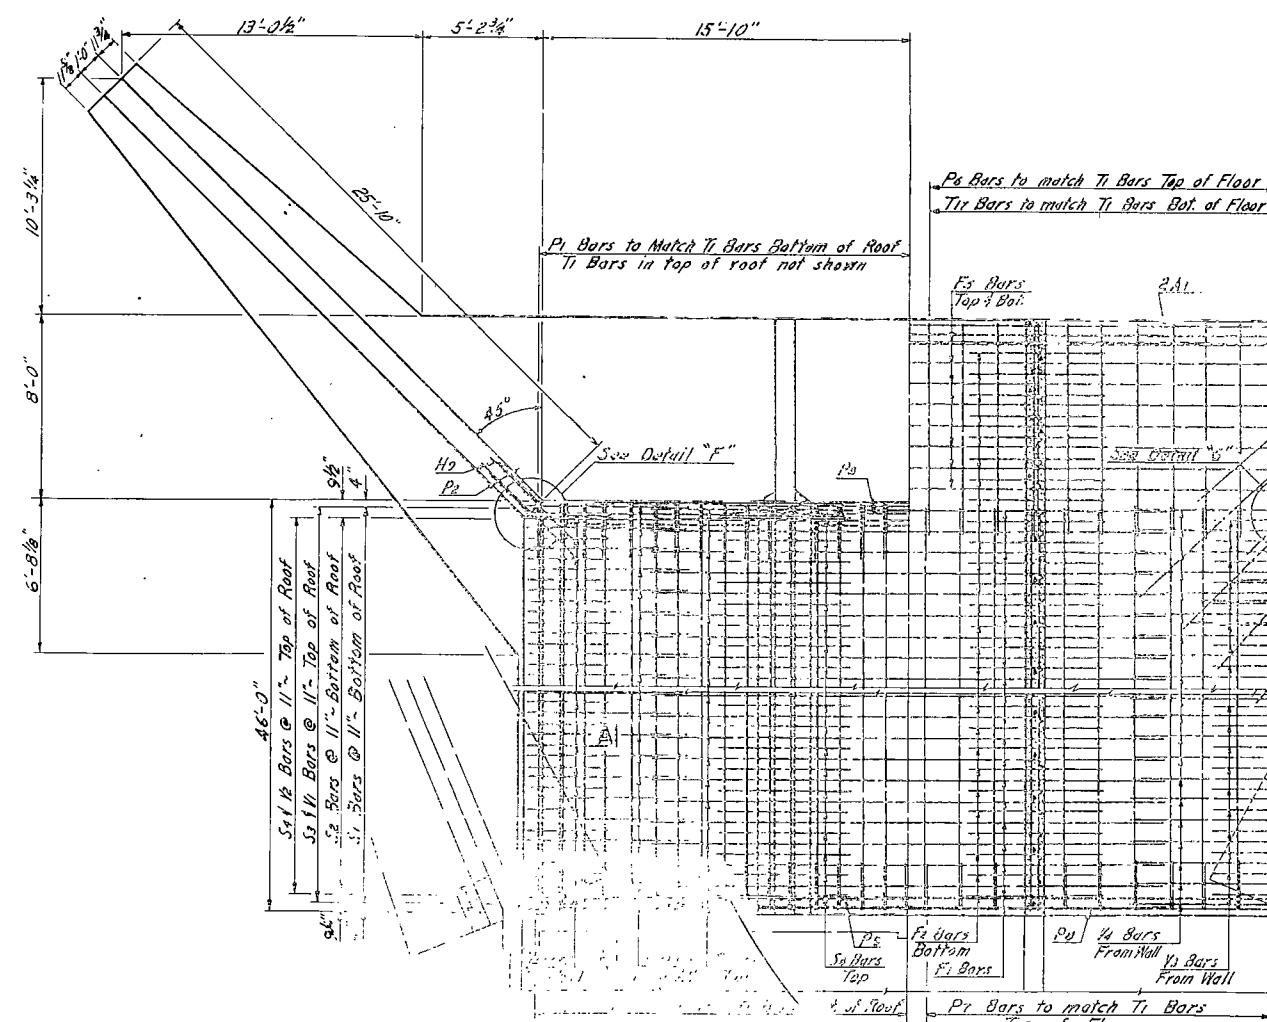

HALF ROOF PLAN **HALF FLOOR PLAN**
(*S Bars in bottom of roof not shown*) (*S Bars in top of floor not shown*)

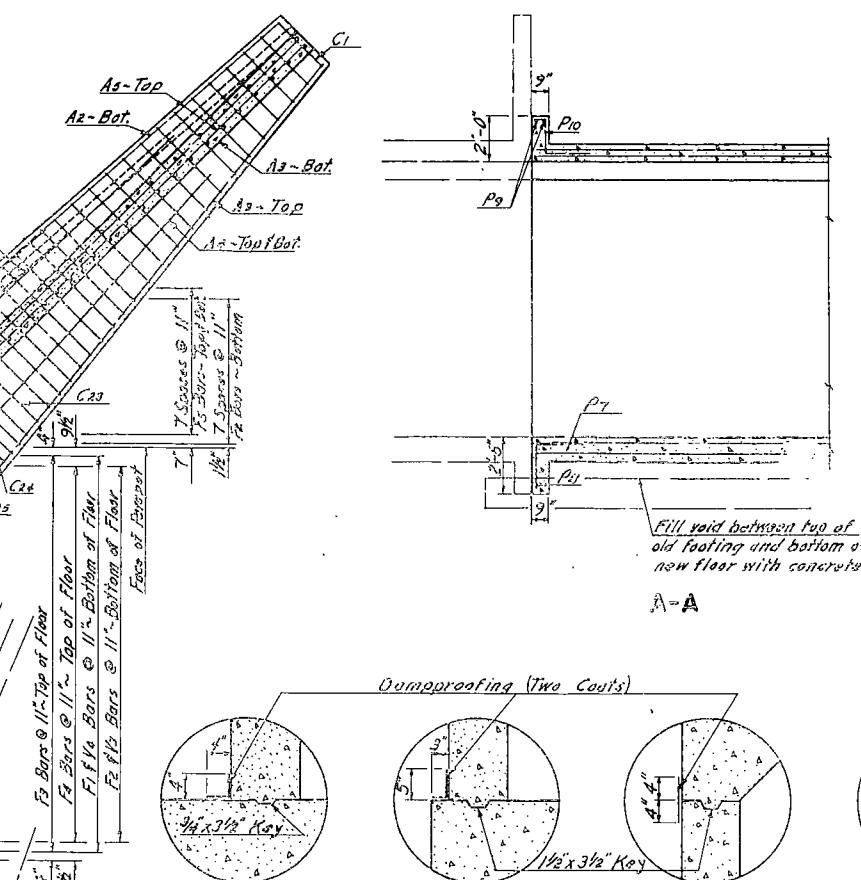

DETACH "A"

DETAIL

DETAIL

DETAIL "D"

DETAIL "

TRIPLE 10X12-10' FILL
BOX CULVERT EXTENSION

BOX COVER EXTENSION

PROJ. F-2-28(02) STA. 751+03
J. ANDERSON, SICKEN, GOLMUTH

REGISTERED SEASON DICKEY COUNTY

PROFESSIONAL 1957-58 Bell & Alderson

PROVED
BY
BRIDGE ENGINEER

281-16.46-1

2472

CONCRETE QUANTITIES

Entire Floor	=	177.85 C.Y.
4 Walls & 2 Wings	=	110.84 C.Y.
Entire Roof	=	111.86 C.Y.
Total	=	459.9 C.Y.

BAR LIST (EXTENSION)

MARK NO	SIZE	LENGTH	SHAPE	UNIT	WEIGHT
A1	4	6	23'-2"	Bent	37.80
A2	2	6	16'-6"	Str.	24.78
A3	4	4	32'-6"	"	21.70
A4	6	4	25'-6"	"	17.02
A5	4	4	28'-0"	"	18.69

C1-C6 Sets	4	204'-11"	Bent	136.80	
C9-C12 Sets	5	93'-7"	"	97.62	
C24	6	6	19'-2"	"	28.79
C25	6	6	16'-8"	"	25.03
C26	14	6	13'-4"	"	20.03

F1	52	6	22'-3"	Str.	33.42
FR	116	6	5'-9"	"	8.68
F3	32	5	33'-4"	"	34.77
F4	100	4	12'-0"	"	8.01
Es	16	5	35'-0"	"	36.51

H1	8	7	27'-3"	Str.	55.71
H2	4	4	7'-9"	"	5.17
H3	4	4	10'-0"	"	8.01
H3	4	4	16'-3"	"	10.85
H5	4	4	20'-5"	"	18.63

H6	4	4	24'-8"	"	16.57
H7	12	4	25'-6"	"	17.02
H8	96	5	6'-0"	Bent	6.26
H9	4	6	6'-0"	Str.	9.01

C1-C6 Set	4	333'-0"	Str.	222.31	
P1	33	4	3'-10"	Bent	2.56
P2	4	6	15'-0"	"	22.53
P3	2	6	13'-3"	Str.	19.90
P4	4	6	14'-3"	"	21.10
P5	4	6	5'-6"	Bent	8.26
P6	22	4	11'-6"	"	1.68
P7	22	4	4'-3"	"	2.88
P8	1	6	31'-9"	Str.	47.69
P9	2	6	33'-0"	"	49.57
P10	33	4	4'-0"	Bent	2.67

S1	52	5	38'-4"	Str.	33.73
S2	50	4	38'-4"	"	21.55
S3	52	6	28'-3"	"	33.42
S4	100	6	5'-9"	"	8.68

T1	338	4	22'-6"	Str.	15.02
T2	4	4	5'-4"	"	6.63
T3-T4 Set	4	159'-10"	"	106.70	
T7	22	4	9'-5"	"	6.29

V1	104	5	19'-0"	Bent	19.82
V2	100	6	6'-1"	"	5.31
V3	100	6	7'-3"	"	10.99
V4	104	5	10'-8"	"	11.13
V5	296	4	12'-4"	Str.	8.23


V6-V12 Sets	4	91'-7"	Str.	61.14
C1-C16 & C18-C23				
C24-C25				
C26				

C1-C16 & C18-C23				
C24-C25				
C26				


C24-C26				

BENT BAR DETAILS


Dimensions Shown Are Out to Out

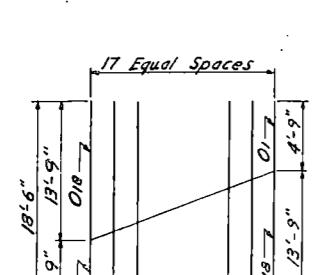

01-018
1 Set Shown

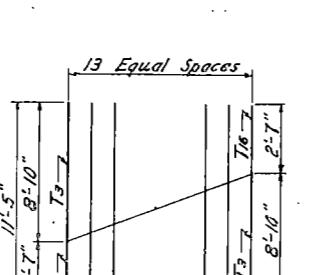

T3-T16
1 Set Shown

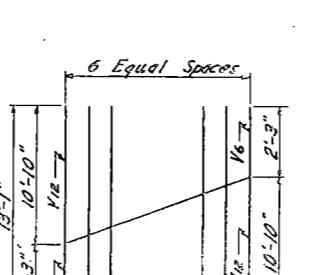

V6-V12
1 Set Shown

BAR CUTTING DIAGRAMS

