

1	1-4
2	5-7
3	8-10
4	11-15
5	16-18A
6	19-21
7	22-24A
8	25-28
9	29-32
10	34-36
11	38-41
12	42-45
13	46-50
14	51-54
15	55-61
16	62-66
17	67-71
18	72-79
19	80-84
20	85-90
21	91-94
22	95-97

SYSTEM DIST. HWY. AGREEMENT
 I-IG-4-94 ()
 MILE 128.1



NORTH DAKOTA
 STATE HIGHWAY DEPARTMENT
 RIGHT OF WAY PLATS OF

DEPARTMENT OF COMMERCE
 BUREAU OF PUBLIC ROADS
 APPROVED
 DIVISION ENGINEER DATE

1-IG-94-4(3)
MORTON CO.

This document was originally issued and sealed by Robert E. King, Registration Number LS 1001 on ___/___/___ and the original document is stored at the County Recorders Office

APPROVED: *Robert E. King*
 RIGHT OF WAY ENGINEER
 DATE 7-31-63

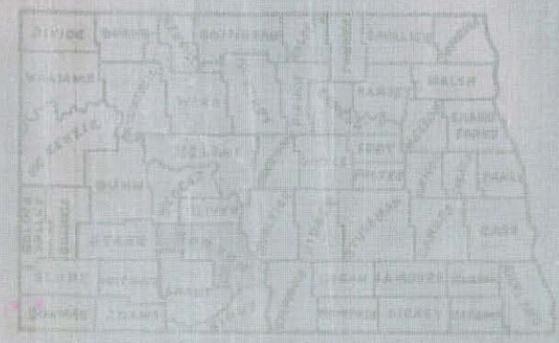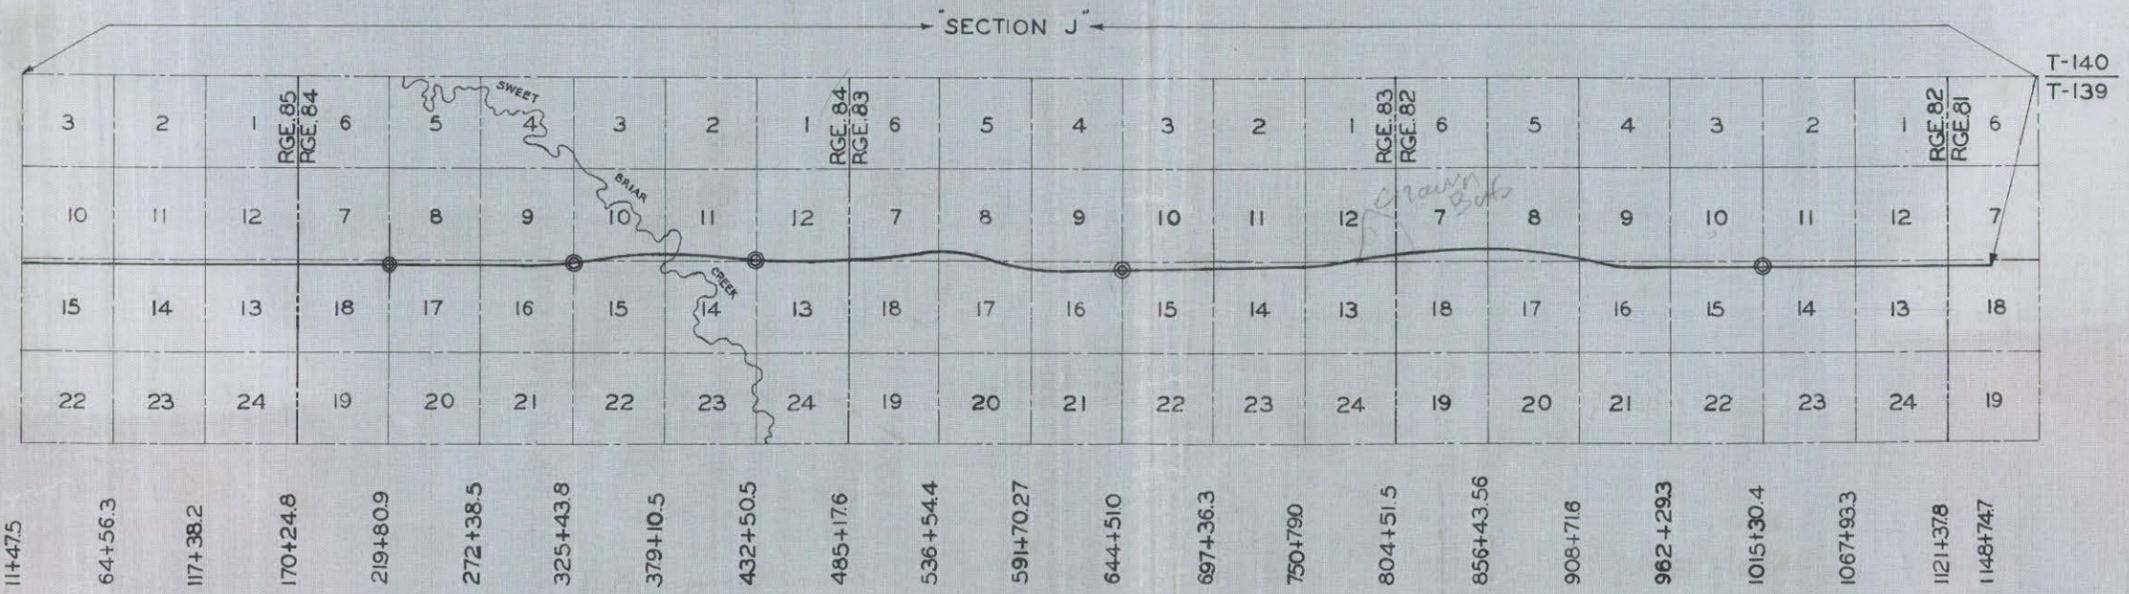

STATE & NATIONAL LINES
 COUNTY LINE
 TOWNSHIP & RANGE LINES
 SURVEY CENTERLINE
 OLD RIGHT OF WAY LINE
 NEW RIGHT OF WAY LINE
 ABANDONED RIGHT OF WAY LINE
 PROPERTY LINE
 STONE WALL
 OTHER FENCES
 HEDGES & TREES

KEY TO CONVENTIONAL SIGNS

TELEPHONE LINE
 POWER LINES
 BRIDGE
 TRAVELED WAY
 TRAILS
 RAILROADS
 SECTION CORNER
 CITY OR VILLAGE CORPORATE LIMITS
 INTERCHANGE
 GRADE SEPARATION
 SERVICE ROAD


SKETCH MAP OF NORTH DAKOTA

SW1/4-10-139-85
 Parcel No. 1 Advertising Control
 Fred E. John
 New Salem, North Dakota

PROJ. NO.	PARCEL	PLAT NO.	SUPPLEMENTS
I-IG-94-4(3)	1-4	1 OF 22	ONE

SECTION "J" Parcel No. 4A Eliminated 6-21-63 L.E.C.

SE1/4-10-139-85
 Parcel No. 2 Advertising Control
 Oscar John
 New Salem, North Dakota

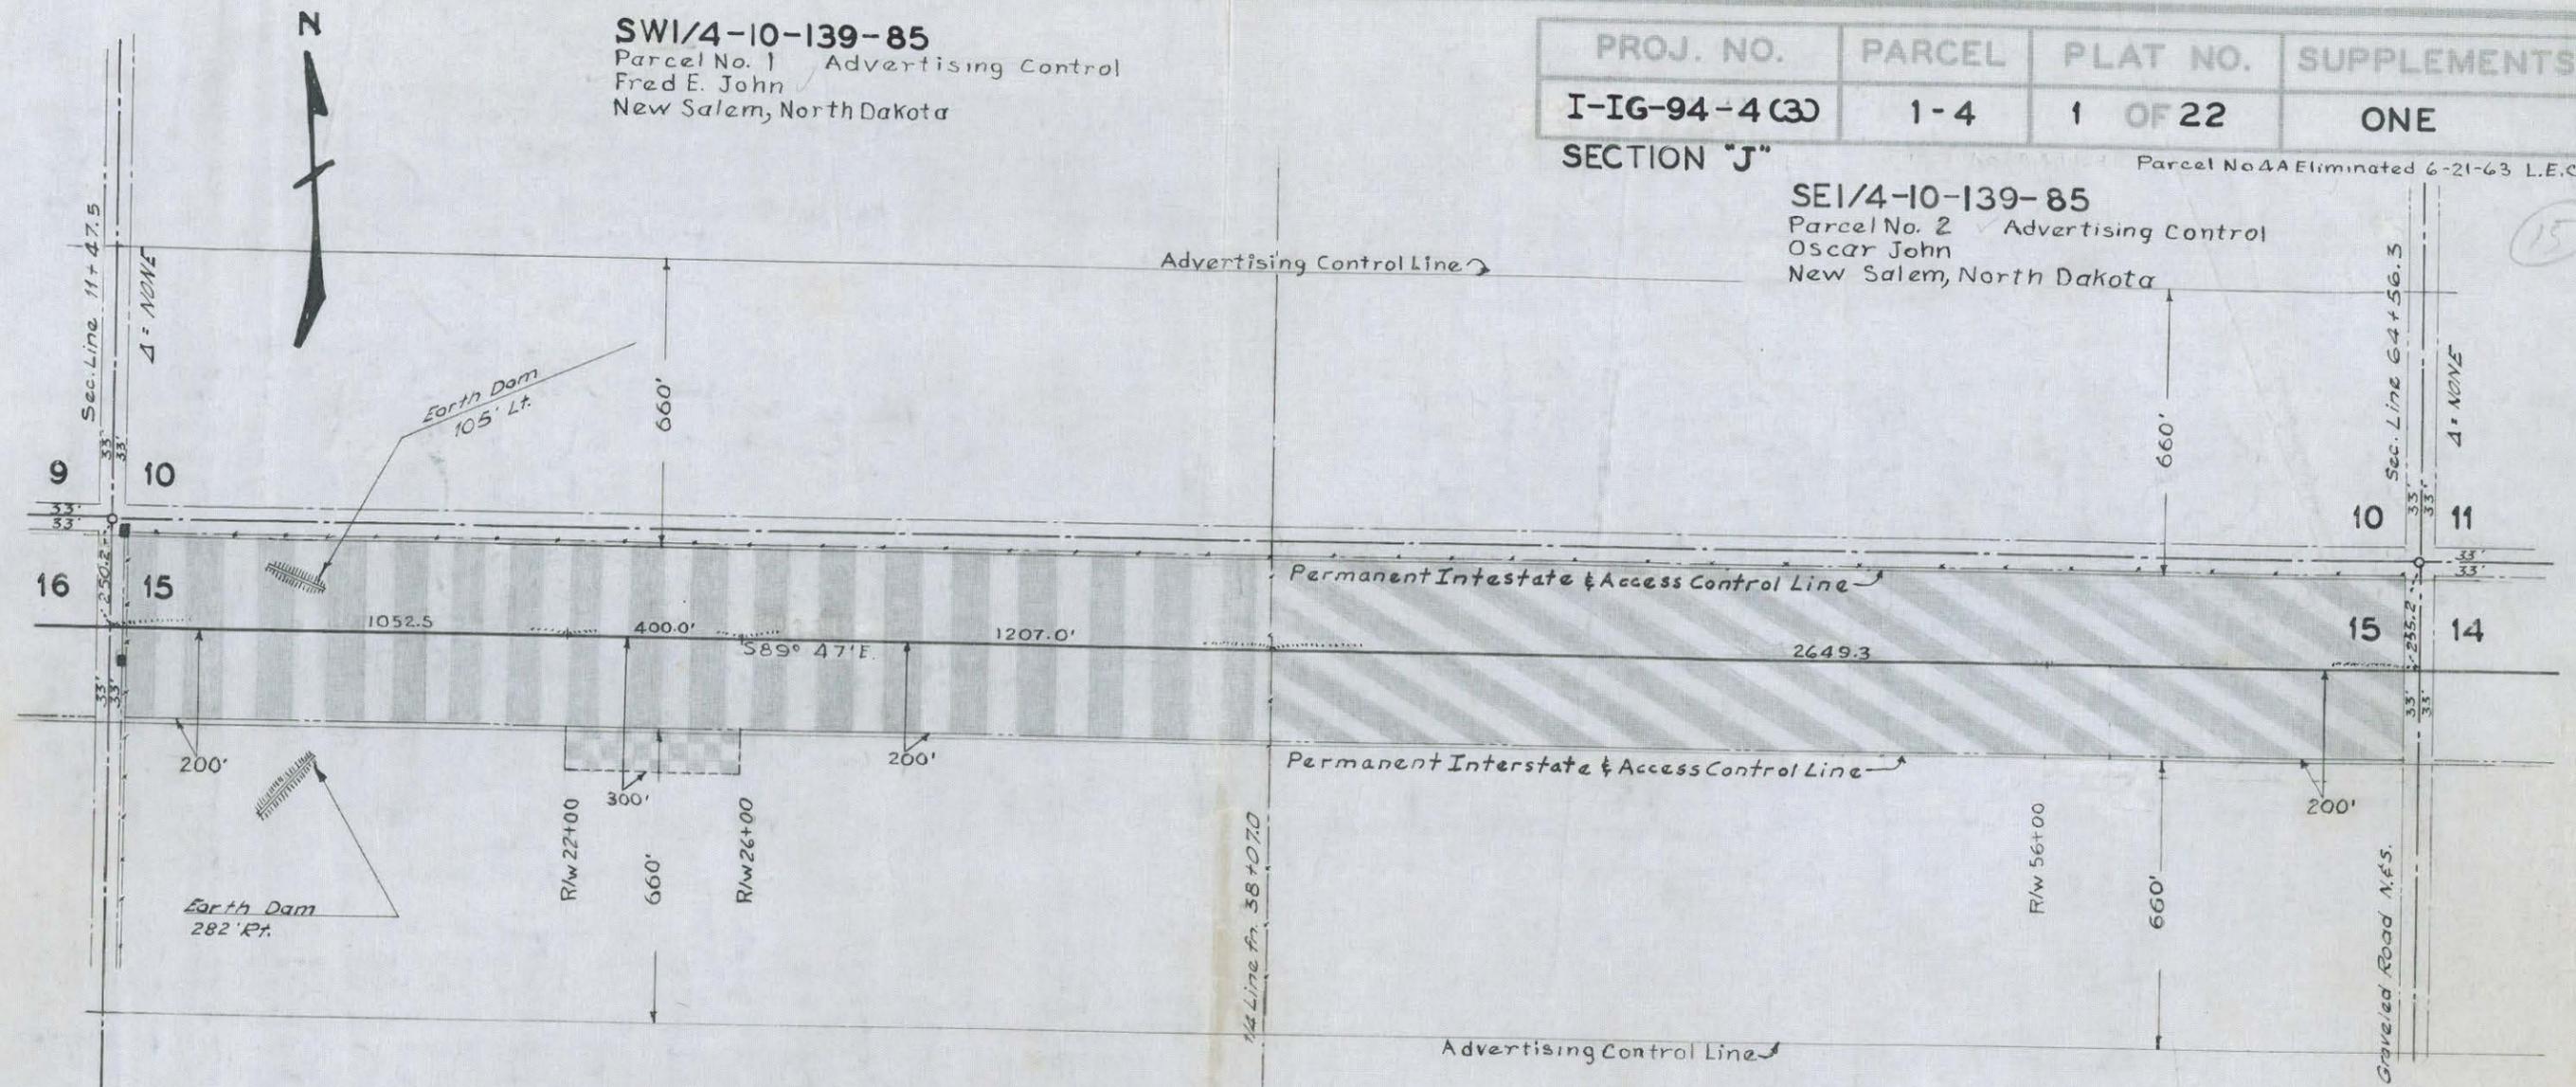

NW1/4-15-139-85
 Parcel No. 3 25.23 Ac.
 Herbert Lehde
 New Salem, North Dakota
 Parcel No. 3A 0.92 Ac.
 Temp. Waste Easement
 Owners same as Parcel No. 3

NE1/4-15-139-85
 Parcel No. 4 25.28 Ac.
 Louise South
 845 Euclid Ave.,
 San Francisco 18, California
 Edna Horn
 943 Cliff St.
 Pacific Palisades, California
 Ruth Beusen
 New Salem, N. Dak.

NOTE
 INSTALL PIPE CUIVERTS
 53+00 N. Rdwy. 51" x 31" x 62'
 53+00 S. Rdwy 51" x 31" x 60'

SYSTEM DIST. HWY. AGREEMENT

MILE _____

This document was originally issued and sealed by Robert E. King, Registration Number LS 1001 on _____ and the original document is stored at the County Recorders Office

NORTH DAKOTA
 STATE HIGHWAY DEPARTMENT
RIGHT OF WAY PLAT
 PROJECT NO. I-IG-94-4(3)
 MORTON COUNTY
 APPROVED *Robert E. King*
 RIGHT OF WAY ENGINEER

SCALE 1" = 400' DATE 7-31-63

DATE 2-25-63
 CHECKED BY L.V. Moravitz
 DATE 10-25-62
 MADE BY R.L. Asplund

Parcel No. 1

All right and control over the erection, location or maintenance of billboards, signs or any form of advertising whatsoever, upon all that portion of the SW $\frac{1}{4}$ of Sec. 10, Twp. 139 N., Rge. 85 W., in Morton County, North Dakota within 660 feet of the controlled access limits of Project I-IG-94-4(3), Morton County, North Dakota as shown on right of way plats on file in the office of the Register of Deeds of Morton County, North Dakota.

Parcel No. 2

All right and control over the erection, location or maintenance of billboards, signs or any form of advertising whatsoever, upon all that portion of the SE $\frac{1}{4}$ of Sec. 10, Twp. 139 N., Rge. 85 W., in Morton County, North Dakota within 660 feet of the controlled access limits of Project I-IG-94-4(3), Morton County, North Dakota as shown on right of way plats on file in the office of the Register of Deeds of Morton County, North Dakota.

Parcel No. 3

All that portion of the NW $\frac{1}{4}$ of Sec. 15, Twp. 139 N., Rge. 85 W., 5th P. M., lying within a strip of land 200 ft. wide, located on the southerly side of and measured at right angles to the following described highway centerline as surveyed and staked:

Beginning at a point 250.2 ft. south of the northwest corner of said NW $\frac{1}{4}$, thence running S 89°47'E 2659.5 ft. more or less to a point where said strip crosses the east line of said NW $\frac{1}{4}$, also including all that portion lying northerly of the above described highway centerline, excepting all that portion lying within 33 feet of the section lines.

Tract contains 25.23 acres, more or less, and is shown on plat as shaded area.

Also including all right of access, being the right of ingress to and egress from the remaining property to and from the highway right of way, as shown on right of way plat. And including all right and control over the erection, location or maintenance of billboards, signs or any form of advertising whatsoever, upon all that portion of the NW $\frac{1}{4}$ of Sec. 15, Twp. 139 N., Rge. 85 W., in Morton County, North Dakota within 660 feet of the controlled access limits of Project I-IG-94-4(3), Morton County, North Dakota as shown on right of way plats on file in the office of the Register of Deeds of Morton County, North Dakota.

Parcel No. 4

All that portion of the NE $\frac{1}{4}$ of Sec. 15, Twp. 139 N., Rge. 85 W., 5th P. M., lying within a strip of land 200.0 ft. wide, located on the southerly side of and measured at right angles to the following described highway centerline as surveyed and staked:

Beginning at a point 255.2 ft. south of the northeast corner of said NE $\frac{1}{4}$, thence running N 89°47'W 2649.3 ft. more or less to a point where said strip crosses the west line of said NE $\frac{1}{4}$. Also including all that portion lying northerly of the above described highway centerline, excepting all that portion lying within 33 feet of the section lines.

Tract contains 25.28 acres, more or less, and is shown on plat as shaded area.

Also including all right of access, being the right of ingress to and egress from the remaining property to and from the highway right of way, as shown on the right of way plat. And including all right and control over the erection, location or maintenance of billboards, signs or any form of advertising whatsoever, upon all that portion of the NE $\frac{1}{4}$ of Sec. 15, Twp. 139 N., Rge. 85 W., in Morton County, North Dakota within 660 feet of the controlled access limits of Project I-IG-94-4(3), Morton County, North Dakota as shown on

SYSTEM DIST. HWY. AGREEMENT

PROJECT NO. I-IG-94-4(3)
SUPPLEMENT TO PLAT NO. 1 OF 22

Parcel No. 4 continued

MILE _____

right of way plats on file in the office of the Register of Deeds of Morton County, North Dakota.

~~All that portion of the NE $\frac{1}{4}$ of Sec. 15, Twp. 139 N., Rge. 85 W., 5th P. M., lying within a strip of land located on the southerly side of and measured at right angles to the following described highway centerline as surveyed and staked: Beginning at a point 255.2 ft. south of the northeast corner of said NE $\frac{1}{4}$ where said strip is 250.0 ft. wide, thence running N 89°47'W 856.3 ft. more or less to a point where said strip changes to 200.0 ft. in width, thence continuing N 89°47'W until said strip crosses the west line of said NE $\frac{1}{4}$, excepting all that portion lying within 200.0 ft. of the above described centerline and all that portion lying within 33 feet of the section line.~~

~~Tract contains 0.95 acres, more or less, and is shown on plat as shaded area.~~

Parcel No. 3A

All that portion of the NW $\frac{1}{4}$ of Sec. 15, Twp. 139 N., Rge. 85 W., 5th P. M., lying within a strip of land located on the southerly side of and measured at right angles to the following described highway centerline as surveyed and staked:

Beginning at a point 250.2 ft. south of the northwest corner of said NW $\frac{1}{4}$, where said strip is 200.0 ft. wide, thence running S 89°47'E 1052.5 ft. more or less to a point where said strip changes to 300.0 ft. in width, thence continuing S 89°47'E 400.0 ft. more or less to a point where said strip changes to 200.0 ft. in width, thence continuing S 89°47'E 1207.0 ft. more or less until said strip crosses the east line of said NW $\frac{1}{4}$, excepting all that portion lying within 200.0 ft. of the above described highway centerline.

Tract contains 0.92 acres, more or less, and is shown on plat as shaded area.

Parcel No. 5

All right and control over the erection, location or maintenance of billboards, signs or any form of advertising whatsoever, upon all that portion of the S $\frac{1}{2}$ of Sec. 11, Twp. 139 N., Rge. 85 W., in Morton County, North Dakota within 660 feet of the controlled access limits of Project I-IG-94-4(3), Morton County, North Dakota as shown on right of way plats on file in the office of the Register of Deeds of Morton County, North Dakota.

Parcel No. 6

All that portion of the NW $\frac{1}{4}$ of Sec. 14, Twp. 139 N., Rge. 85 W., 5th P.M., lying within a strip of land 200.0 ft. wide, located on the southerly side of and measured at right angles to the following described highway centerline as surveyed and staked:

Beginning at a point 255.2 ft. south of the northwest corner of said NW $\frac{1}{4}$, thence running S 89°47'E 2623.7 ft. more or less to a point where said strip crosses the east line of said NW $\frac{1}{4}$. Also including all that portion lying northerly of the above described highway centerline, excepting all that portion lying within 33 feet of the section lines.

Tract contains 25.14 acres, more or less, and is shown on plat as shaded area.

Also including all right of access, being the right of ingress to and egress from the remaining property to and from the highway right of way, as shown on the right of way plat. And including all right and control over the erection, location or maintenance of billboards, signs or any form of advertising whatsoever, upon all that portion of the NW $\frac{1}{4}$ of Sec. 14, Twp. 139 N., Rge. 85 W., in Morton County, North Dakota within 660 feet of the controlled access limits of Project I-IG-94-4(3), Morton County, North Dakota as shown on right of way plats on file in the office of the Register of Deeds of Morton County, North Dakota.

~~Parcel No. 6A~~

~~All that portion of the NW $\frac{1}{4}$ of Sec. 14, Twp. 139 N., Rge. 85 W., 5th P.M., lying within a strip of land located on the southerly side of and measured at right angles to the following described highway centerline as surveyed and staked:~~

~~Beginning at a point 255.2 ft. south of the northwest corner of said NW $\frac{1}{4}$, where said strip is 250.0 ft. wide, thence running S 89°47'E 543.7 ft. more or less to a point where said strip changes to 200.0 ft. in width, thence continuing S 89°47'E until said strip crosses the east line of said NW $\frac{1}{4}$, excepting all that portion lying within 200.0 ft. of the above described centerline and all that portion lying within 33 feet of the section line.~~

~~Tract contains 0.59 acres, more or less, and is shown on plat as shaded area.~~

Parcel No. 7

All that portion of the NE $\frac{1}{4}$ of Sec. 14, Twp. 139 N., Rge. 85 W., 5th P.M., lying within a strip of land 200.0 ft. wide, located on the southerly side of and measured at right angles to the following described highway centerline as surveyed and staked:

Beginning at a point 257.4 ft. south of the northeast corner of said NE $\frac{1}{4}$, thence running N 89°47'W 2658.2 ft. more or less to a point where said strip crosses the west line of said NE $\frac{1}{4}$; also including all that portion lying northerly of the above described highway centerline, excepting all that portion lying within 33 feet of the section lines.

Tract contains 25.54 acres, more or less, and is shown on plat as shaded area.

SYSTEM DISP. HWY. AGREEMENT

PROJECT NO. 1-IG-94-4(3)
SUPPLEMENT TO PLAT NO. 2 OF 22

MILE _____

Parcel No. 7 continued

15

Also including all right of access, being the right of ingress to and egress from the remaining property to and from the highway right of way, as shown on right of way plat. And including all right and control over the erection, location or maintenance of billboards, signs or any form of advertising whatsoever, upon all that portion of the NE $\frac{1}{4}$ of Sec. 14, Twp. 139 N., Rge. 85 W., in Morton County, North Dakota within 660 feet of the controlled access limits of Project I-IG-94-4(3), Morton County, North Dakota as shown on right of way plats on file in the office of the Register of Deeds of Morton County, North Dakota.

Parcel No. 5A

The south 133.0 ft. of the east 600.0 ft. of the west 1543.7 ft. of the S $\frac{1}{2}$ of Sec. 11, Twp. 139 N., Rge. 85 W., 5th P. M., excepting all that portion lying within 33 feet of the section line.

Tract contains 1.38 acres, more or less, and is shown on plat as shaded area.

SI/2-12-139-85


Parcel No. 8 Advertising Control
Christ and Gertrude Kaelberer h/w
New Salem, North Dakota

Parcel No 8A 1.84 Ac.
Temp. Waste Easement
Owner same as Parcel No. 8

PROJ. NO.	PARCEL	PLAT NO.	SUPPLEMENTS
I-IG-94-4(3)	8-10	3 OF 22	ONE

SECTION "J"

$\Delta: 0^{\circ}44' Lt.$
 $D: 0^{\circ}10'$
 $R: 34377.48$
 $T: 220.02$
 $L: 440.0$

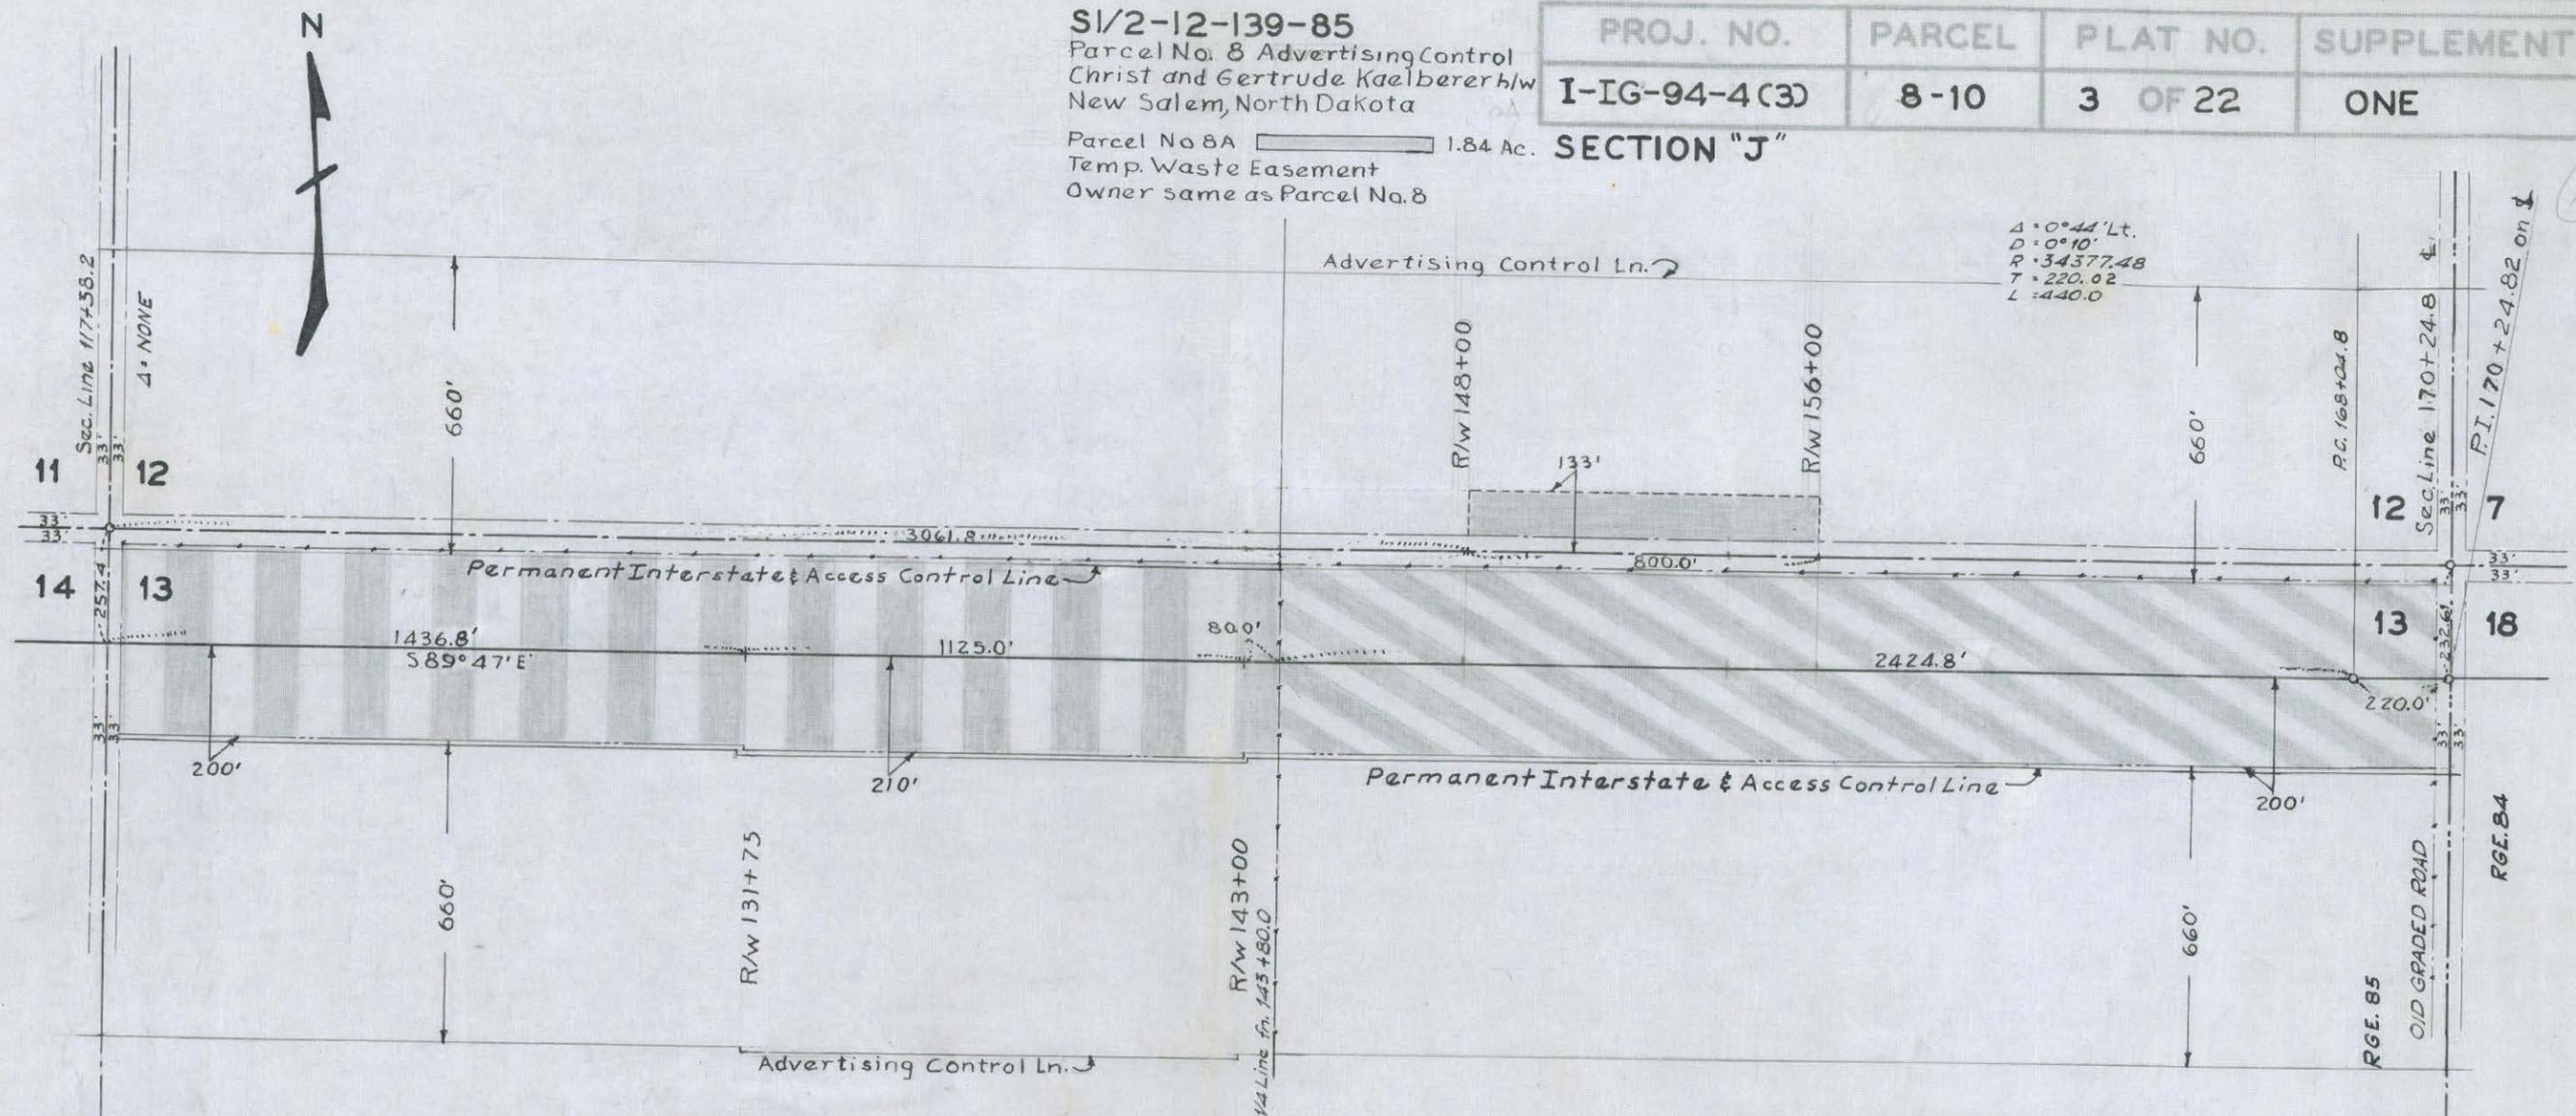

NI/2NW1/4 -13-139-85

Parcel No. 9 25.31 Ac.
Minnie Boehm
New Salem North Dakota

NE1/4-13-139-85

Parcel No. 10 24.33 Ac.
Christ and Gertrude Kaelberer h/w
New Salem, North Dakota

SYSTEM DIST. HWY. AGREEMENT

_____ ()

MILE _____

This document was originally issued and sealed by Robert E. King, Registration Number LS 1001 on ___/___/___ and the original document is stored at the County Recorders Office

NORTH DAKOTA
STATE HIGHWAY DEPARTMENT

RIGHT OF WAY PLAT

PROJECT NO. I-IG-94-4(3)

MORTON COUNTY

APPROVED *Robert E. King*
RIGHT OF WAY ENGINEER

SCALE 1" = 400' DATE 7-31-63

DATE 2-28-63

CHECKED BY L.V. Moravitz

DATE 10-25-62

MADE BY P.L. Asplund

Parcel No. 8

All right and control over the erection, location or maintenance of billboards, signs or any form of advertising whatsoever, upon all that portion of the S $\frac{1}{2}$ of Sec. 12, Twp. 139 N., Rge. 85 W., in Morton County, North Dakota within 660 feet of the controlled access limits of Project I-IG-94-4(3), Morton County, North Dakota as shown on right of way plats on file in the office of the Register of Deeds of Morton County, North Dakota.

Parcel No. 9

All that portion of the N $\frac{1}{2}$ NW $\frac{1}{4}$ of Sec. 13, Twp. 139 N., Rge. 85 W., 5th P.M., lying within a strip of land located on the southerly side of and measured at right angles to the following described highway centerline as surveyed and staked:

Beginning at a point 257.4 ft. south of the northwest corner of said N $\frac{1}{2}$ NW $\frac{1}{4}$, where said strip is 200.0 ft. wide, thence running S 89°47'E 1436.8 ft. more or less to a point where said strip changes to 210.0 ft. in width, thence continuing S 89°47'E 1125.0 ft. more or less to a point where said strip changes to 200.0 ft. in width, thence continuing S 89°47'E 80.0 ft. more or less to point where said strip crosses the east line of said N $\frac{1}{2}$ NW $\frac{1}{4}$; also including all that portion lying northerly of the above described centerline, excepting all that portion lying within 33 feet of the section lines.

Tract contains 25.31 acres, more or less, and is shown on plat as shaded area.

Also including all right of access, being the right of ingress to and egress from the remaining property to and from the highway right of way, as shown on the right of way plat. And including all right and control over the erection, location or maintenance of billboards, signs or any form of advertising whatsoever, upon all that portion of the N $\frac{1}{2}$ NW $\frac{1}{4}$ of Sec. 13, Twp. 139 N., Rge. 85 W., in Morton County, North Dakota within 660 feet of the controlled access limits of Project I-IG-94-4(3), Morton County, North Dakota as shown on right of way plats on file in the office of the Register of Deeds of Morton County, North Dakota.

Parcel No. 10

All that portion of the NE $\frac{1}{4}$ of Sec. 13, Twp. 139 N., Rge. 85 W., 5th P. M., lying within a strip of land 200.0 ft. wide, located on the southerly side of and measured at right angles to the following described highway centerline as surveyed and staked:

Beginning at a point 257.4 ft. south and 2641.8 ft. S 89°47'E from the northwest corner of said Section 13, thence running S 89°47'E 2424.8 ft. thence along a 0°10' curve to the left 220.0 ft. more or less until said strip crosses the east line of said NE $\frac{1}{4}$; also including all that portion lying northerly of the above described highway centerline, excepting all that portion lying within 33 feet of the section lines.

Tract contains 24.33 acres, more or less, and is shown on plat as shaded area.

Also including all right of access, being the right of ingress to and egress from the remaining property to and from the highway right of way, as shown on right of way plat. And including all right and control over the erection, location or maintenance of billboards, signs or any form of advertising whatsoever, upon all that portion of the NE $\frac{1}{4}$ of Sec. 13, Twp. 139 N., Rge. 85 W., in Morton County, North Dakota within 660 feet of the controlled access limits of Project I-IG-94-4(3), Morton County, North Dakota as shown on right of way plats on file in the office of the Register of Deeds of Morton County, North Dakota ~~as shown on right of way plats on file in the office of the Register of Deeds of Morton County, North Dakota~~

SYSTEM DIST. HWY. AGREEMENT

MILE _____

PROJECT NO. I-IG-94-4(3)
SUPPLEMENT TO PLAT NO. 3 OF 22

Parcel No. 8A

The south 133.0 ft. of the east 800.0 ft. of the west 3861.8 ft. of the S $\frac{1}{2}$ of Sec. 12, Twp. 139 N., Rge. 85 W., 5th P. M., excepting all that portion lying within 33 feet of the section line.

Tract contains 1.84 acres, more or less, and is shown on plat as shaded area.

DATE 10-26-62 CHECKED BY L.V. Moravitz DATE 3-4-63 MADE BY R.L. Asplund

PROJ. NO.	PARCEL	PLAT NO.	SUPPLEMENTS
I-IG-94-4 (3)	11-15	4 OF 22	ONE

SW 1/4-7-139-84
 Parcel No. 11 Advertising Control
 1/4th - C.J. Bechtold and Gertrude I. Bechtold Mandan, N. Dak.
 1/4th - Gertrude Louise Reinke (No Address)
 1/4th - Glen McGettigan and Glen Robert McGettigan (No Address)
 1/4th - Clara Tausend, Hilma Moltzen, Esther Zeigler,
 Mildred Cofer & Harlo Tausend (No Address)

SECTION "J"
SE 1/4-7-139-84
 Parcel No. 12 0.67 Ac.
 Selma Walde
 New Salem, N.D.

Parcel No. 12A 2.66 Ac.
 Temp. Waste Easement
 Owner same as Parcel No. 12

NW 1/4-18-139-84
 Parcel No. 13 20.94 Ac.
 1/4th - C.J. Bechtold and Gertrude I. Bechtold Mandan, North Dakota
 1/4th - Gertrude Louise Reinke (No Address)
 1/4th - Glen McGettigan & Glen Robert McGettigan (No Address)
 1/4th - Clara Tausend, Hilma Moltzen, Esther Zeigler,
 Mildred Cofer, Harlo Tausend (No Address)

NE 1/4-18-139-84
 Parcel No. 15 24.71 Ac.
 George H. Kunz
 New Salem, North Dakota
 Contract for Deed by
 George & Gertrude Kunz h/w with
 Wilbert O. & Delores Kunz h/w
 New Salem, North Dakota

Parcel No. 14 0.05 Ac.
 Temp. Slope Easement
 Owner same as Parcel No. 13

NOTE
 INSTALL PIPE CUIVERT
 204 + 64 60" x 168'

This document was originally issued and sealed by Robert E. King, Registration Number LS 1001 on ___/___/___ and the original document is stored at the County Recorders Office

SYSTEM DIST. HWY. AGREEMENT

NORTH DAKOTA
 STATE HIGHWAY DEPARTMENT


RIGHT OF WAY PLAT

PROJECT NO. I-IG-94-4 (3)

MORTON COUNTY

APPROVED *Robert E. King*
 RIGHT OF WAY ENGINEER

SCALE 1" = 400' DATE 7-31-63

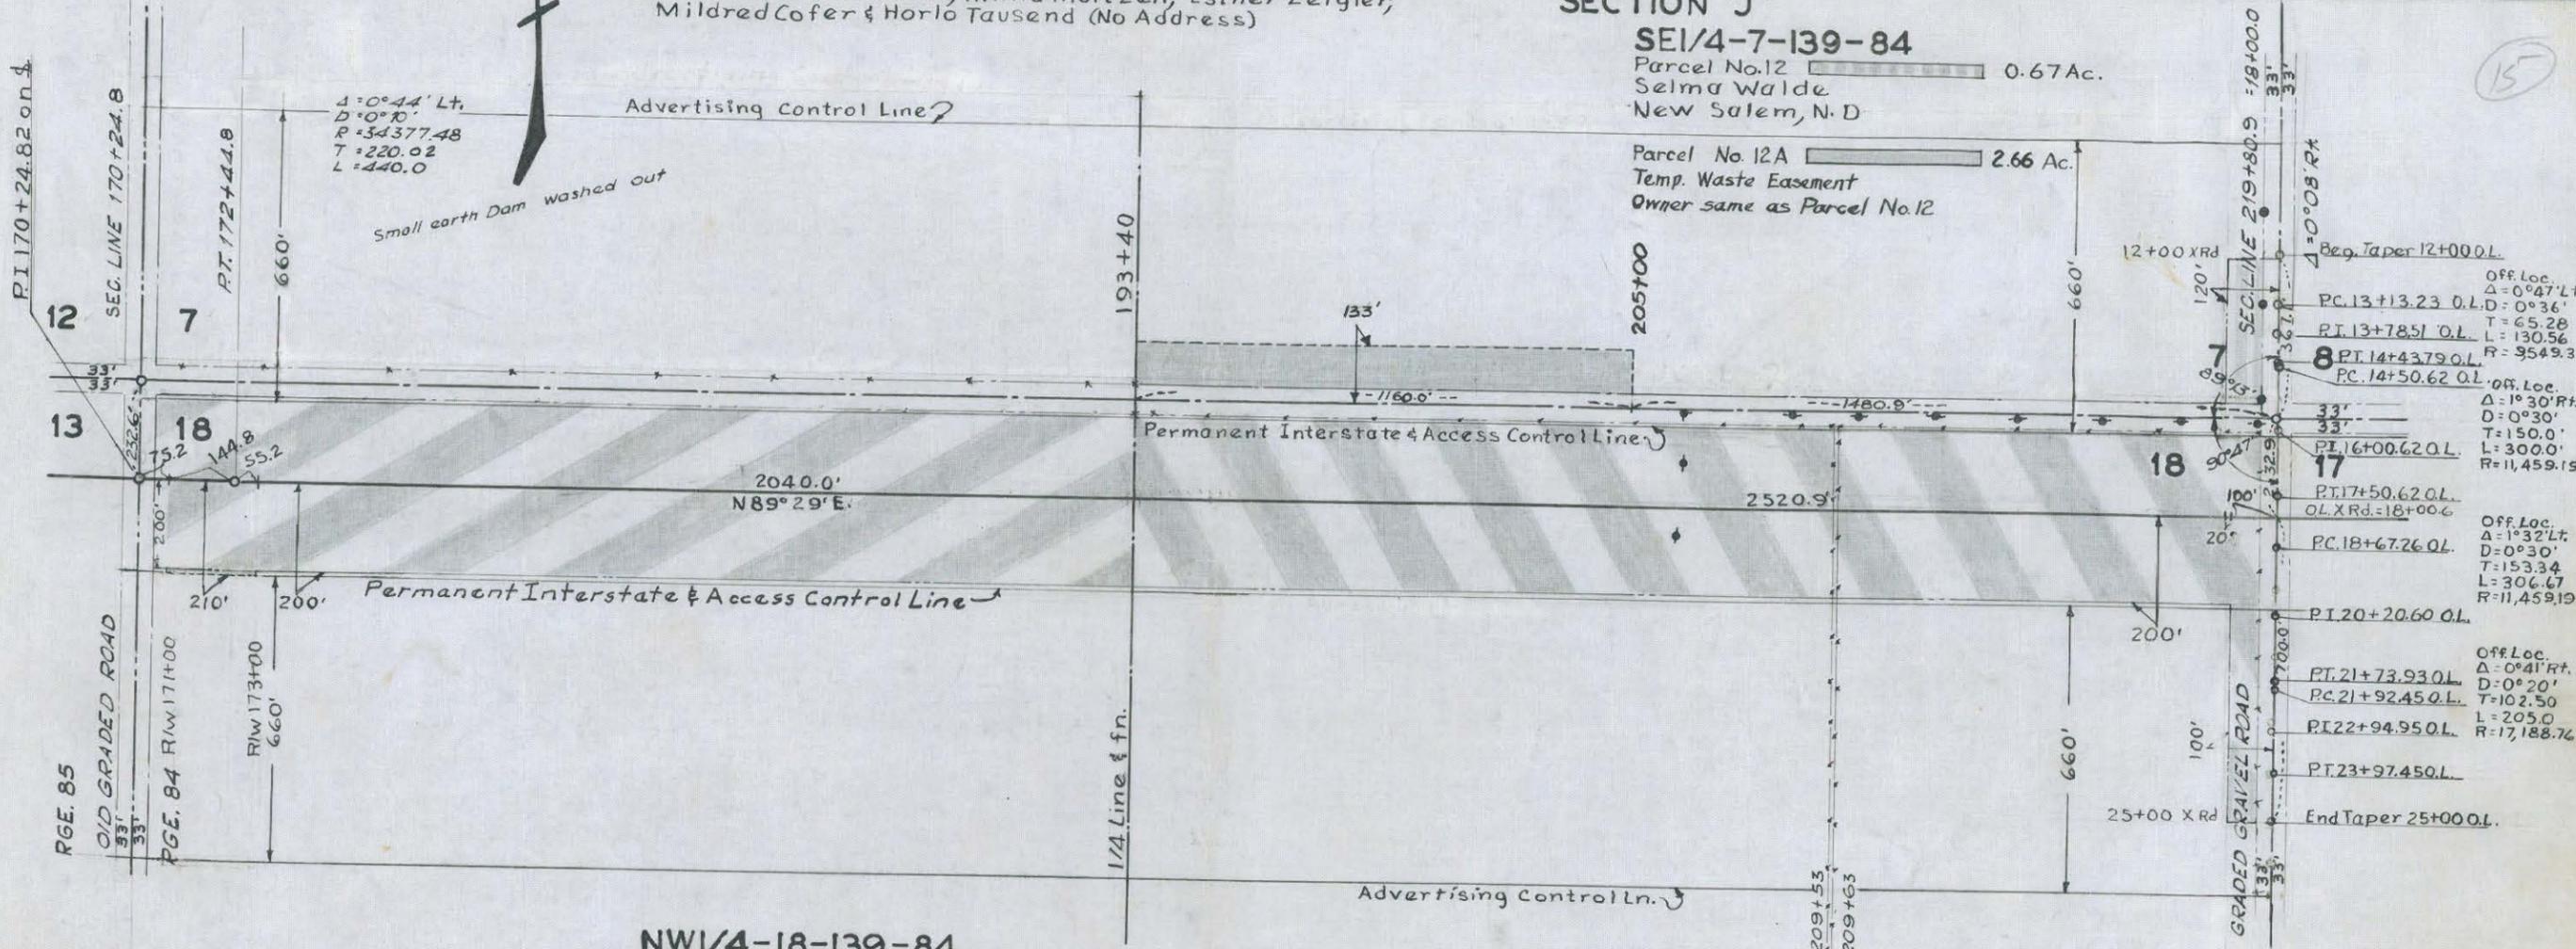

Parcel No. 11

All right and control over the erection, location or maintenance of billboards, signs or any form of advertising whatsoever, upon all that portion of the SW $\frac{1}{4}$ of Sec. 7, Twp. 139 N., Rge. 84 W., in Morton County, North Dakota within 660 feet of the controlled access limits of Project I-IG-94-4(3), Morton County, North Dakota as shown on right of way plats on file in the office of the Register of Deeds of Morton County, North Dakota.

Parcel No. 12

The south 367.1 ft. of the east 120.0 ft. of the SE $\frac{1}{4}$ of Sec. 7, Twp. 139 N., Rge. 84 W., 5th P. M., excepting all that portion lying within 33 feet of the section lines.

Tract contains 0.67 acres, more or less, and is shown on plat as shaded area. Also including all right of access, being the right of ingress to and egress from the remaining property to and from the highway right of way, as shown on the right of way plat.

And including all right and control over the erection, location or maintenance of billboards, signs or any form of advertising whatsoever, upon all that portion of the SE $\frac{1}{4}$ of Sec. 7, Twp. 139 N., Rge. 84 W., in Morton County, North Dakota within 660 feet of the controlled access limits of Project I-IG-94-4(3), Morton County, North Dakota as shown on right of way plats on file in the office of the Register of Deeds of Morton County, North Dakota.

Parcel No. 13

All that portion of the NW $\frac{1}{4}$ of Sec. 18, Twp. 139 N., Rge. 84 W., 5th P. M., lying within a strip of land 200.0 ft. wide, located on the southerly side of and measured at right angles to the following described highway centerline as surveyed and staked:

Beginning at a point 232.9 ft. south and 2640.9 ft. S 89°29'W from the northeast corner of said Section 18, thence running S 89°29'W 2095.2 ft. thence along a 0°10' curve to the right 220.0 ft., more or less, until said strip crosses the west line of said NW $\frac{1}{4}$; also including all that portion lying northerly of the above described highway centerline excepting all that portion lying within 33 feet of the section lines.

Tract contains 20.94 acres, more or less, and is shown on plat as shaded area. Also including all right of access, being the right of ingress to and egress from the remaining property to and from the highway right of way, as shown on the right of way plat.

And including all right and control over the erection, location or maintenance of billboards, signs or any form of advertising whatsoever, upon all that portion of the NW $\frac{1}{4}$ of Sec. 18, Twp. 139 N., Rge. 84 W., in Morton County, North Dakota within 660 feet of the controlled access limits of Project I-IG-94-4(3), Morton County, North Dakota as shown on right of way plats on file in the office of the Register of Deeds of Morton County, North Dakota.

Parcel No. 14

All that portion of the NW $\frac{1}{4}$ of Sec. 18, Twp. 139 N., Rge. 84 W., 5th P. M., lying within a strip of land located on the southerly side of and measured at right angles to the following described highway centerline as surveyed and staked:

Beginning at a point 232.9 ft. south of the northeast corner of said Section 18, where said strip is 200.0 ft. wide, thence running S 89°29'W 4680.9 ft., more or less, to a point where said strip changes to 210.0 ft. in width, thence continuing S 89°29'W 55.2 ft., thence along a 0°10' curve to the right 144.8 ft., more or less, to a point where said strip changes to 200.0 ft. in width, thence continuing along said 0°10' curve 75.2 ft., more or less, until said strip crosses the west line of said Section 18, excepting all that portion lying within 200.0 ft. of the above described highway centerline.

SYSTEM DIST. HWY. AGREEMENT

MILE _____

SECTION J PROJECT NO. I-IG-94-4(3)
SUPPLEMENT TO PLAT NO. 4 OF 22

Parcel No. 14 continued

Tract contains 0.05 acres, more or less, and is shown on plat as shaded area.

Parcel No. 15

All that portion of the NE $\frac{1}{4}$ of Sec. 18, Twp. 139 N., Rge. 84 W., 5th P. M., lying within a strip of land 200.0 ft. wide, located on the southerly side of and measured at right angles to the following described highway centerline as surveyed and staked:

Beginning at a point 232.9 ft. south of the northeast corner of said NE $\frac{1}{4}$; thence running S 89°29'W 2640.9 ft., more or less, until said strip crosses the west line of said NE $\frac{1}{4}$; also including all that portion lying northerly of the above described highway centerline; also all that portion described as follows: The south 500.0 ft. of the north 932.9 ft. of the east 100.0 ft. of the NE $\frac{1}{4}$ excepting all that portion lying within 33 feet of the section lines.

Tract contains 24.71 acres, more or less, and is shown on plat as shaded area. Also including all right of access, being the right of ingress to and egress from the remaining property to and from the highway right of way, as shown on the right of way plat.

And including all right and control over the erection, location or maintenance of billboards, signs or any form of advertising whatsoever, upon all that portion of the NE $\frac{1}{4}$ of Sec. 18, Twp. 139 N., Rge. 84 W., in Morton County, North Dakota within 660 feet of the controlled access limits of Project I-IG-94-4(3), Morton County, North Dakota as shown on right of way plats on file in the office of the Register of Deeds of Morton County, North Dakota.

Parcel No. 12A

The south 133.0 ft. of the west 1160.0 ft. of the SE $\frac{1}{4}$ of Sec. 7, Twp. 139 N., Rge. 84 W., 5th P. M., excepting all that portion lying within 33 feet of the section line.

Tract contains 2.66 acres, more or less, and is shown on plat as shaded area.



SW1/4-8-139-84

Parcel No. 16 0.71 Ac.
Selma Walde
New Salem, North Dakota
Parcel No. 16A 1.84 Ac.
Temp. Waste Easement
Owner same as Parcel No. 16

PROJ. NO.	PARCEL	PLAT NO.	SUPPLEMENTS
I-IG-94-4 (3)	16-18A	5 OF 22	ONE

SECTION "J"

Parcel 18A Eliminated 6-25-63, A.K.

SE1/4-8-139-84

Parcel No. 17 Advertising Control
August E. Rash and Ethel Rash
New Salem, North Dakota

15

DATE 3-5-63

CHECKED BY L.V. Moravitz

DATE 10-29-62


MADE BY P.L. Asplund

Off. Loc. A
Δ: 0°47' Lt.
D: 0°36'
T: 65.28
L: 130.5'
R: 9,549.34
= 18+00.0

Off. Loc. B
Δ: 1°30' Rt.
D: 0°30'
T: 150.0'
L: 300.0'
R: 11,459.19

Off. Loc. C
Δ: 1°32' Lt.
D: 0°30'
T: 153.34
L: 306.67
R: 11,459.19

Off. Loc. D
Δ: 0°41' Rt.
D: 0°20'
T: 102.50
L: 205.0'
R: 17,188.76

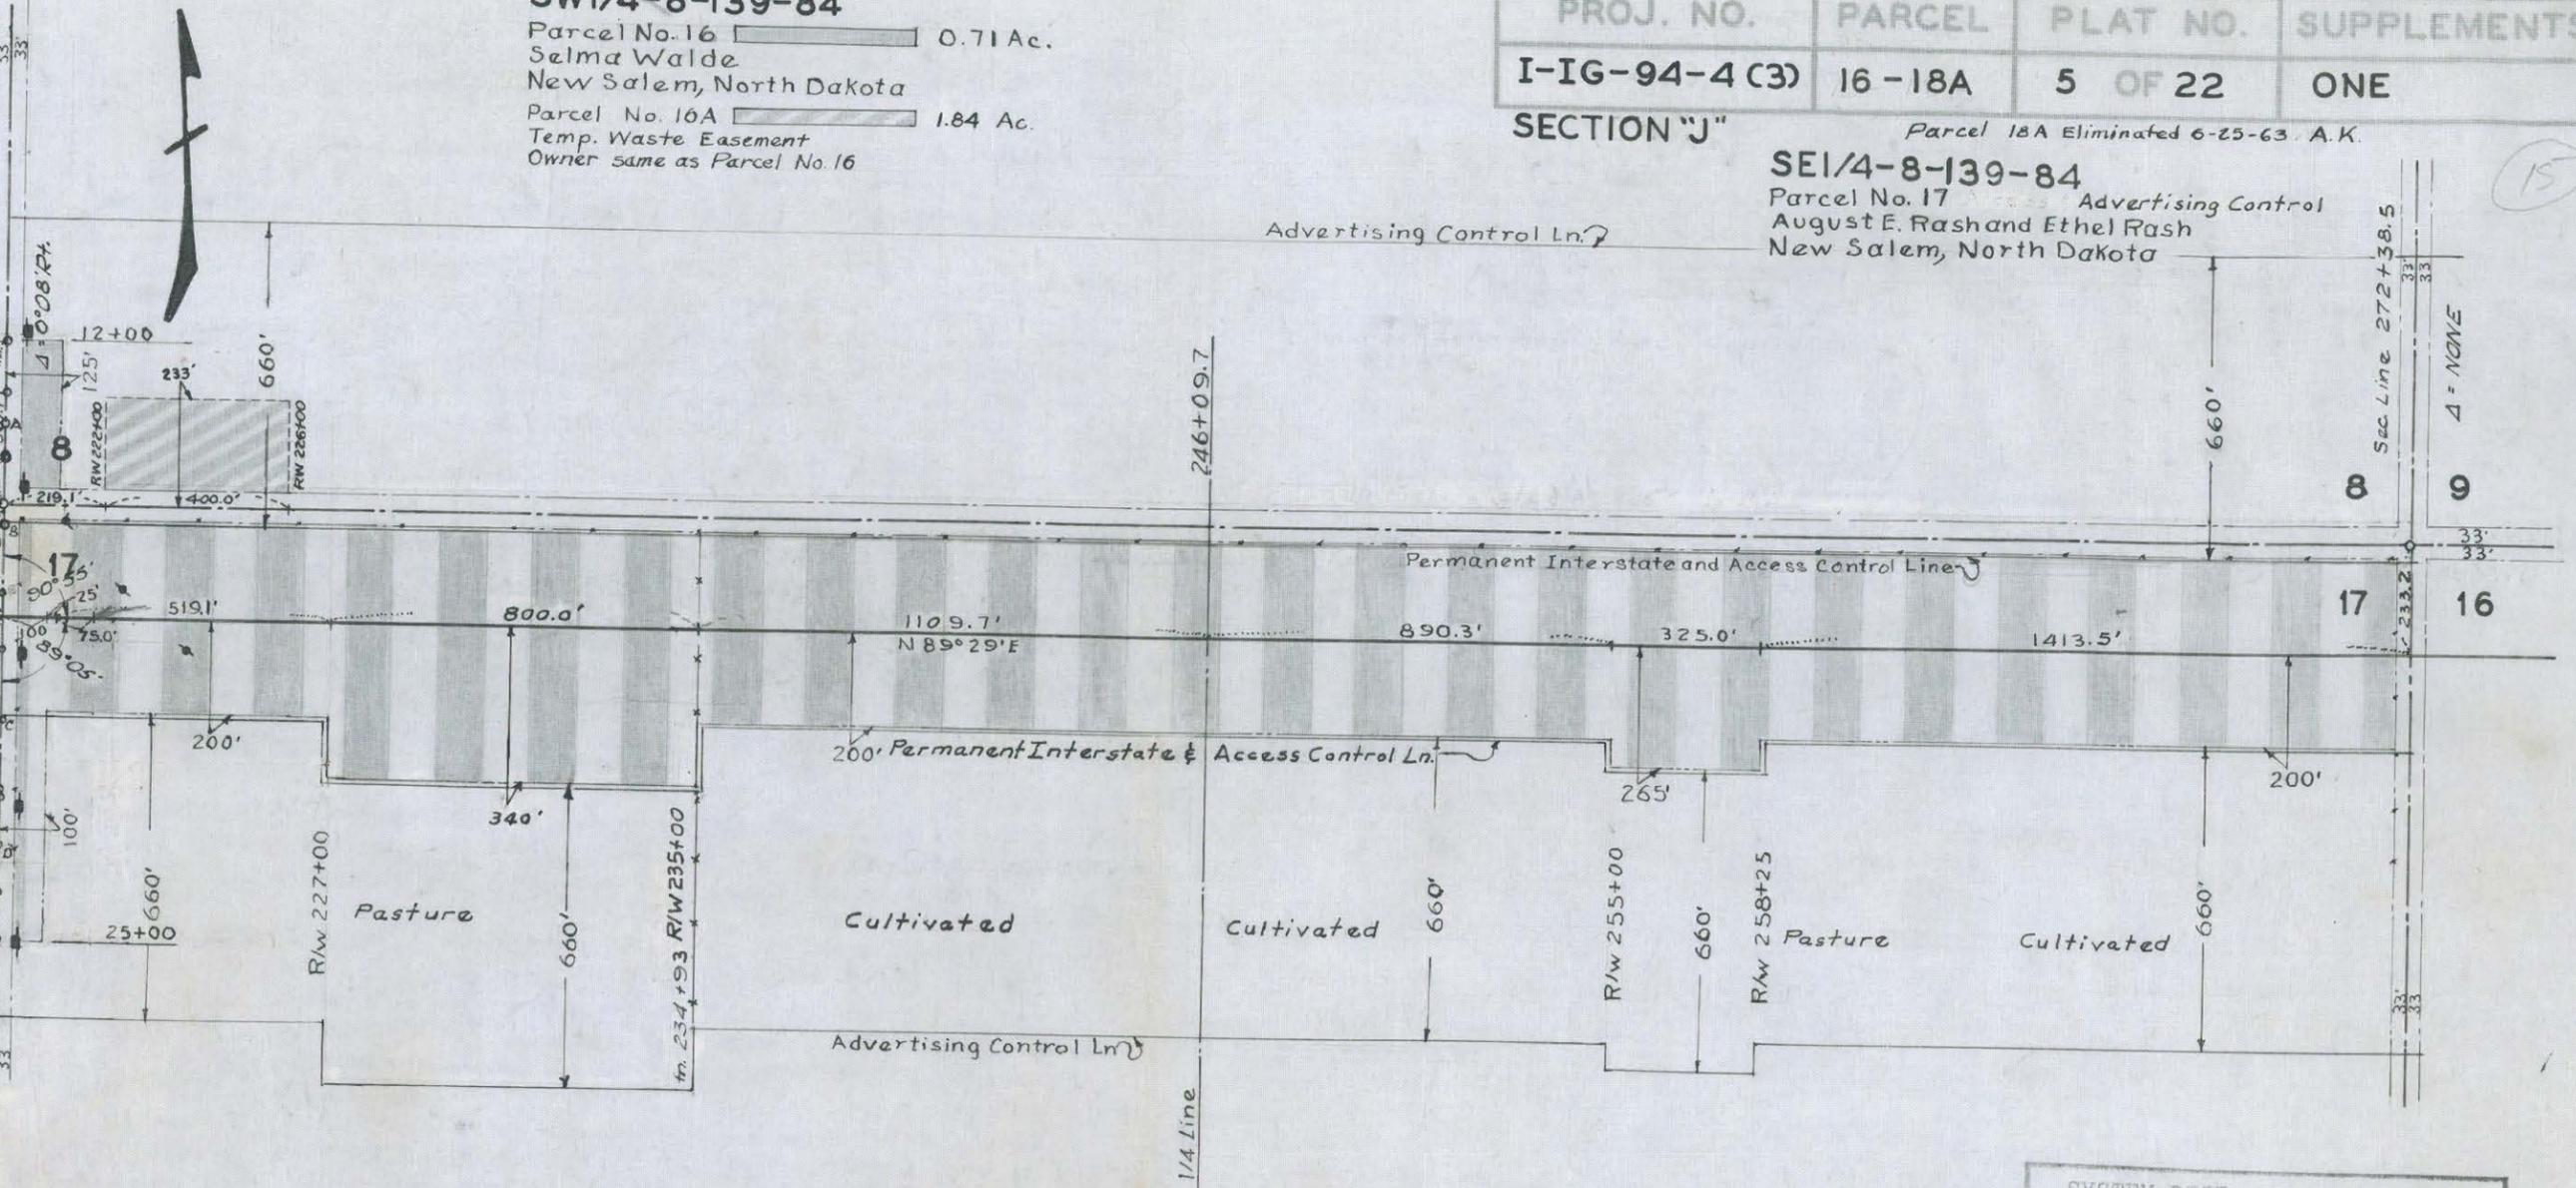

NOTE
INSTALL PIPE CUIVERT
268+65 60" X 232'

NE1/2-17-139-84
Parcel No. 18 51.50 Ac.
Joseph Schaner Jr.
New Salem, North Dakota

SYSTEM DIST. HWY. AGREEMENT

NORTH DAKOTA
STATE HIGHWAY DEPARTMENT

RIGHT OF WAY PLAT

PROJECT NO. I-IG-94-4(3)

MORTON COUNTY

APPROVED *Robert E. King*
RIGHT OF WAY ENGINEER

SCALE 1" = 40'
DATE 7-31-63

This document was originally issued and sealed by Robert E. King, Registration Number LS 1001 on ___/___/___ and the original document is stored at the County Recorders Office

Parcel No. 16

The south 367.1 ft. of the west 125.0 ft. of the SW $\frac{1}{4}$ of Sec. 8, Twp. 139 N., Rge. 84 W., 5th P. M., excepting all that portion lying within 33 feet of the section lines.

Tract contains 0.71 acres, more or less, and is shown on plat as shaded area.

Also including all right of access, being the right of ingress to and egress from the remaining property to and from the highway right of way, as shown on the right of way plat.

And including all right and control over the erection, location or maintenance of billboards, signs or any form of advertising whatsoever, upon all that portion of the SW $\frac{1}{4}$ of Sec. 8, Twp. 139 N., Rge. 84 W., in Morton County, North Dakota within 660 feet of the controlled access limits of Project I-IG-94-4(3), Morton County, North Dakota as shown on right of way plats on file in the office of the Register of Deeds of Morton County, North Dakota.

Parcel No. 17

All right and control over the erection, location or maintenance of billboards, signs or any form of advertising whatsoever, upon all that portion of the SE $\frac{1}{4}$ of Sec. 8, Twp. 139 N., Rge. 84 W., in Morton County, North Dakota within 660 feet of the controlled access limits of Project I-IG-94-4(3), Morton County, North Dakota as shown on the right of way plats on file in the office of the Register of Deeds of Morton County, North Dakota.

Parcel No. 18

All that portion of the N $\frac{1}{2}$ of Sec. 17, Twp. 139 N., Rge. 84 W., 5th P. M., lying within a strip of land located on the southerly side of and measured at right angles to the following described highway centerline as surveyed and staked:

Beginning at a point 232.9 ft. south of the northwest corner of said Section 17, where said strip is 700.0 ft. wide; thence running N 89°29'E 100.0 ft. more or less to a point where said strip changes to 200.0 ft. in width, thence continuing N 89°29'E 619.1 ft. more or less to a point where said strip changes to 340.0 ft. in width, thence continuing N 89°29'E 800.0 ft. more or less to a point where said strip changes to 200.0 ft. in width, thence continuing N 89°29'E 2000.0 ft. more or less to a point where said strip changes to 265.0 ft. in width, thence continuing N 89°29'E 325.0 ft. more or less to a point where said strip changes to 200.0 ft. in width, thence continuing N 89°29'E 1413.5 ft., more or less, until said strip crosses the east line of said Section 17: Also including all that portion lying northerly of the above described highway centerline, excepting all that portion lying within 33 feet of the section lines.

Tract contains 51.50 acres, more or less, and is shown on plat as shaded area.

Also including all right of access, being the right of ingress to and egress from the remaining property to and from the highway right of way, as shown on the right of way plat.

And including all right and control over the erection, location or maintenance of billboards, signs or any form of advertising whatsoever, upon all that portion of the N $\frac{1}{2}$ of Sec. 17, Twp. 139 N., Rge. 84 W., in Morton County, North Dakota within 660 feet of the controlled access limits of Project I-IG-94-4(3), Morton County, North Dakota as shown on the right of way plats on file in the office of the Register of Deeds of Morton County, North Dakota.

SYSTEM DIST. HWY. AGREEMENT

SECTION "J" PROJECT NO. I-IG-94-4(3)

SUPPLEMENT TO PLAT NO. 5 OF 22

MILE _____

~~Parcel No. 16a~~

15

~~And all that portion of the N $\frac{1}{2}$ of Sec. 17, Twp. 139 N., Rge. 84 W., 5th P. M., lying within a strip of land located on the southerly side of and measured at right angles to the following described highway centerline as surveyed and staked: Beginning at a point 232.9 ft. south of the northwest corner of said N $\frac{1}{2}$, where said strip is 200.0 ft. wide, thence running N 89°29'E 100.0 ft., more or less to a point where said strip changes to 700.0 ft. in width, thence continuing N 89°29'E 100.0 ft. more or less to a point where said strip changes to 200.0 ft. in width, thence continuing N 89°29'E until said strip crosses the east line of said N $\frac{1}{2}$, excepting all that portion lying within 200.0 ft. of the above described centerline.~~

~~Tract contains 1.15 acres, more or less, and is shown on plat as shaded area.~~

Parcel No. 16A

The south 233.0 ft. of the east 400.0 ft. of the west 619.1 ft. of the SW $\frac{1}{4}$ of Sec. 8, Twp. 139 N., Rge. 84 W., 5th P. M., excepting all that portion lying within 33 feet of the section line.


Tract contains 1.84 acres, more or less, and is shown on plat as shaded area.

NW 1/4-16-139-84

SI/2-9-139-84
Parcel No. 19 2.73 Ac.
Carl Helbig,
New Salem, N.D.

PROJ. NO.	PARGEL	PLAT NO.	SUPPLEMENTS
I-IG-94-4(3)	19 - 21	6 OF 22	ONE

Parcel No. 19A 4.15 Ac. SECTION "J"
Owner same as Parcel No. 19 Judson Interchange

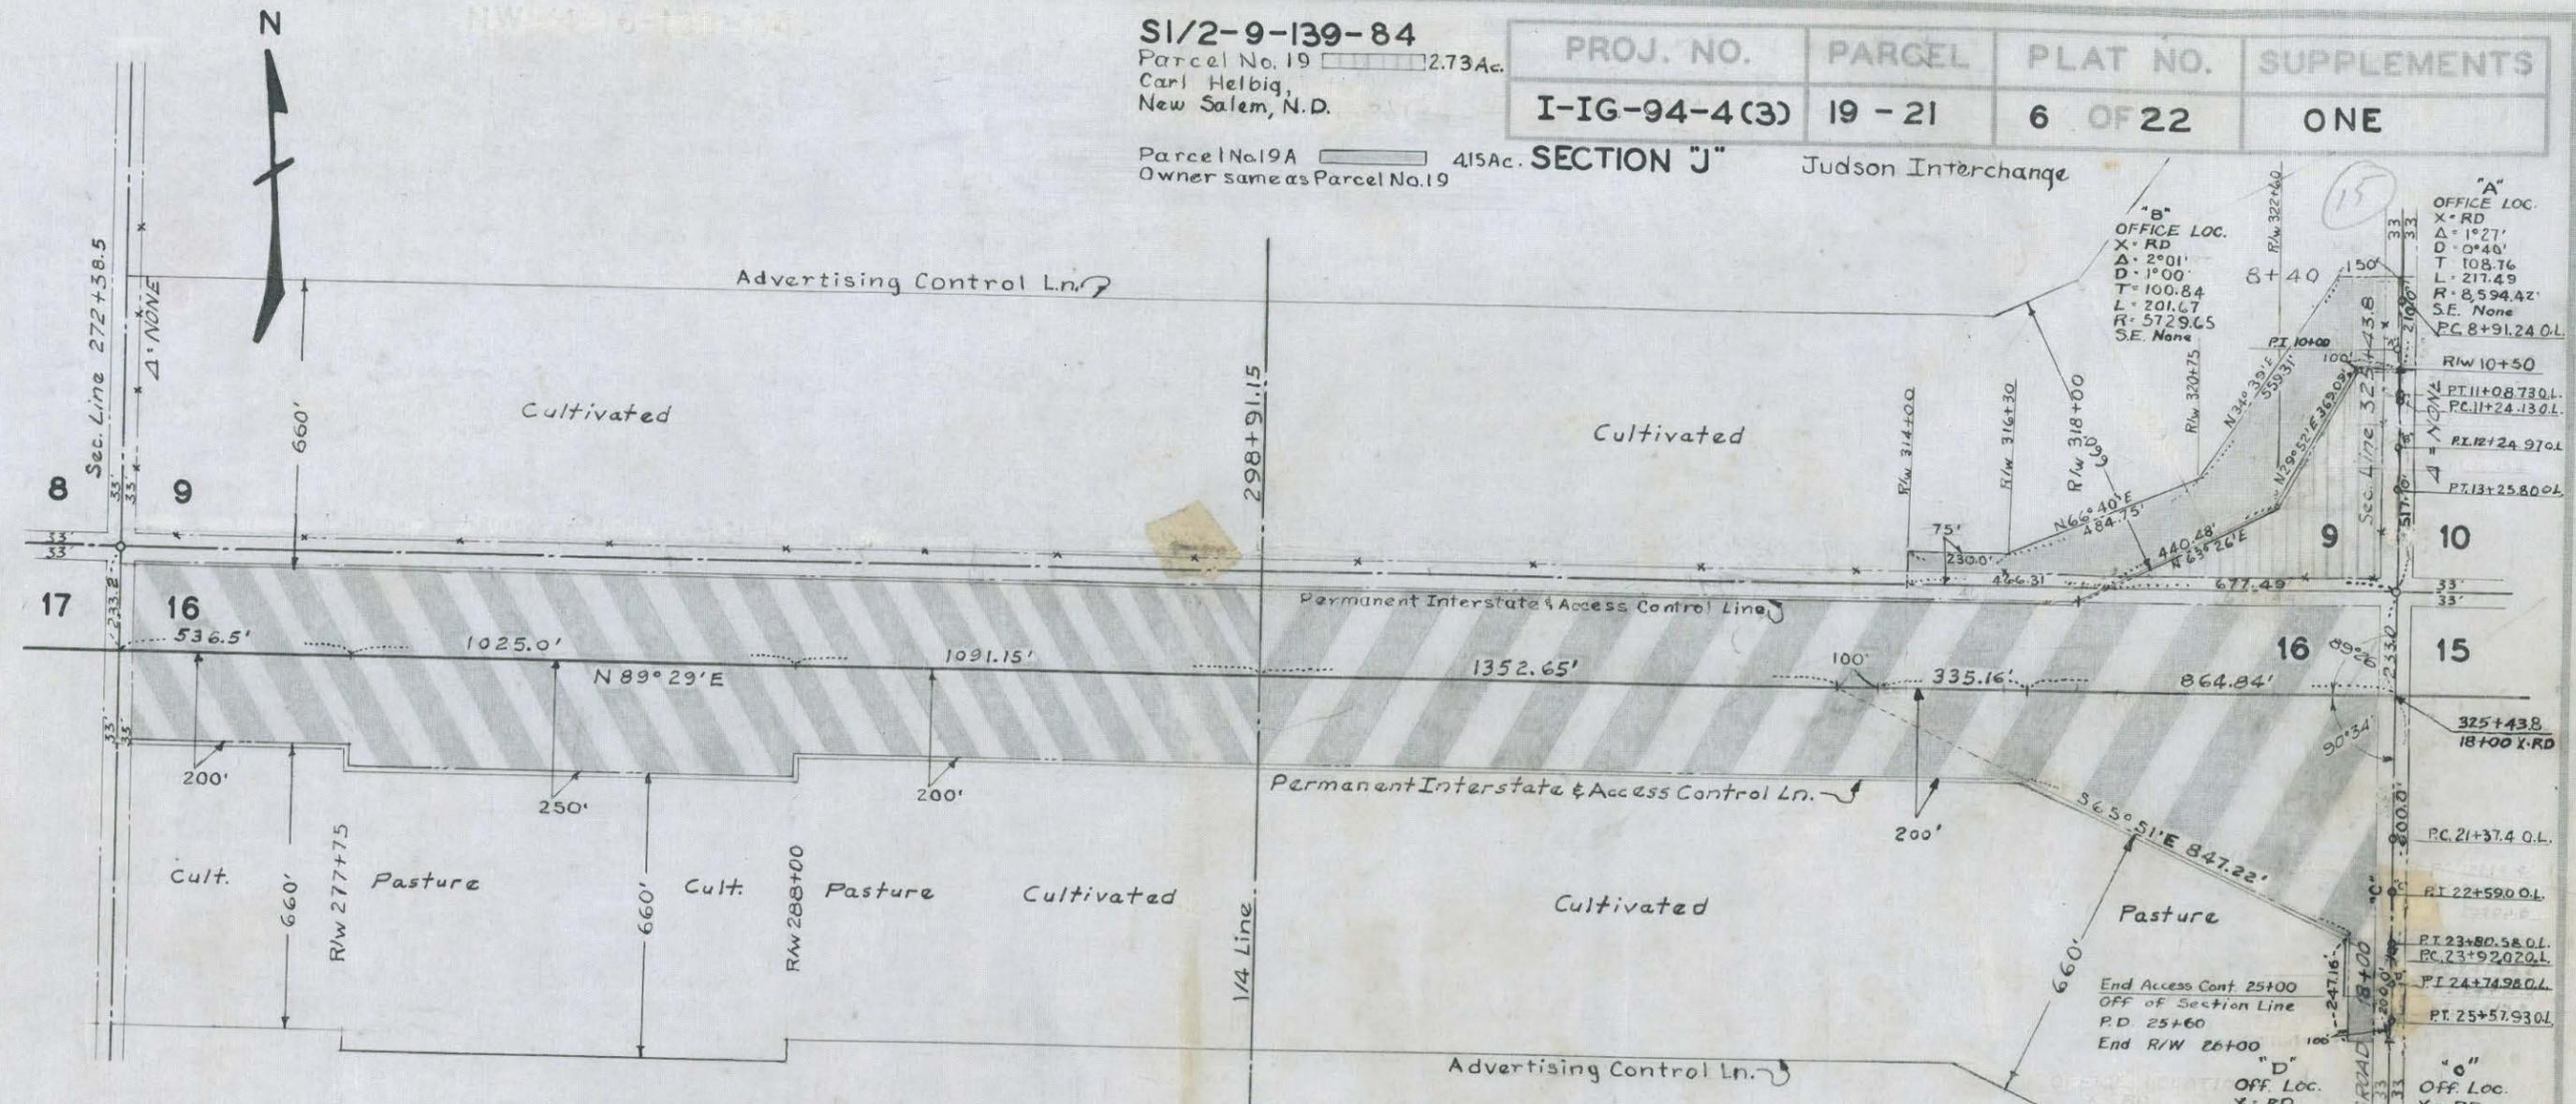

DATE 3-13-63
CHECKED BY L.V. Moravitz
DATE 10-29-62
MADE BY L.E. Christensen

NW 1/4-16-139-84
Parcel No. 20 25.24 Ac.
State of North Dakota

Contract for Deed to
George A. and Gertrude Kunz H/w
New Salem, North Dakota
Contract Assigned to
Wilbert and Delores Kunz H/w
New Salem, North Dakota

NE 1/4-16-139-84
Parcel No. 21 28.09 Ac.
State of North Dakota

Contract for Deed to
Ida Morrelle
New Salem, North Dakota

SYSTEM DIST. HWY. AGREEMENT

MILE _____

This document was originally issued and sealed by Robert E. King, Registration Number LS 1001 on _____ and the original document is stored at the County Recorders Office

NORTH DAKOTA
STATE HIGHWAY DEPARTMENT

RIGHT OF WAY PLAT

PROJECT NO. I-IG-94-4(3)

MORTON COUNTY

APPROVED *Robert E. King*
RIGHT OF WAY ENGINEER

SCALE 1" = 400' DATE 7-31-63

Parcel No. 19

~~A tract of land lying in the S $\frac{1}{2}$ of Sec. 9, Twp. 139 N., Rge. 84 W., 5th P. M., said tract being described as follows:~~

~~Beginning at a point on the southeast corner of said S $\frac{1}{2}$, thence running west along the section line 748.58 ft., thence N 62°48'E 722.33 ft., thence north 409.03 ft., thence east 100.0 ft., thence south along the section line 727.0 ft. more or less to the point of beginning, excepting all that portion lying within 33 feet of the section lines.~~

~~Tract contains 3.19 acres, more or less, and is shown on plat as shaded area.~~

~~Also including all right of access, being the right of ingress to and egress from the remaining property to and from the highway right of way as shown on the right of way plat. And including all right and control over the erection, location or maintenance of billboards, signs or any form of advertising whatsoever, upon all that portion of the S $\frac{1}{2}$ of Sec. 9, Twp. 139 N., Rge. 84 W., in Morton County, North Dakota within 660 feet of the controlled access limits of Project I-IG-94-4(3), Morton County, North Dakota as shown on right of way plats on file in the office of the Register of Deeds of Morton County, North Dakota.~~

Parcel No. 20

All that portion of the NW $\frac{1}{4}$ of Sec. 16, Twp. 139 N., Rge. 84 W., 5th P. M., lying within a strip of land located on the southerly side of and measured at right angles to the following described highway centerline as surveyed and staked:

Beginning at a point 233.2 ft. south of the northwest corner of said Section 16; where said strip is 200.0 ft. wide thence running N 89°29'E 536.5 ft. more or less to a point where said strip changes to 250.0 ft. in width thence continuing N 89°29'E 1025.0 ft. more or less to a point where said strip changes to 200.0 ft. in width, thence continuing N 89°29'E 1091.15 ft. more or less until said strip crosses the east line of said NW $\frac{1}{4}$, also including all that portion lying northerly of the above described highway centerline, excepting all that portion lying within 33 feet of the section lines.

Tract contains 25.24 acres, more or less, and is shown on plat as shaded area.

Also including all right of access, being the right of ingress to and egress from the remaining property to and from the highway right of way as shown on the right of way plat. And including all right and control over the erection, location or maintenance of billboards, signs or any form of advertising whatsoever, upon all that portion of the NW $\frac{1}{4}$ of Sec. 16, Twp. 139 N., Rge. 84 W., in Morton County, North Dakota within 660 feet of the controlled access limits of Project I-IG-94-4(3), Morton County, North Dakota as shown on right of way plats on file in the office of the Register of Deeds of Morton County, North Dakota.

Parcel No. 21

All that portion of the NE $\frac{1}{4}$ of Sec. 16, Twp. 139 N., Rge. 84 W., 5th P. M., lying within a strip of land 200.0 ft. wide, located on the southerly side of and measured at right angles to the following described highway centerline as surveyed and staked:

Beginning at a point 233.0 ft. south of the northeast corner of said NE $\frac{1}{4}$; thence running S 89°29'W 2652.65 ft. more or less until said strip crosses the west line of said NE $\frac{1}{4}$, also including all that portion lying northerly of the above described highway centerline; also including all that portion described as follows: Beginning at a point on the northeast corner of said NE $\frac{1}{4}$, thence running south 1033.0 ft., thence west 100.0 ft., thence north 247.16 ft., thence N 65°51'W until said strip crosses the north line of said NE $\frac{1}{4}$, ^{thence east to the point of beginning} excepting all

SYSTEM DIST. HWY. AGREEMENT

MILE _____

SECTION "J" PROJECT NO. I-IG-94-4 (3)
SUPPLEMENT TO PLAT NO. 6 OF 22

Parcel No. 21 Continued

that portion described in the afore described strip and all that portion lying within 33 feet of the section lines.

Tract contains 28.09 acres, more or less, and is shown on plat as shaded area.

Also including all right of access, being the right of ingress to and egress from the remaining property to and from the highway right of way as shown on right of way plat. And including all right and control over the erection, location or maintenance of billboards, signs or any form of advertising whatsoever, upon all that portion of the NE $\frac{1}{4}$ of Sec. 16, Twp. 139 N., Rge. 84 W., in Morton County, North Dakota within 660 feet of the controlled access limits of Project I-IG-94-4 (3), Morton County, North Dakota as shown on right of way plats on file in the office of the Register of Deeds of Morton County, North Dakota.

Parcel No. 19

A tract of land lying in the S $\frac{1}{2}$ of Sec. 9, Twp. 139 N., Rge. 84 W., 5th P. M., said tract being described as follows:

Beginning at a point on the southeast corner of said S $\frac{1}{2}$, thence running west along the section line 677.49 ft., thence N 63°26'E 440.48 ft., thence N 29°52'E 369.09 ft., thence east 100.0 ft., thence south along the section line 517.0 ft., more or less, to the point of beginning, excepting all that portion lying within 33 feet of the section lines.

Tract contains 2.73 acres, more or less, and is shown on plat as shaded area.

And including all right and control over the erection, location or maintenance of billboards, signs or any form of advertising whatsoever, upon all that portion of the S $\frac{1}{2}$ of Sec. 9, Twp. 139 N., Rge. 84 W., in Morton County, North Dakota within 660 feet of the Controlled Access limits of Project I-IG-94-4(3), Morton County, North Dakota as shown on right of way plats on file in the office of the Register of Deeds of Morton County, North Dakota.

Also including all right of access, being the right of ingress to and egress from the remaining property to and from the highway right of way as shown on the right of way plat.

Parcel No. 19A

A tract of land lying in the S $\frac{1}{2}$ of Sec. 9, Twp. 139 N., Rge. 84 W., 5th P. M., said tract being described as follows:

Beginning at a point 677.49 ft. west along the section line from the southeast corner of said S $\frac{1}{2}$, thence running west 466.31 ft., thence north 75.0 ft., thence east 230.0 ft., thence N 66°40'E 484.75 ft., thence N 34°39'E 559.31 ft., thence east 150.0 ft., thence south 210.0 ft., thence west 100.0 ft., thence S 29°52'W 369.09 ft., thence S 63°26'W 440.48 ft., more or less to the point of beginning, excepting all that portion lying within 33 feet of the section lines. Tract contains 4.15 acres, more or less, and is shown on plat as shaded area.

SI/2-10-139-84


Parcel No. 22 32.92 Ac.
 Joseph John and Lois Wetsch h/w
 Killdeer, North Dakota
 Parcel No. 22A 0.56 Ac.
 Temp. Ch. Ch. Easement
 Owner same as Parcel No. 22
 Parcel No. 22B 0.70 Ac.
 Temp. Waste Easement
 Owner same as Parcel No. 22

Parcel No. 22C 5.51 Ac.
 Temp. Borrow Easement
 North Dakota State Game and Fish Department
 Bismarck, North Dakota

PROJ. NO.	PARCEL	PLAT NO.	SUPPLEMENTS
I-IG-94-4(3)	22-24A	7 OF 22	ONE

SECTION "J" Parcel No. 22C added 8-9-65 Singer

DATE 3-20-63
 CHECKED BY L.V. Moravitz
 DATE 10-30-62
 MADE BY L.E. Christensen

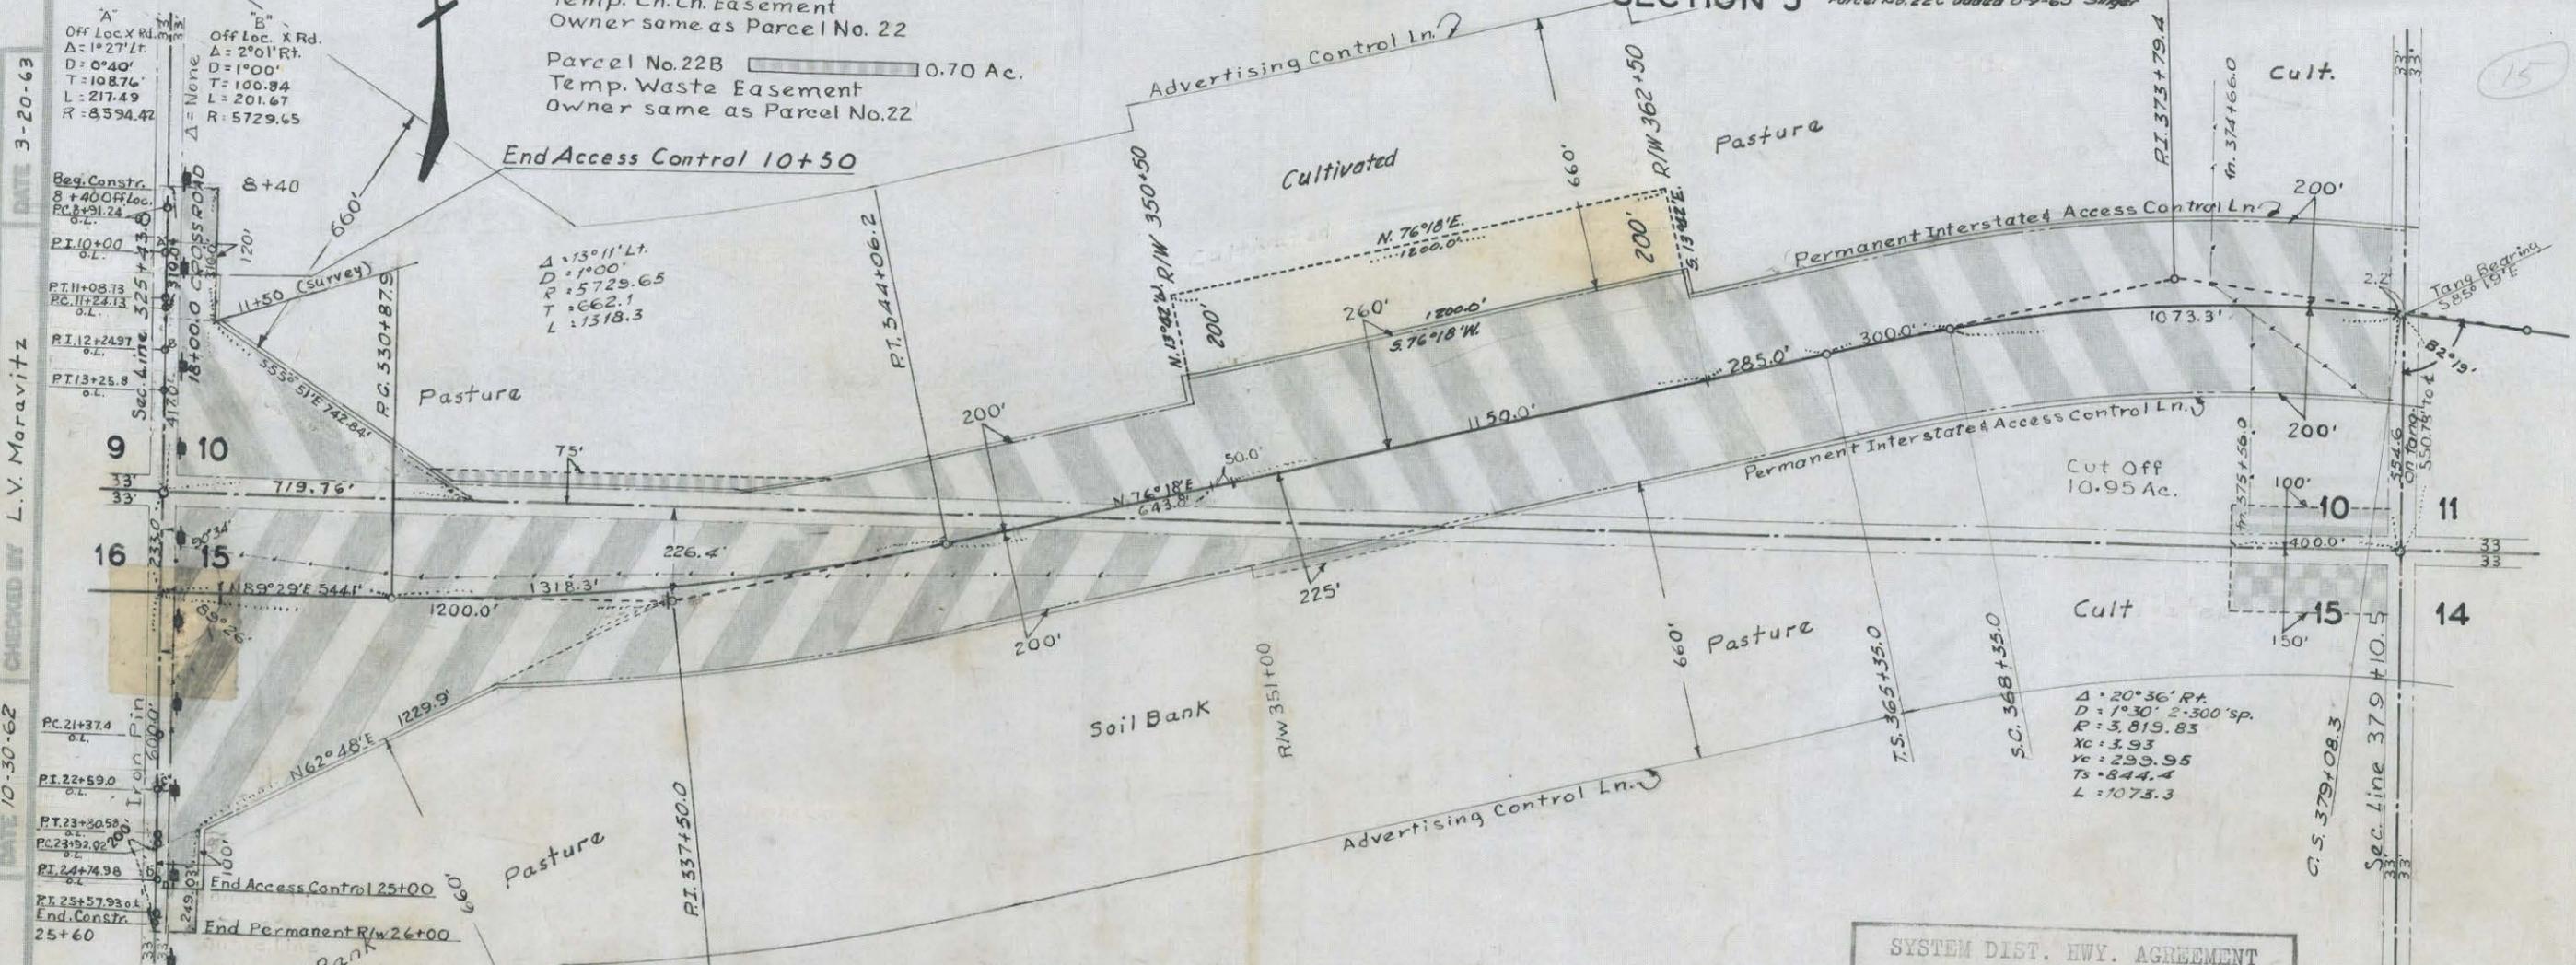

NI/2-15-139-84

Parcel No. 23 21.97 Ac.
 Joseph John and Lois Wetsch h/w
 Killdeer, North Dakota
 Parcel No. 24 0.25 Ac.
 Temp. slope Easement & Permanent Maintenance
 Owner same as Parcel No. 23
 Parcel No. 24A 0.99 Ac.
 Temp. Ch. Ch. Easement
 Owner same as Parcel No. 23

SYSTEM DIST. HWY. AGREEMENT

MILE _____

This document was originally issued and sealed by Robert E. King, Registration Number LS 1001 on _____ and the original document is stored at the County Recorders Office

NORTH DAKOTA
 STATE HIGHWAY DEPARTMENT
RIGHT OF WAY PLAT
 PROJECT NO. I-IG-94-4(3)
 MORTON COUNTY
 APPROVED *Robert E. King*
 RIGHT OF WAY ENGINEER
 SCALE 1" = 400'
 DATE 7-31-63

Parcel No. 22

All that portion of the $S\frac{1}{2}$ of Sec. 10, Twp. 139 N., Rge. 84 W., 5th P. M., lying within a strip of land located on both sides of and measured at right angles to the following described highway centerline as surveyed and staked:

Beginning at a point 550.73 ft. north of the southeast corner of said $S\frac{1}{2}$ where said strip is 400.0 ft. wide lying 200.0 ft. on each side of said highway centerline thence from a tangent bearing of $N 85^{\circ}19'W$ running along a 300 ft. spiral of a $1^{\circ}30'$ curve to the left 2.2 ft., thence along a $1^{\circ}30'$ curve to the left 1073.3 ft., thence along a 300 ft. spiral of a $1^{\circ}30'$ curve to the left 300.0 ft., thence $S 76^{\circ}18'W$ 285.0 ft. more or less to a point where said strip changes to 460.0 ft. in width lying 260.0 ft. on the northerly side and 200.0 ft. on the southerly side, thence continuing $S 76^{\circ}18'W$ 1200.0 ft. more or less to a point where said strip changes to 400.0 ft. in width lying 200.0 ft. on each side of said highway centerline, thence continuing $S 76^{\circ}18'W$ 643.8 ft., thence along a $1^{\circ}00'$ curve to the right until said strip crosses the south line of said $S\frac{1}{2}$, also including all that portion bounded and described as follows: Beginning at a point on the southwest corner of said $S\frac{1}{2}$, thence running north 727.0 ft., thence east 120.0 ft., thence south 310.0 ft., thence $S 55^{\circ}51'E$ 742.84 ft., thence west 719.76 ft. more or less to the point of beginning, excepting all that portion lying within 33 feet of the section lines.

Tract contains 32.92 acres, more or less, and is shown on plat as shaded area.

Also including all right of access, being the right of ingress to and egress from the remaining property to and from the highway right of way as shown on the right of way plat. And including all right and control over the erection, location or maintenance of billboards, signs or any form of advertising whatsoever, upon all that portion of the $S\frac{1}{2}$ of Sec. 10, Twp. 139 N., Rge. 84 W., in Morton County, North Dakota within 660 feet of the controlled access limits of Project I-IG-94-4(3), Morton County, North Dakota as shown on right of way plats on file in the office of the Register of Deeds of Morton County, North Dakota.

Parcel No. 22A

The south 100.0 ft. of the east 400.0 ft. of the $S\frac{1}{2}$ of Sec. 10, Twp. 139 N., Rge. 84 W., 5th P. M., excepting all that portion lying within 33 feet of the section lines.

Tract contains 0.56 acres, more or less, and is shown on plat as shaded area.

Parcel No. 23

All that portion of the $N\frac{1}{2}$ of Sec. 15, Twp. 139 N., Rge. 84 W., 5th P. M., lying within a strip of land 200.0 ft. wide, located on the southerly side of and measured at right angles to the following described highway centerline as surveyed and staked:

Beginning at a point 233.0 ft. south of the northwest corner of said $N\frac{1}{2}$, thence running $N 89^{\circ}29'E$ 544.1 ft., thence along a $1^{\circ}00'$ curve to the left 1318.3 ft., thence $N 76^{\circ}18'E$ until said strip crosses the north line of said $N\frac{1}{2}$, also including all that portion lying northerly of the above described highway centerline. And also including all that portion described as follows: Beginning at a point 233.0 ft. south of the northwest corner of said $N\frac{1}{2}$, said point being the true point of beginning, thence running south 800.0 ft., thence east 100.0 ft., thence north 249.03 ft., thence $N 62^{\circ}48'E$ 1229.9 ft., thence $S 89^{\circ}29'W$ 1200.0 ft. more or less to the point of beginning, excepting all that portion of the afore described strip, excepting all that portion lying within 33 feet of the section lines.

Tract contains 21.97 acres, more or less, and is shown on plat as shaded area.

SYSTEM DIST. HWY. AGREEMENT

FILE _____

SECTION J PROJECT NO. I-IG-94-4 (3)
SUPPLEMENT TO PLAT NO. 7 OF 22

Parcel No. 23 Continued

Also including all right of access, being the right of ingress to and egress from the remaining property to and from the highway right of way as shown on the right of way plat. And including all right and control over the erection, location or maintenance of billboards, signs or any form of advertising whatsoever, upon all that portion of the $N\frac{1}{2}$ of Sec. 15, Twp. 139 N., Rge. 84 W., in Morton County, North Dakota within 660 feet of the controlled access limits of Project I-IG-94-4(3), Morton County, North Dakota as shown on right of way plats on file in the office of the Register of Deeds of Morton County, North Dakota.

Parcel No. 24

All that portion of the $N\frac{1}{2}$ of Sec. 15, Twp. 139 N., Rge. 84 W., 5th P. M., lying within a strip of land located on the southerly side of and measured at right angles to the following described highway centerline as surveyed and staked:

Beginning at a point 233.0 ft. south of the northwest corner of said $N\frac{1}{2}$, where said strip is 200.0 ft. wide, thence running $N 89^{\circ}29'E$ 544.1 ft., thence along a $1^{\circ}00'$ curve to the left 1318.3 ft., thence $N 76^{\circ}18'E$ 693.8 ft. more or less to a point where said strip changes to 225.0 ft. in width, thence continuing $N 76^{\circ}18'E$ until said strip crosses the north line of said $N\frac{1}{2}$, excepting all that portion lying within 200.0 ft. of the above described highway centerline, excepting all that portion lying within 33 feet of the section line.

Tract contains 0.25 acres, more or less, and is shown on plat as shaded area.

Parcel No. 24A

The north 150.0 ft. of the east 400.0 ft. of the $N\frac{1}{2}$ of Sec. 15, Twp. 139 N., Rge. 84 W., 5th P. M., excepting all that portion lying within 33 feet of the section lines.

Tract contains 0.99 acres, more or less, and is shown on plat as shaded area.

Parcel No. 22B

The south 75.0 ft. of the $SW\frac{1}{4}$ of Sec. 10, Twp. 139 N., Rge. 84 W., 5th P. M., excepting all that portion lying within 33 feet of the section line.

Tract contains 0.70 acres, more or less, and is shown on plat as shaded area.

Parcel No. 22C

A tract of land lying in the $S\frac{1}{2}$ of Sec. 10, Twp. 139 N., Rge. 84 W., 5th P. M., said tract being described as follows:

Beginning on the section line 233.0 ft. south ^{thence} 544.1 ft. $N 89^{\circ}29'E$ thence 1318.3 ft. along a $1^{\circ}00'$ curve to the left 260.0 ft. thence 643.8 ft. $N 76^{\circ}18'E$ thence 260.0 ft. $N 13^{\circ}42'W$ from the southwest corner of said Section 10, said point being the true point of beginning: thence continuing $N 13^{\circ}42'W$ 200.0 ft., thence $N 76^{\circ}18'E$ 1200.0 ft., thence $S 13^{\circ}42'E$ 200.0 ft., thence $S 76^{\circ}18'W$ 1200.0 ft., more or less, to the point of beginning.

Tract contains 5.51 acres more or less, and is shown on plat as shaded area.

PROJ. NO.	PARCEL	PLAT NO.	SUPPLEMENTS
I-IG-94-4(3)	25-28	8 OF 22	ONE

SECTION "J"

SE1/4-11-139-84
Parcel No. 26 15.71A
Carland Anna Schneider
New Salem, North Dakota

SW1/4-11-139-84
Parcel No. 25 30.39 Ac.
Joseph John and Lois Wetsch
Killdeer, North Dakota
Parcel No. 25A 1.19 Ac.
Permanent Waste & Stock Pile Easement
Owner same as Parcel No. 25


NE1/4-14-139-84
Parcel No. 23 8.61 Ac.
Earl L. Smith and Walter E. Smith
No Addresses of record
Parcel No. 28A 3.76 Ac.
Outlet Road
Owner same as Parcel No. 28

NI/2 NW1/4-14-139-84
Parcel No. 27 Advertising Control
Anna Schneider
New Salem, North Dakota

Off. Loc. "A" Off. Loc. "B"
A: 0°42'49" Rt. Δ: 1°19'49"
D: 0°20' Rt. D: 0°24' Lt.
T: 107.04' T: 166.29'
L: 214.09' L: 332.57'
R: 1188.76 R: 1432397

PC. 8+03.37 O.L.
End Taper 8+50
PT. 9+10.41 O.L.
PT. 10+17.46 O.L.
PT. 11+83.75 O.L.
PT. 12+50.03 O.L.
15+00 X Rd.
RC. 17+92.49 O.L.
PT. 20+00 O.L.
PT. 22+07.49 O.L.
RC. 22+84.98 O.L.
PT. 23+99.98 O.L.
PT. 25+14.98 O.L.
End Taper 25+50

Off. Loc. "C" Off. Loc. "D"
A: 1°23' Rt. Δ: 0°46' Lt.
D: 0°20' D: 0°20'
T: 207.51 T: 115.0'
L: 415.0' L: 230.0'
R: 1188.76 R: 17188.76

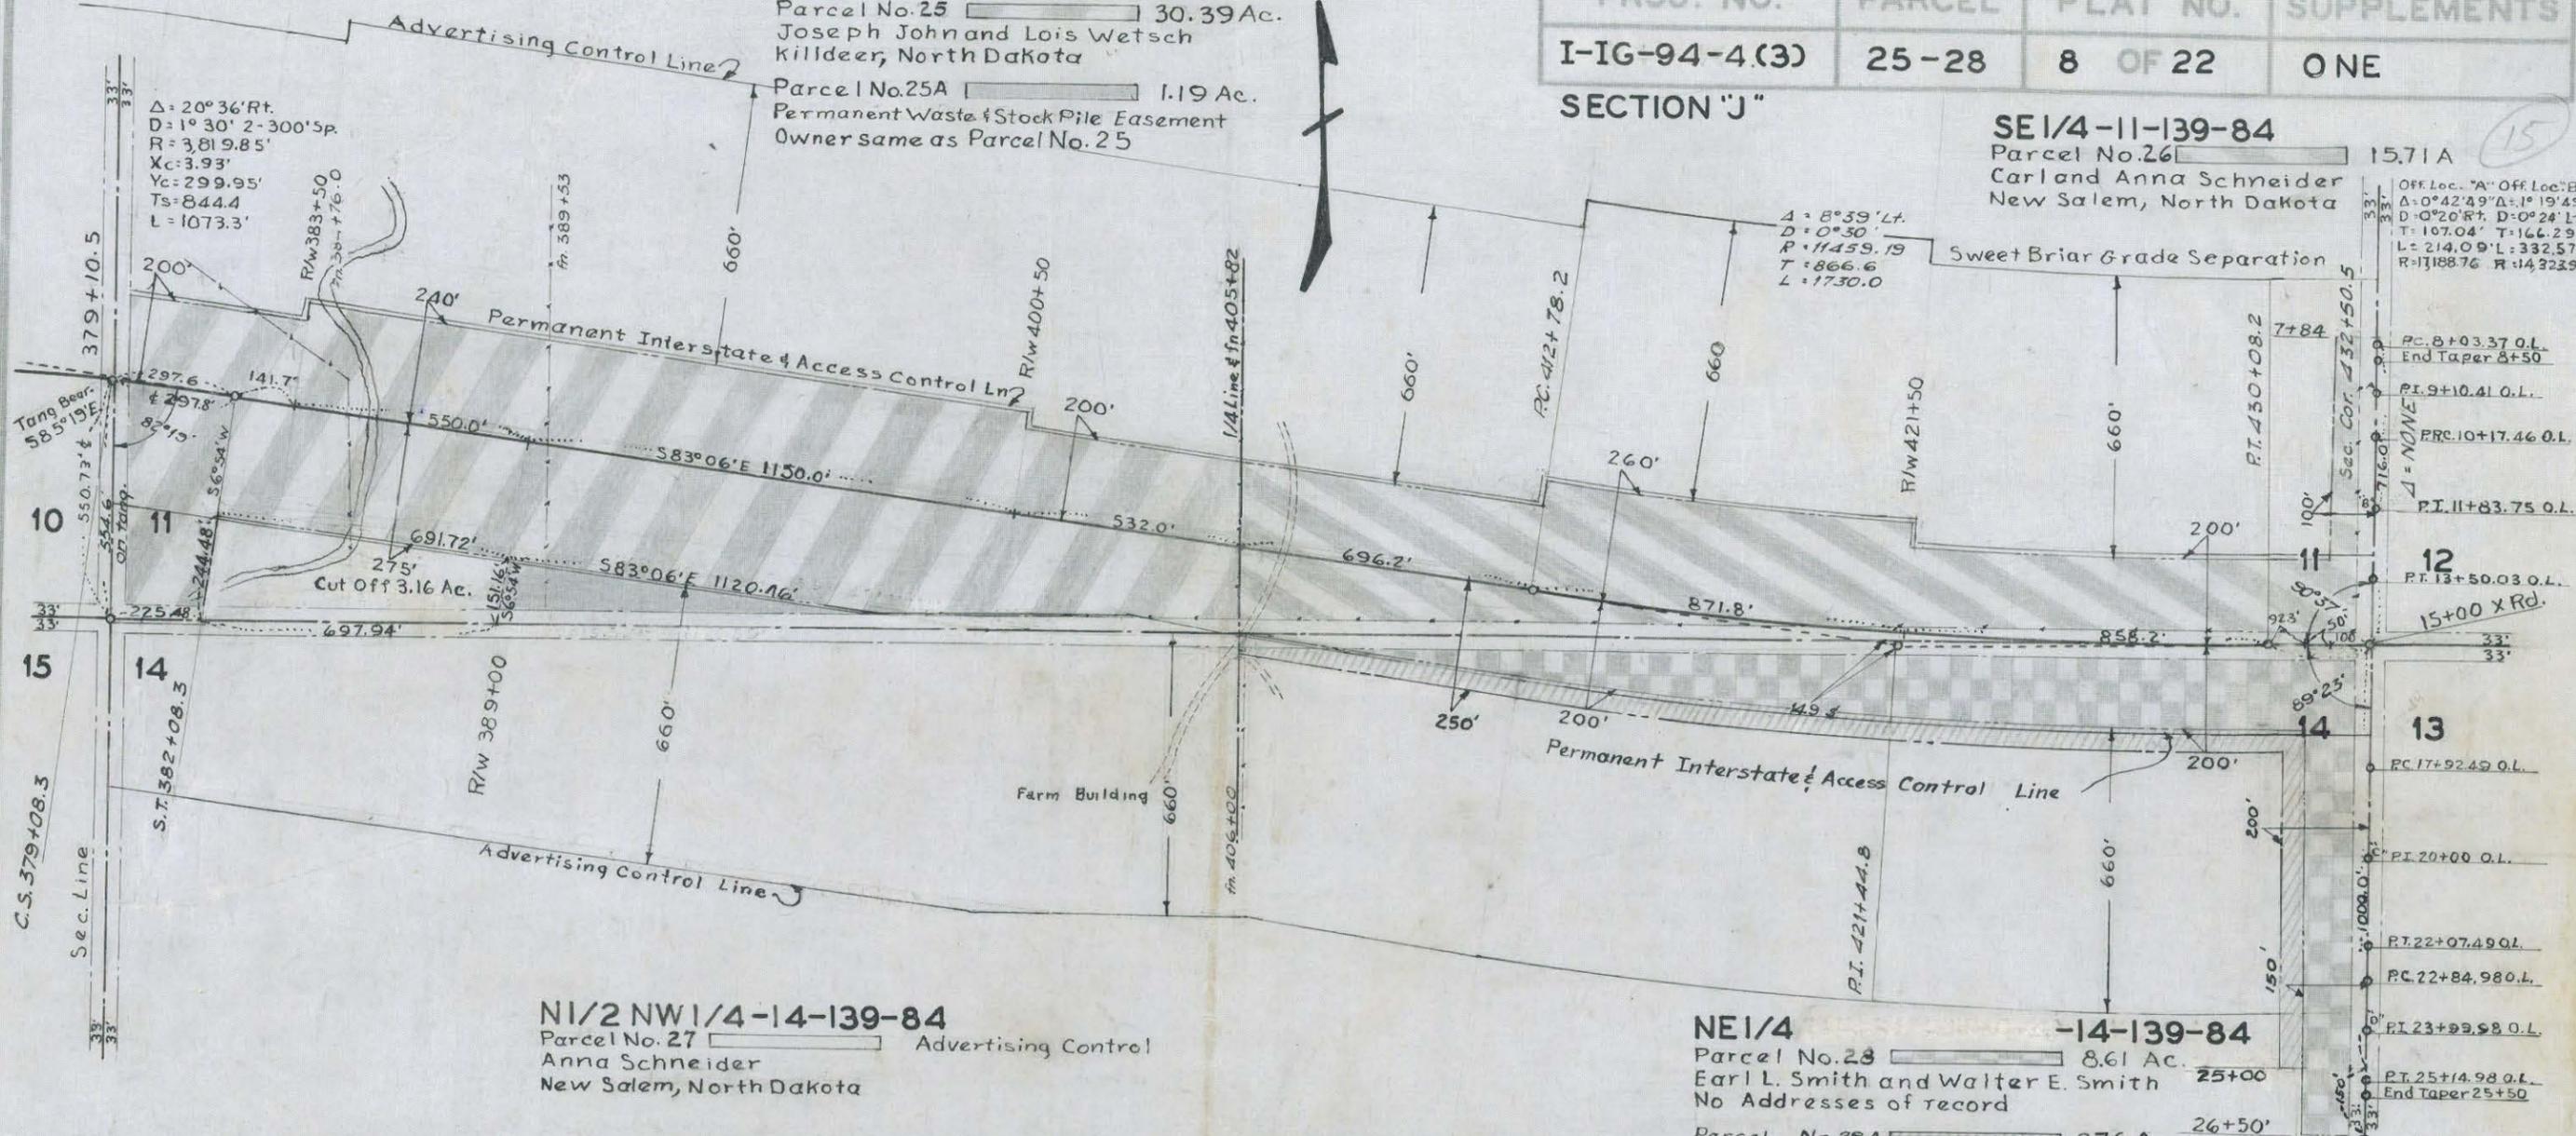

SYSTEM DIST. HWY. AGREEMENT

MILE _____

This document was originally issued and sealed by Robert E. King, Registration Number LS 1001 on ___/___/___ and the original document is stored at the County Recorders Office

NORTH DAKOTA
STATE HIGHWAY DEPARTMENT
RIGHT OF WAY PLAT
PROJECT NO. I-IG-94-4(3)
MORTON COUNTY
APPROVED *Robert E. King*
RIGHT OF WAY ENGINEER
SCALE 1" = 400' DATE 7-31-63

MADE BY L.E. Christensen
DATE 4-2-63
CHECKED BY J.W.S.
DATE 5-22-63

Parcel No. 25

All that portion of the SW $\frac{1}{4}$ of Sec. 11, Twp. 139 N., Rge. 84 W., 5th P. M., lying within a strip of land located on the northerly side of and measured at right angles to the following described highway centerline as surveyed and staked:

Beginning at a point 550.73 ft. north of the southwest corner of said SW $\frac{1}{4}$ where said strip is 200.0 ft. wide, thence from a tangent bearing of S 85°19'E running along a 300 ft. spiral of a 1°30' curve to the right 297.8 ft., thence S 83°06'E 141.7 ft. more or less to a point where said strip changes to 240.0 ft. in width, thence continuing S 83°06'E 1700.0 ft. more or less to a point where said strip changes to 200.0 ft. in width, thence continuing S 83°06'E 532.0 ft. more or less until said strip crosses the east line of said SW $\frac{1}{4}$. Also including all that portion lying southerly of the above described highway centerline, excepting all that portion bounded and described as follows; beginning at a point 225.48 ft. east of the southwest corner of said SW $\frac{1}{4}$, thence running east 1828.53 ft., thence N 83°06'W 1812.18 ft., thence S 6°54'W 244.48 ft. more or less to the point of beginning and all that portion lying within 33 feet of the section lines.

Tract contains 30.39 acres, more or less, and is shown on plat as shaded area.

Also including all right of access, being the right of ingress to and egress from the remaining property to and from the highway right of way as shown on the right of way plat. And including all right and control over the erection, location or maintenance of billboards, signs or any form of advertising whatsoever, upon all that portion of the SW $\frac{1}{4}$ of Sec. 11, Twp. 139 N., Rge. 84 W., in Morton County, North Dakota within 660 feet of the controlled access limits of Project I-IG-94-4(3), Morton County, North Dakota as shown on right of way plats on file in the office of the Register of Deeds of Morton County, North Dakota.

Parcel No. 25A

A tract of land lying in the SW $\frac{1}{4}$ of Sec. 11, Twp. 139 N., Rge. 84 W., 5th P. M., said tract being described as follows:

Beginning at a point 923.42 ft. east of the southwest corner of said SW $\frac{1}{4}$, thence running N 6°54'E 151.16 ft., thence S 83°06'E 1120.46 ft., thence west along the section line 1130.59 ft. more or less to the point of beginning.

Tract contains 1.19 acres, more or less, and is shown on plat as shaded area.

Parcel No. 26

All that portion of the SE $\frac{1}{4}$ of Sec. 11, Twp. 139 N., Rge. 84 W., 5th P. M., lying within a strip of land located on the northerly side of and measured at right angles to the following described highway centerline as surveyed and staked:

Beginning at a point on the southeast corner of said SE $\frac{1}{4}$ where said strip is 716.0 ft. wide, thence running west along the section line 100.0 ft. more or less to a point where said strip changes to 200.0 ft. in width, thence continuing west along the section line 142.3 ft., thence along a 0°30' curve to the right 858.2 ft. more or less to a point where said strip changes to 260.0 ft. in width, thence continuing along said 0°30' curve to the right 871.8 ft. more or less to a point where said strip changes to 200.0 ft. in width, thence N 83°06'W 696.2 ft. more or less until said strip crosses the west line of said SE $\frac{1}{4}$, also including all that portion lying southerly of the above described centerline, excepting all that portion lying within 33 feet of the section lines.

Tract contains 15.71 acres, more or less, and is shown on plat as shaded area.

Also including all right of access, being the right of ingress to and egress from the remaining property to and from the highway right of way as shown on the right of way plat. And including all right and control over the erection, location or maintenance of billboards, signs or any form of advertising whatsoever,

SYSTEM DIST. HWY. AGREEMENT

SECTION "J" PROJECT NO. I-IG-94-4 (3)
SUPPLEMENT TO PLAT NO. 8 OF 22

Parcel No. 26 Continued

upon all that portion of the SE $\frac{1}{4}$ of Sec. 11, Twp. 139 N., Rge. 84 W., in Morton County, North Dakota within 660 feet of the controlled access limits of Project I-IG-94-4(3), Morton County, North Dakota as shown on right of way plats on file in the office of the Register of Deeds of Morton County, North Dakota.

Parcel No. 27

All right and control over the erection, location or maintenance of billboards, signs or any form of advertising whatsoever, upon all that portion of the NE $\frac{1}{4}$ of Sec. 14, Twp. 139 N., Rge. 84 W., in Morton County, North Dakota within 660 feet of the controlled access limits of Project I-IG-94-4(3), Morton County, North Dakota as shown on right of way plats on file in the office of the Register of Deeds of Morton County, North Dakota.

Parcel No. 28

All that portion of the NE $\frac{1}{4}$ of Sec. 14, Twp. 139 N., Rge. 84 W., 5th P. M., lying within a strip of land located on the southerly side of and measured at right angles to the following described highway centerline as surveyed and staked:

Beginning at a point on the northeast corner of said NE $\frac{1}{4}$, where said strip is 1150.0 ft. wide, thence running west along the section line 150.0 ft. more or less to a point where said strip changes to 200.0 ft. in width, thence continuing west along the section line 92.3 ft., thence along a 0°30' curve to the right until said strip crosses the north line of said NE $\frac{1}{4}$, excepting all that portion lying within 33 feet of the section lines.

Tract contains 8.61 acres, more or less, and is shown on plat as shaded area.

Also including all right of access, being the right of ingress to and egress from the remaining property to and from the highway right of way as shown on the right of way plat. And including all right and control over the erection, location or maintenance of billboards, signs or any form of advertising whatsoever, upon all that portion of the NE $\frac{1}{4}$ of Sec. 14, Twp. 139 N., Rge. 84 W., in Morton County, North Dakota within 660 feet of the controlled access limits of Project I-IG-94-4(3), Morton County, North Dakota as shown on right of way plats on file in the office of the Register of Deeds of Morton County, North Dakota.

Parcel No. 28A

All that portion of the NE $\frac{1}{4}$ of Sec. 14, Twp. 139 N., Rge. 84 W., 5th P. M., lying within a strip of land 250.0 ft. wide, located on the southerly side of and measured at right angles to the following described highway centerline as surveyed and staked:

Beginning at a point 150.0 ft. west along the section line from the northeast corner of said NE $\frac{1}{4}$, thence running west along the section line 92.3 ft., thence along a 0°30' curve to the right 1730.0 ft., thence N 83°06'W until said strip crosses the west line of said NE $\frac{1}{4}$, excepting all that portion lying within 200.0 ft. of the above described centerline, also including the south 750.0 ft. of the north 1000.0 ft. of the west 50.0 ft. of the east 200.0 ft. of said NE $\frac{1}{4}$, excepting all that portion lying within 33 feet of the section line.

Tract contains 3.76 acres, more or less, and is shown on plat as shaded area.

15

SW1/4-12-139-84

Parcel No. 29 10.75 Ac.
Earl L. Smith and Walter E. Smith
each an equal undivided 1/2 interest

PROJ. NO.	PARCEL	PLAT NO.	SUPPLEMENTS
I-IG-94-4 (3)	29 - 32	9 OF 22	ONE

SECTION "J" SE1/4-12-139-84 Eliminated Parcel No. 33 L.C.

Parcel No. 30 9.98 Ac.
Waldemar J. and Adella Matthiesen H/W
Judson, North Dakota

Contract for Deed to
Edwin H. and Lucy Kobs
Center, N.D.

NW1/4-13-139-84

Parcel No. 31 13.06 Ac.
Selma Gappert Becker
New Salem, North Dakota

Contract for Deed with
Edwin G. Becker
Judson, North Dakota

Parcel No. 31A 3.68 Ac.
Outlet Road
Owner same as Parcel No. 31

NE1/4-13-139-84

Parcel No. 32 10.06 Ac.
E. H. Kobs
Judson North Dakota

SYSTEM DIST. HWY. AGREEMENT	
MILE	

NORTH DAKOTA
STATE HIGHWAY DEPARTMENT

RIGHT OF WAY PLAT

PROJECT NO. I-IG-94-4 (3)

MORTON COUNTY

APPROVED *Robert E. King*
RIGHT OF WAY ENGINEER

SCALE 1" = 400'

DATE 7-31-63

This document was originally issued and sealed by Robert E. King, Registration Number LS 1001 on ___/___/___ and the original document is stored at the County Recorders Office



Sweet Briar Grade Separation

Advertising Control Line

Permanent Interstate & Access Control Line

Permanent Interstate & Access Control Line

Advertising Control Line

NOTE
INSTALL STRUCTURAL PLATE PIPE ARCH
443 + 50 ± 96" X 6'5" X 178'

DATE 5-24-63

CHECKED BY J.W.B.

DATE 4-3-63


MADE BY L.E. Christensen

Off. Loc. "A"
Δ = 0°42'49"
D = 0°20' Rt.
T = 107.04
L = 214.09
R = 17,188.76

Off. Loc. "B"
Δ = 1°19'49"
D = 0°24' Lt.
T = 166.29
L = 332.57
R = 14,323.97
PC 8 + 03.37
End Taper
B + 50
PI 9 + 10.41

Off. Loc. "C"
Δ = 1°23' Rt.
D = 0°20'
T = 207.51
L = 415.0
R = 17,188.76

Off. Loc. "D"
Δ = 0°46'
D = 0°20'
T = 115.0
L = 230.0
R = 17,188.76

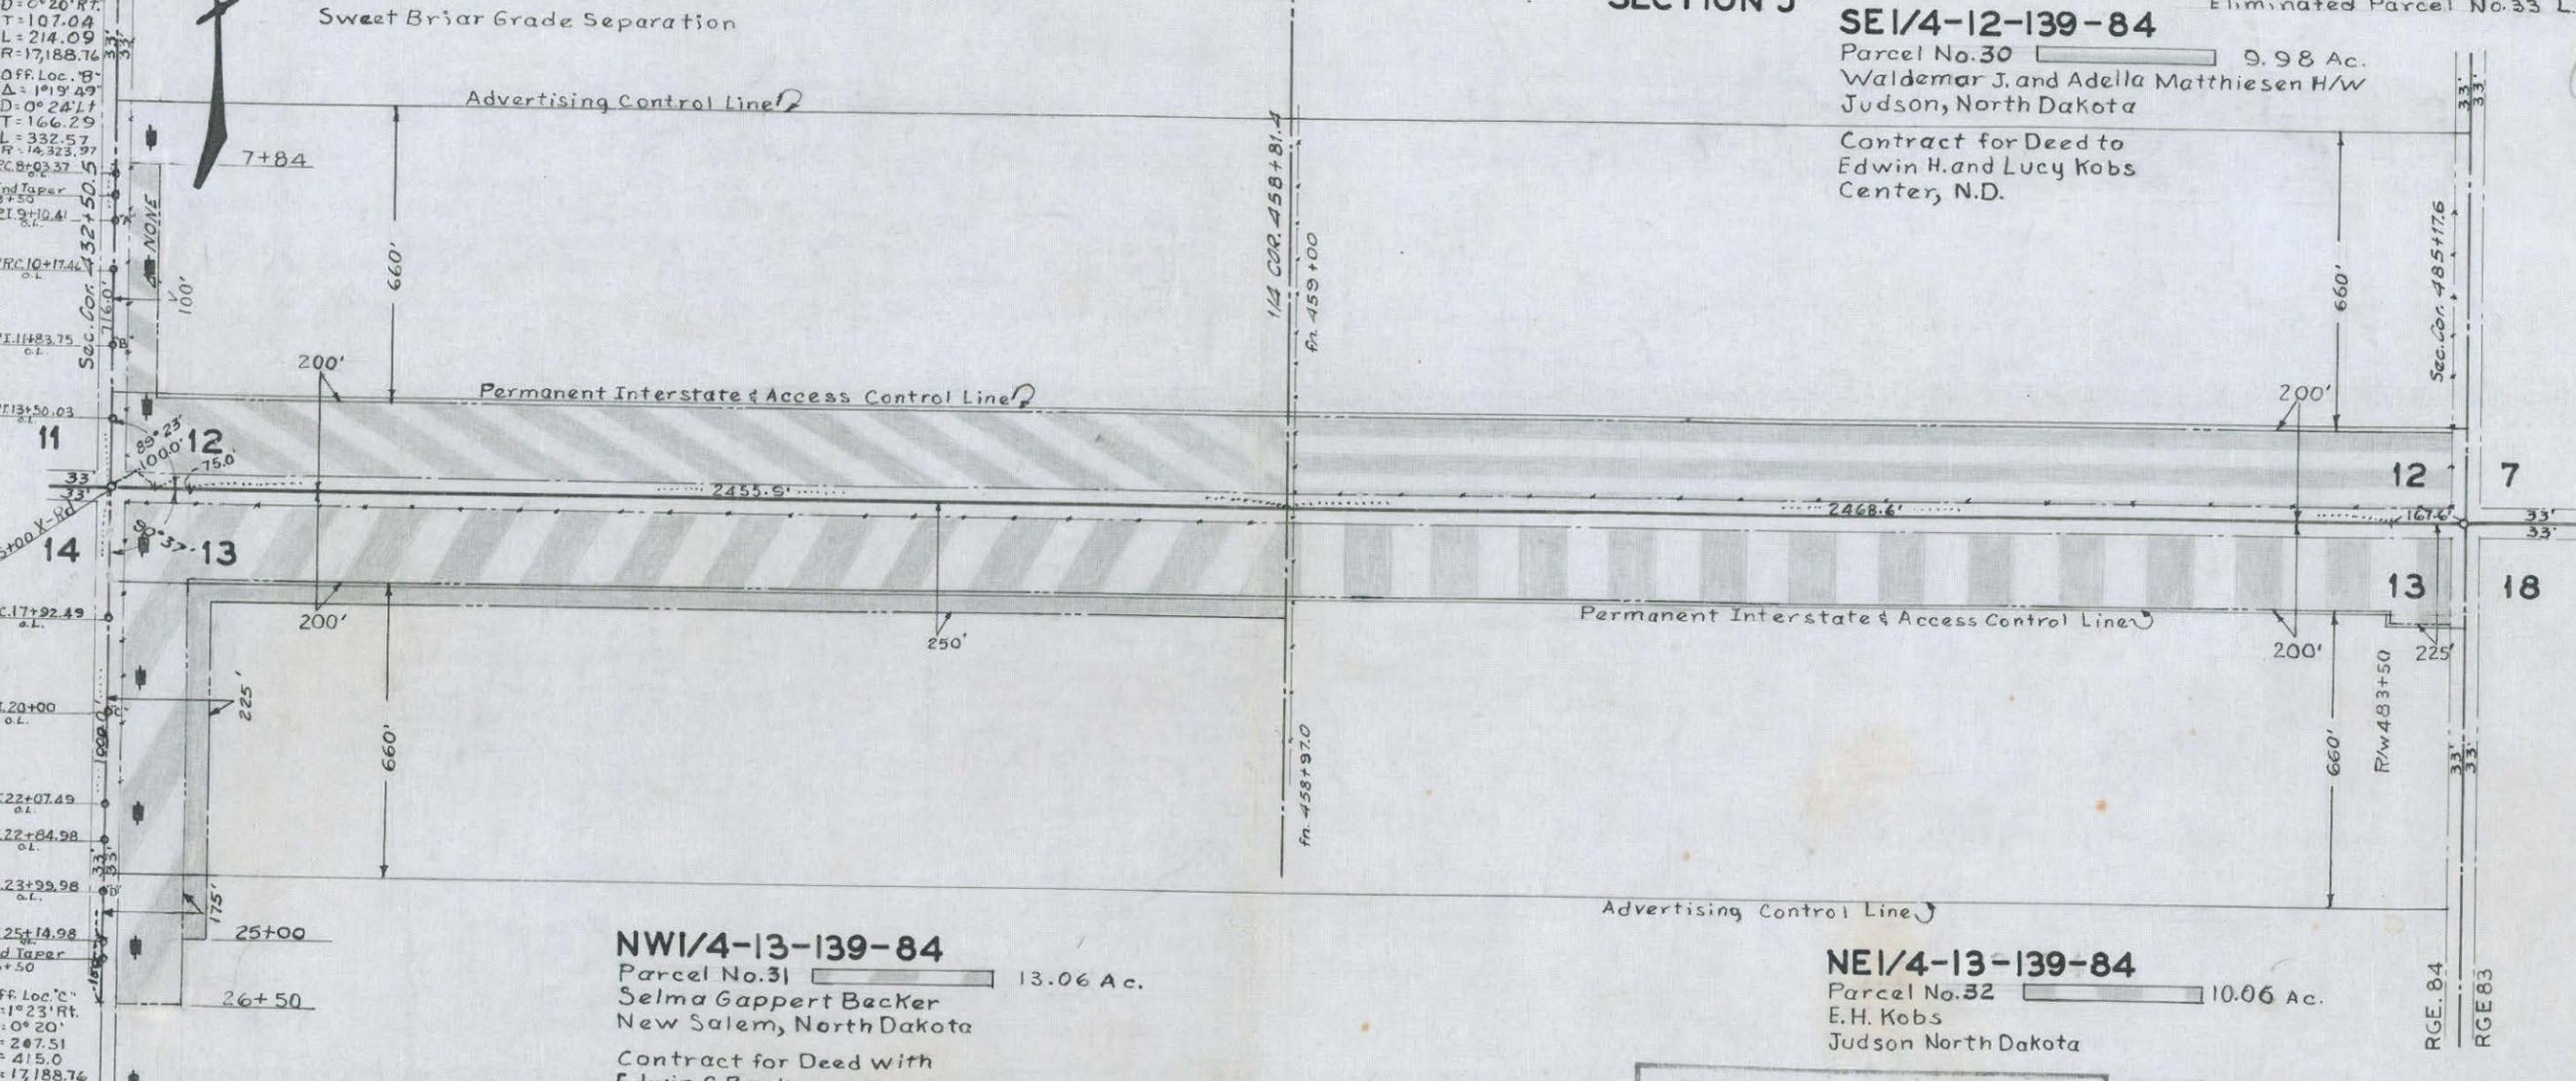

Parcel No. 29

The south 716.0 ft. of the west 100.0 ft. and the south 200.0 ft. of the east 2530.9 ft. of the SW $\frac{1}{4}$ of Sec. 12, Twp. 139 N., Rge. 84 W., 5th P. M., excepting all that portion lying within 33 feet of the section lines.

Tract contains 10.75 acres, more or less, and is shown on plat as shaded area.

Also including all right of access, being the right of ingress to and egress from the remaining property to and from the highway right of way as shown on the right of way plat. And including all right and control over the erection, location or maintenance of billboards, signs or any form of advertising whatsoever, upon all that portion of the SW $\frac{1}{4}$ of Sec. 12, Twp. 139 N., Rge. 84 W., in Morton County, North Dakota within 660 feet of the controlled access limits of Project I-IG-94-4(3), Morton County, North Dakota as shown on right of way plats on file in the office of the Register of Deeds of Morton County, North Dakota.

Parcel No. 30

The south 200.0 ft. of the SE $\frac{1}{4}$ of Sec. 12, Twp. 139 N., Rge. 84 W., 5th P. M., excepting all that portion lying within 33 feet of the section lines.

Tract contains 9.98 acres, more or less, and is shown on plat as shaded area.

Also including all right of access, being the right of ingress to and egress from the remaining property to and from the highway right of way as shown on the right of way plat. And including all right and control over the erection, location or maintenance of billboards, signs or any form of advertising whatsoever, upon all that portion of the SE $\frac{1}{4}$ of Sec. 12, Twp. 139 N., Rge. 84 W., in Morton County, North Dakota within 660 feet of the controlled access limits of Project I-IG-94-4(3), Morton County, North Dakota as shown on right of way plats on file in the office of the Register of Deeds of Morton County, North Dakota.

Parcel No. 31

The north 1150.0 ft. of the west 175.0 ft. and the north 200.0 ft. of the east 2455.9 ft. of the NW $\frac{1}{4}$ of Sec. 13, Twp. 139 N., Rge. 84 W., 5th P. M., excepting all that portion lying within 33 feet of the section lines.

Tract contains 13.06 acres, more or less, and is shown on plat as shaded area.

Also including all right of access, being the right of ingress to and egress from the remaining property to and from the highway right of way as shown on the right of way plat. And including all right and control over the erection, location or maintenance of billboards, signs or any form of advertising whatsoever, upon all that portion of the NW $\frac{1}{4}$ of Sec. 13, Twp. 139 N., Rge. 84 W., in Morton County, North Dakota within 660 feet of the controlled access limits of Project I-IG-94-4(3), Morton County, North Dakota as shown on right of way plats on file in the office of the Register of Deeds of Morton County, North Dakota.

Parcel No. 32

The north 200.0 ft. of the west 2468.6 ft. and the north 225.0 ft. of the east 167.6 ft. of the NE $\frac{1}{4}$ of Sec. 13, Twp. 139 N., Rge. 84 W., 5th P. M., excepting all that portion lying within 33 feet of the section lines.

Tract contains 10.06 acres, more or less, and is shown on plat as shaded area.

Also including all right of access, being the right of ingress to and egress from the remaining property to and from the highway right of way as shown on the right of way plat. And including all right and control over the erection, location or maintenance of billboards, signs or any form of advertising whatsoever,

SYSTEM DIST. HWY. AGREEMENT

MILE _____

SECTION "J" PROJECT NO. I-IG-94-4 (3)

SUPPLEMENT TO PLAT NO. 9 OF 22

Parcel No. 32 Continued

upon all that portion of the NE $\frac{1}{4}$ of Sec. 13, Twp. 139 N., Rge. 84 W., in Morton County, North Dakota within 660 feet of the controlled access limits of Project I-IG-94-4(3), Morton County, North Dakota as shown on right of way plats on file in the office of the Register of Deeds of Morton County, North Dakota.

Parcel No. 31A

The south 750.0 ft. of the north 1000.0 ft. of the east 50.0 ft. of the west 225.0 ft. and the south 50.0 ft. of the north 250.0 ft. of the east 2455.9 ft. of the NW $\frac{1}{4}$ of Sec. 13, Twp. 139 N., Rge. 84 W., 5th P. M.

Tract contains 3.68 acres, more or less, and is shown on plat as shaded area.



SI/2-7-139-83

Parcel No. 34 42.47 Ac.
Carl H. and Minnie Matthiesen H/w
Judson, North Dakota

Parcel No. 35 0.51 Ac.
Temp. slope Easement
Owner same as Parcel No. 34


PROJ. NO.	PARCEL	PLAT NO.	SUPPLEMENTS
I-IG-94-4 (3)	34-36	10 OF 22	ONE

SECTION "J"

Parcel No. 37 Eliminated

15

MADE BY L. E. Christensen DATE 4-9-63 CHECKED BY J.W.B. DATE 5-27-63

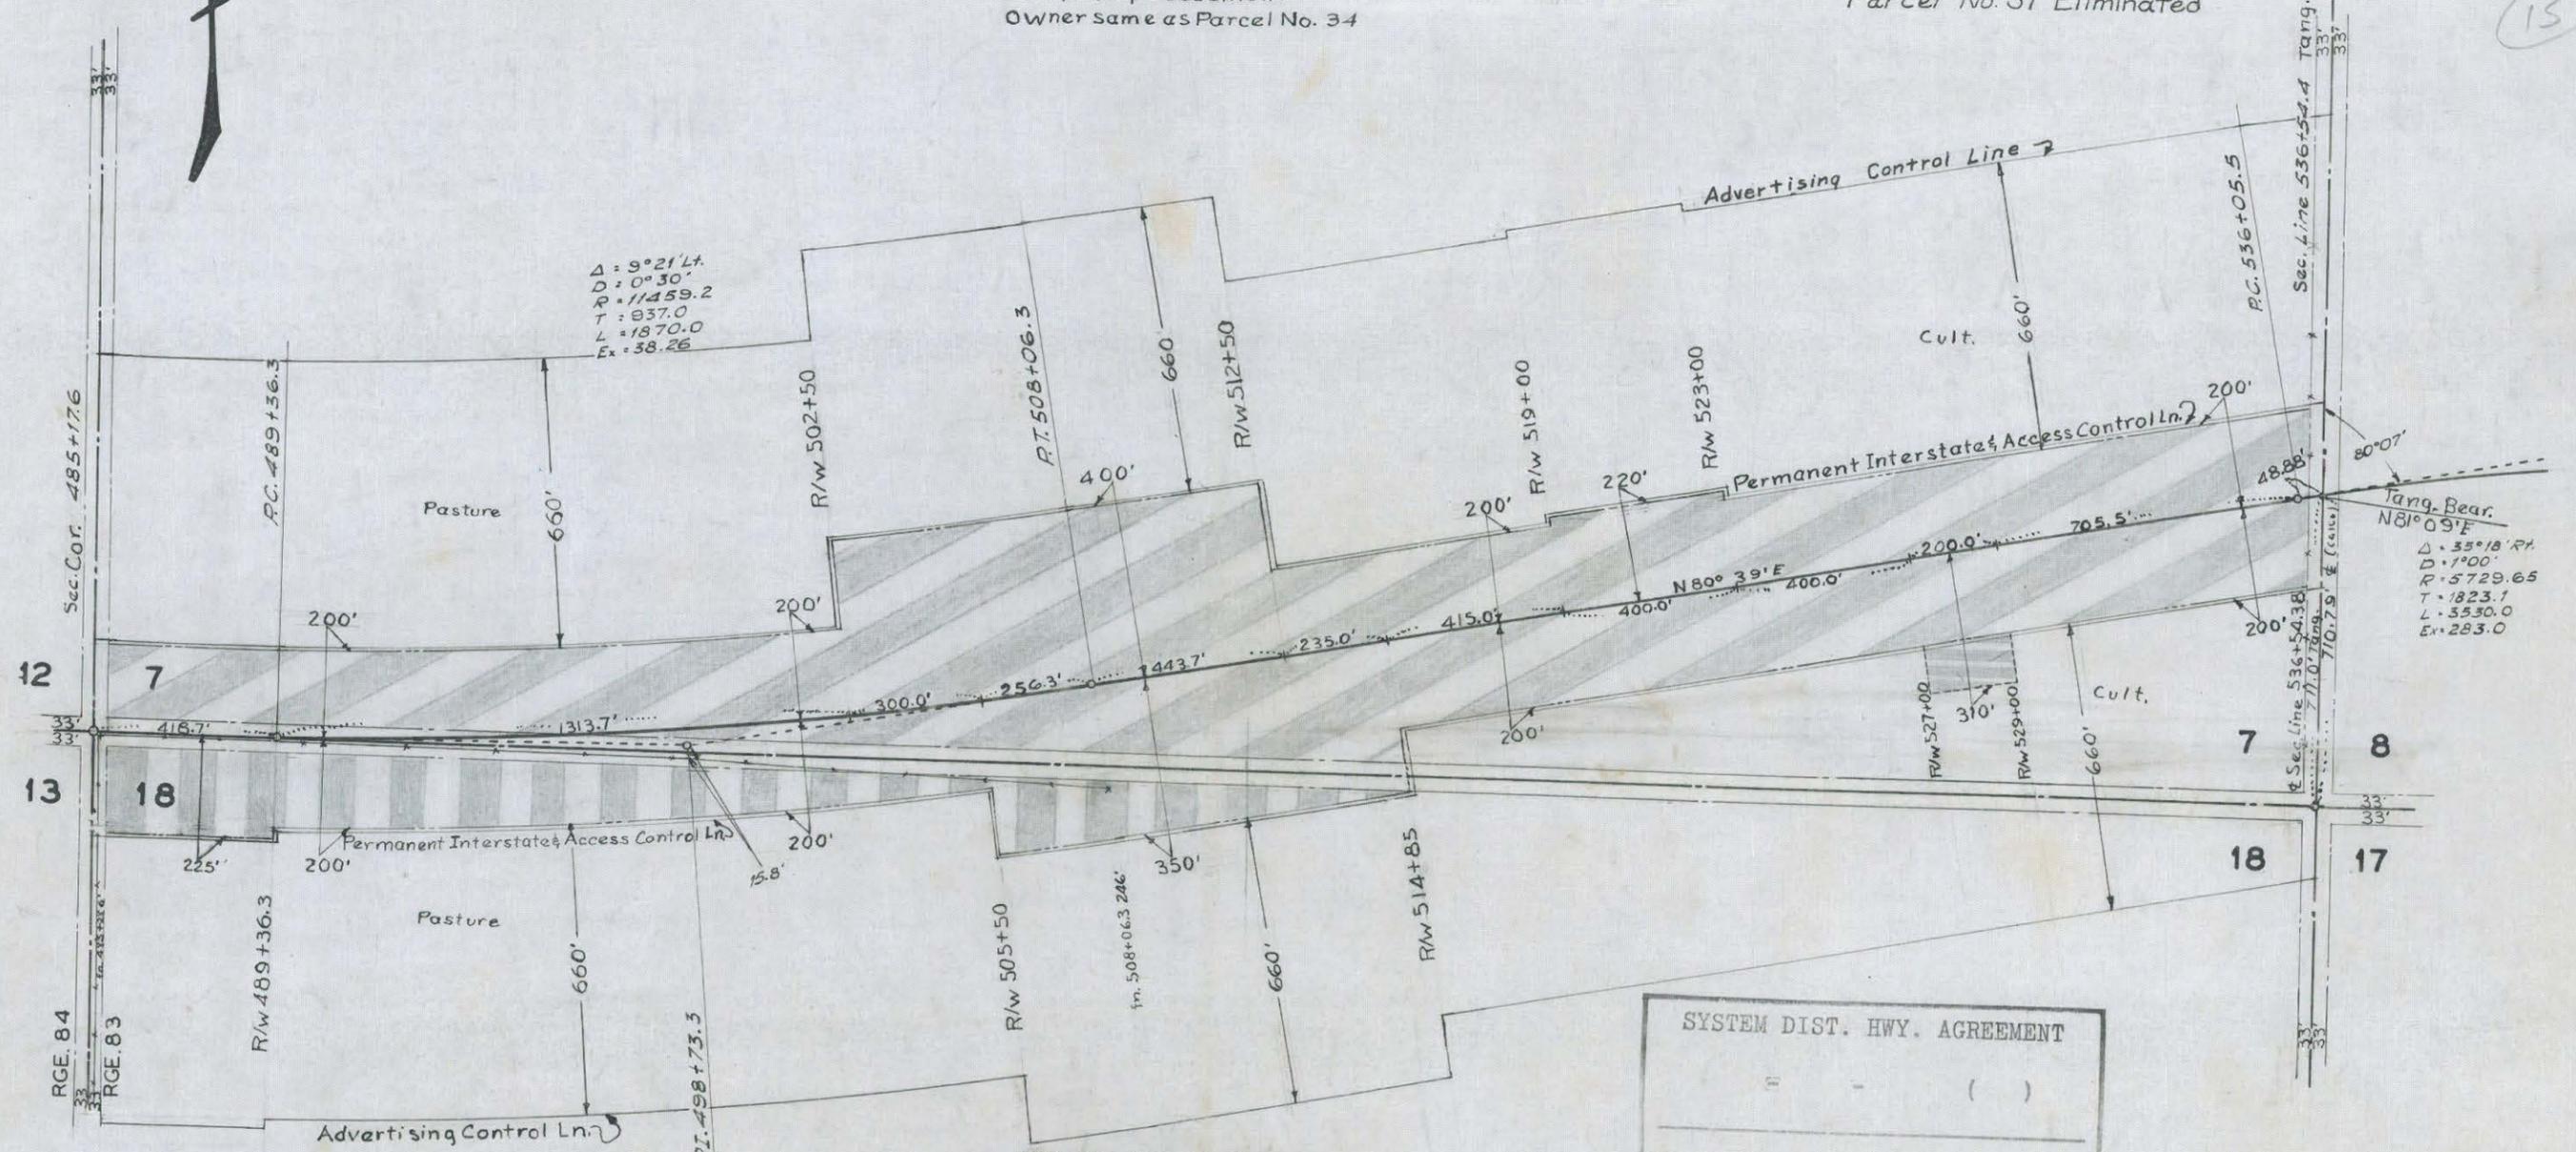

$\Delta = 9^{\circ}21'Lt.$
 $D = 0^{\circ}30'$
 $R = 11459.2$
 $T = 937.0$
 $L = 1870.0$
 $E_x = 38.26$

$\Delta = 35^{\circ}18' R.$
 $D = 7^{\circ}00'$
 $R = 5729.65$
 $T = 1823.1$
 $L = 5530.0$
 $E_x = 283.0$

NI/2-18-139-83

Parcel No. 36 8.19 Ac.
Ernest H. and Ottilia Wolf H/w
Mandan, North Dakota

SYSTEM DIST. HWY. AGREEMENT

MILE _____

This document was originally issued and sealed by Robert E. King, Registration Number LS 1001 on _____ and the original document is stored at the County Recorders Office

NORTH DAKOTA STATE HIGHWAY DEPARTMENT

RIGHT OF WAY PLAT

PROJECT NO. I-IG-94-4(3)

MORTON COUNTY

APPROVED *Robert E. King*
RIGHT OF WAY ENGINEER

SCALE 1" = 400'

DATE 7-31-63

Parcel No. 34

All that portion of the S $\frac{1}{2}$ of Sec. 7, Twp. 139 N., Rge. 83 W., 5th P. M., lying within a strip of land located on both sides of and measured at right angles to the following described highway centerline as surveyed and staked:

Beginning at a point on the southwest corner of said S $\frac{1}{2}$ where said strip is 425.0 ft. wide lying 200.0 ft. on the northerly side and 225.0 ft. on the southerly side of said centerline; thence running east 418.7 ft., more or less, to a point where said strip changes to 400.0 ft. in width, lying 200.0 ft. on each side of said centerline, thence along a 0°30' curve to the left 1313.7 ft. more or less to a point where said strip changes to 600.0 ft. in width, lying 400.0 ft. on the northerly side and 200.0 ft. on the southerly side of said centerline, thence continuing along said 0°30' curve 300.0 ft. more or less to a point where said strip changes to 750.0 ft. in width lying 400.0 ft. on the northerly side and 350.0 ft. on the southerly side of said centerline, thence continuing along said 0°30' curve 256.3 ft., thence N 80°39'E 443.7 ft. more or less to a point where said strip changes to 550.0 ft. in width lying 200.0 ft. on the northerly side and 350.0 ft. on the southerly side of said centerline thence continuing N 80°39'E 235.0 ft. more or less to a point where said strip changes to 400.0 ft. in width lying 200.0 ft. on both sides of said centerline, thence continuing N 80°39'E 415.0 ft. more or less to a point where said strip changes to 420.0 ft. in width, lying 220.0 ft. on the northerly side and 200.0 ft. on the southerly side of said centerline, thence continuing N 80°39'E 400.0 ft. more or less to a point where said strip changes to 400.0 ft. in width, lying 200.0 ft. on both sides of said centerline, thence continuing N 80°39'E 1305.5 ft., thence along a 1°00' curve to the right 48.88 ft. more or less until said strip crosses the east line of said S $\frac{1}{2}$, excepting all that portion lying within 33 feet of the section lines.

Tract contains 42.47 acres, more or less, and is shown on plat as shaded area.

Also including all right of access, being the right of ingress to and egress from the remaining property to and from the highway right of way as shown on the right of way plat.

And including all right and control over the erection, location or maintenance of billboards, signs or any form of advertising whatsoever, upon all that portion of the S $\frac{1}{2}$ of Sec. 7, Twp. 139 N., Rge. 83 W., in Morton County, North Dakota within 660 feet of the controlled access limits of Project I-IG-94-4(3), Morton County, North Dakota as shown on right of way plats on file in the office of the Register of Deeds of Morton County, North Dakota.

Parcel No. 35

All that portion of the S $\frac{1}{2}$ of Sec. 7, Twp. 139 N., Rge. 83 W., 5th P. M., lying within a strip of land located on the southerly side of and measured at right angles to the following described highway centerline as surveyed and staked:

Beginning at a point on the southwest corner of said S $\frac{1}{2}$, where said strip is 200.0 ft. wide, thence running east along the section line 418.7 ft., thence along a 0°30' curve to the left 1870.0 ft., thence N 80°39'E 1893.7 ft. more or less to a point where said strip changes to 310.0 ft. in width, thence continuing N 80°39'E 200.0 ft. more or less to a point where said strip changes to 200.0 ft. in width, thence continuing N 80°39'E until said strip crosses the east line of said S $\frac{1}{2}$, excepting all that portion lying within 200.0 ft. of the above described centerline.

Tract contains 0.51 acres, more or less, and is shown on plat as shaded area.

Parcel No. 36

All that portion of the N $\frac{1}{2}$ of Sec. 18, Twp. 139 N., Rge. 83 W., 5th P. M., lying within a strip of land located on the southerly side of and measured at right angles to the following described highway centerline as surveyed and staked:

SYSTEM DIST. HWY. AGREEMENT

MILE _____

SECTION 'J' PROJECT NO. I-IG-94-4(3)
SUPPLEMENT TO PLAT NO. 10 OF 22

Parcel No. 36 Continued

Beginning at a point on the northwest corner of said N $\frac{1}{2}$, where said strip is 225.0 ft. wide, thence running east along the section line 418.7 ft. more or less to a point where said strip changes to 200.0 ft. in width, thence along a 0°30' curve to the left 1613.7 ft. more or less to a point where said strip changes to 350.0 ft. in width, thence continuing along said 0°30' curve to the left 256.3 ft. thence N 80°39'E until said strip crosses the north line of said N $\frac{1}{2}$, excepting all that portion lying within 33 feet of the section lines.

Tract contains 8.19 acres, more or less, and is shown on plat as shaded area.

Also including all right of access, being the right of ingress to and egress from the remaining property to and from the highway right of way as shown on the right of way plat.

And including all right and control over the erection, location or maintenance of billboards, signs or any form of advertising whatsoever, upon all that portion of the N $\frac{1}{2}$ of Sec. 18, Twp. 139 N., Rge. 83 W., in Morton County, North Dakota within 660 feet of the controlled access limits of Project I-IG-94-4(3), Morton County, North Dakota as shown on right of way plats on file in the office of the Register of Deeds of Morton County, North Dakota.

15

PROJ. NO.	PARCEL	PLAT NO.	SUPPLEMENTS
I-IG-94-4(3)	38-41	11 OF 22	ONE

SECTION "J"

SI/2-8-139-83
 Parcel No. 38 36.50 Ac. ✓
 Joseph F. and Mathilda Miller
 Mandan, N.D.
 Parcel No. 39 0.22 Ac. ✓
 Temp. slope Easement & Permanent Maintenance
 Owner same as Parcel No. 38


15

DATE 5-28-63

CHECKED BY J.W.B.

DATE 11-15-62

MADE BY L.E. Christensen

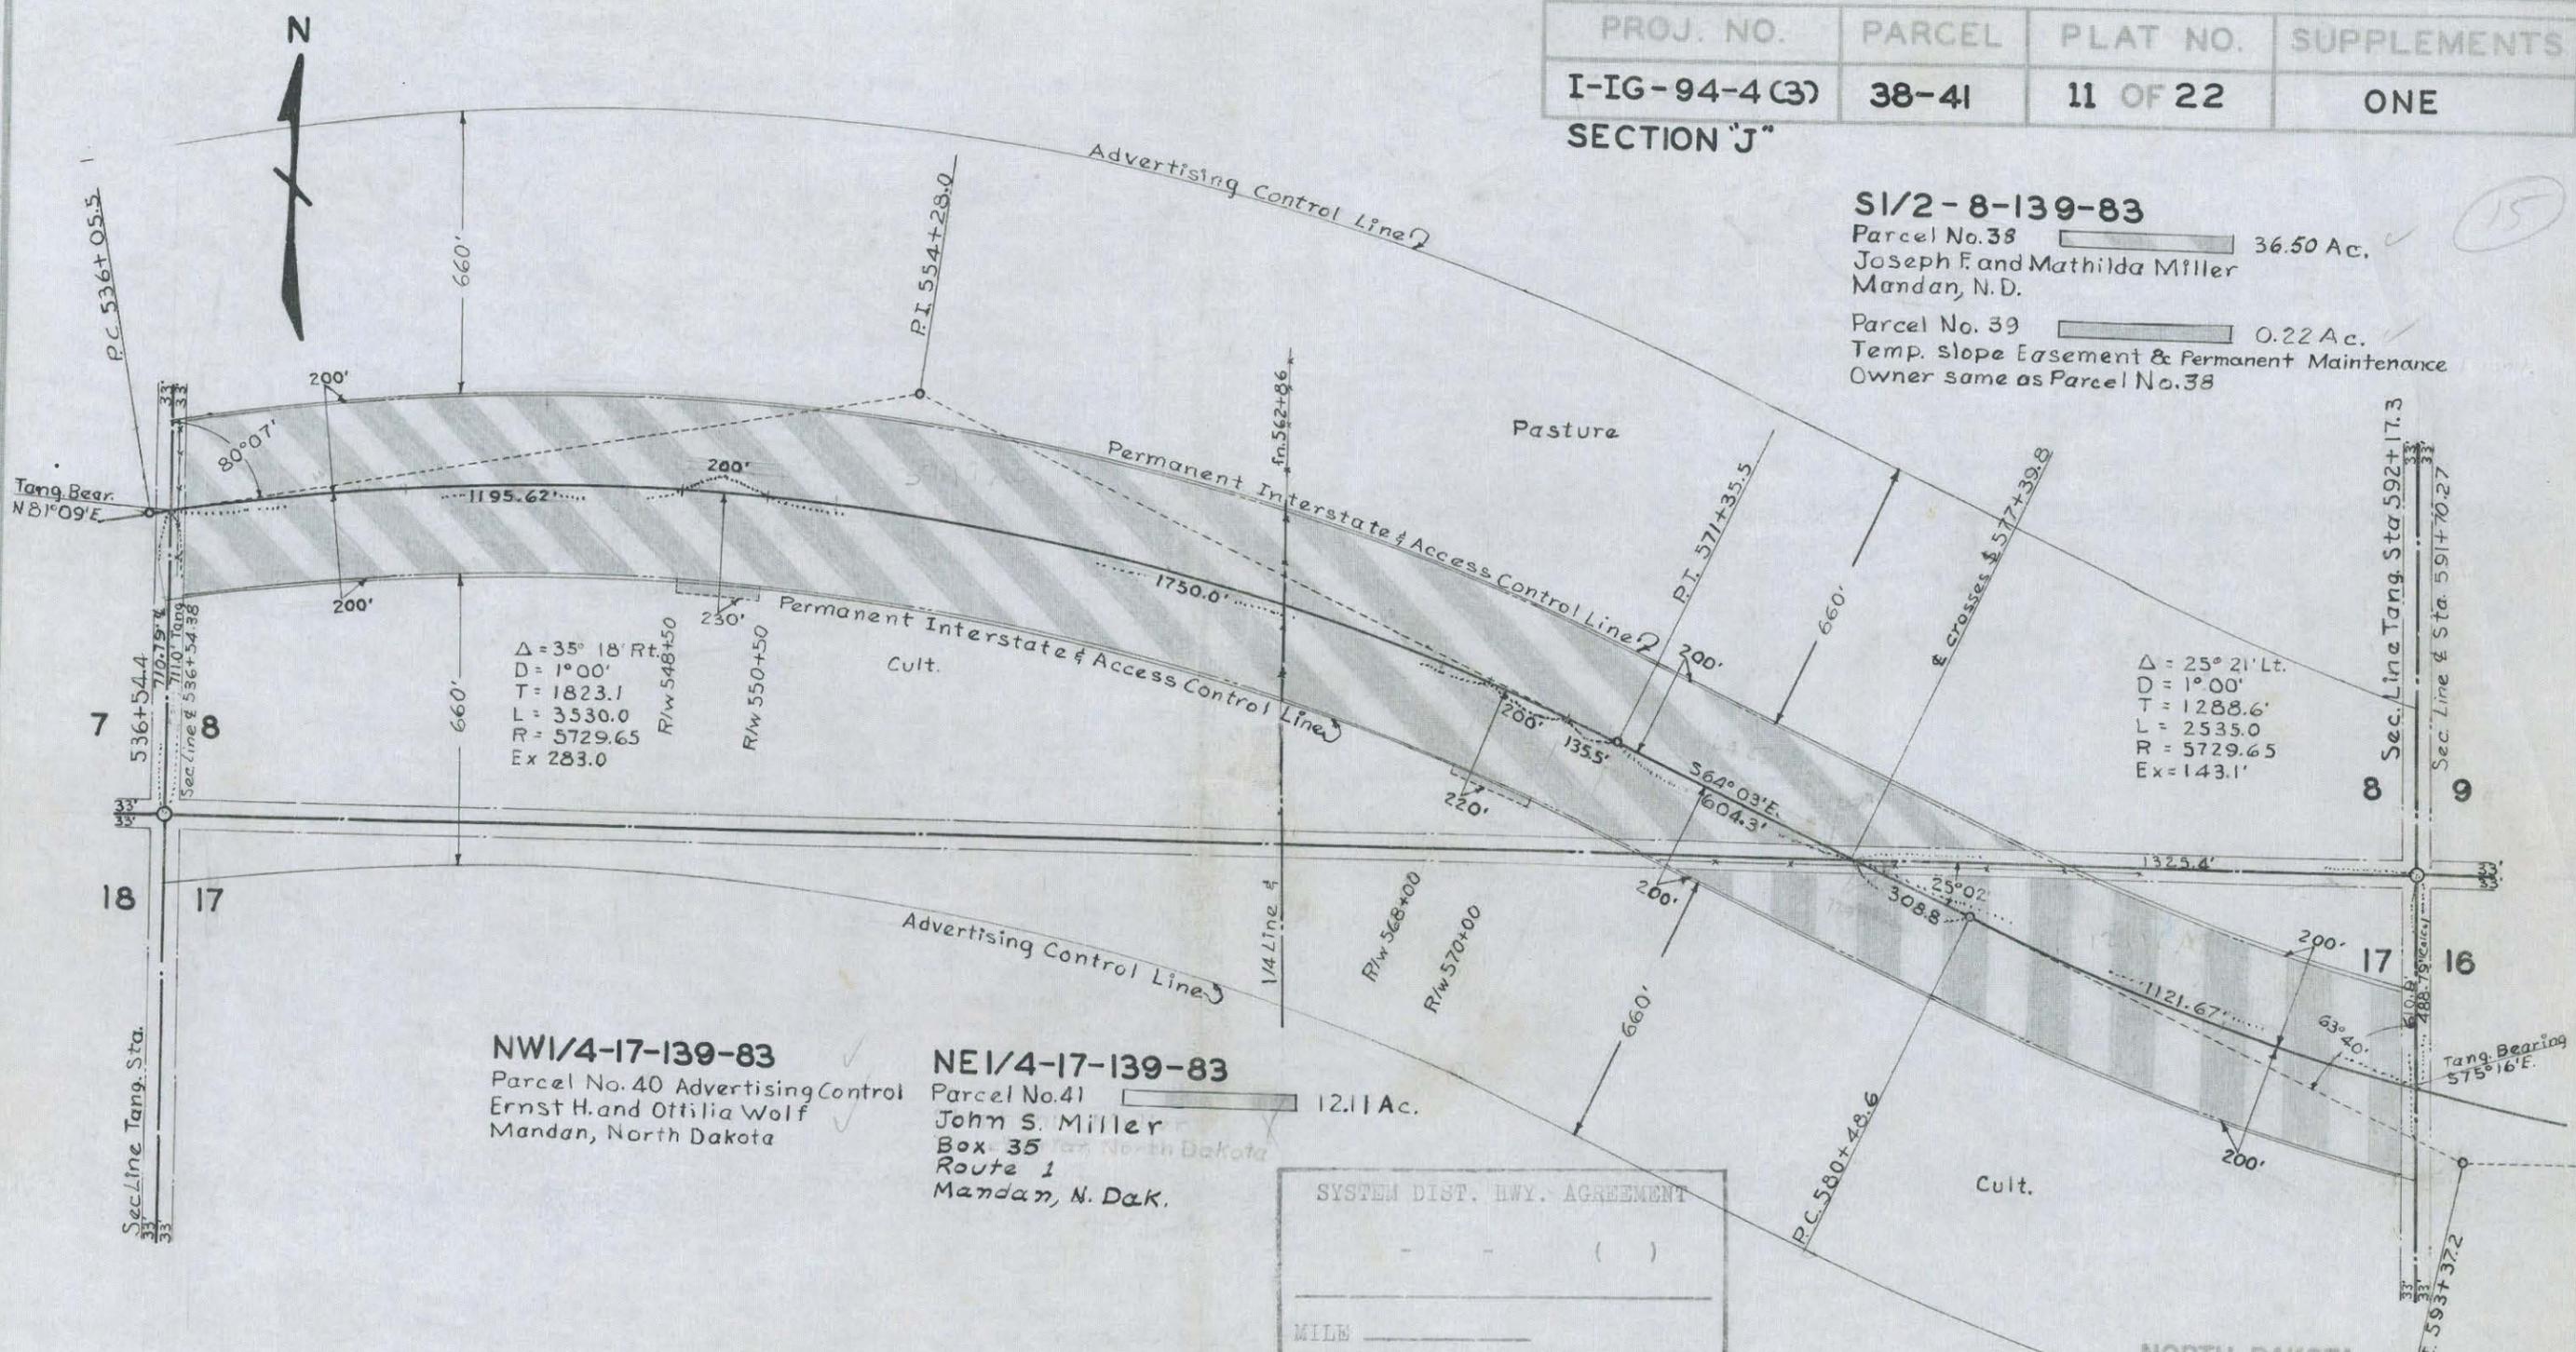

NW1/4-17-139-83
 Parcel No. 40 Advertising Control
 Ernst H. and Ottilia Wolf
 Mandan, North Dakota

NE1/4-17-139-83
 Parcel No. 41 12.11 Ac.
 John S. Miller
 Box 35 North Dakota
 Route 1
 Mandan, N. Dak.

SYSTEM DIST. HWY. AGREEMENT

 MILE _____

This document was originally issued and sealed by Robert E. King, Registration Number LS 1001 on ___/___/___ and the original document is stored at the County Recorders Office

NORTH DAKOTA STATE HIGHWAY DEPARTMENT

RIGHT OF WAY PLAT

PROJECT NO. **I-IG-94-4(3)**

MORTON COUNTY

APPROVED *Robert E. King*
 RIGHT OF WAY ENGINEER

SCALE 1" = 400'

DATE **7-31-63**

Parcel No. 38

All that portion of the S $\frac{1}{2}$ of Sec. 8, Twp. 139 N., Rge. 83 W., 5th P. M., lying within a strip of land 400.0 ft. wide, lying 200.0 ft. on both sides of the following described highway centerline as surveyed and staked over and across said S $\frac{1}{2}$:

Beginning at a point 710.79 ft. north of the southwest corner of said S $\frac{1}{2}$, thence from a tangent bearing of N 81°09'E running along a 1°00' curve to the right 3481.12 ft., thence S 64°03'E 913.1 ft., thence along a 1°00' curve to the left until said strip crosses the south line of said S $\frac{1}{2}$, excepting all that portion lying within 33 feet of the section lines.

Tract contains 36.50 acres, more or less, and is shown on plat as shaded area.

Also including all right of access, being the right of ingress to and egress from the remaining property to and from the highway right of way, as shown on the right of way plat.

And including all right and control over the erection, location or maintenance of billboards, signs or any form of advertising whatsoever, upon all that portion of the S $\frac{1}{2}$ of Sec. 8, Twp. 139 N., Rge. 83 W., in Morton County, North Dakota, within 660 feet of the *Controlled Access* limits of Project No. I-IG-94-4(3), Morton County, North Dakota, as shown on right of way plats on file in the office of the Register of Deeds of Morton County, North Dakota.

Parcel No. 39

All that portion of the S $\frac{1}{2}$ of Sec. 8, Twp. 139 N., Rge. 83 W., 5th P. M., lying within a strip of land located on the southerly side of and measured at right angles to the following described highway centerline as surveyed and staked:

Beginning at a point 710.79 ft. north of the southwest corner of said S $\frac{1}{2}$ where said strip is 200.0 ft. wide, thence from a tangent bearing of N 81°09'E running along a 1°00' curve to the right 1195.62 ft., more or less, to a point where said strip changes to 230.0 ft. in width, thence continuing along said 1°00' curve to the right 200.0 ft., more or less, to a point where said strip changes to 200.0 ft. in width, thence continuing along said 1°00' curve to the right 1750.0 ft., more or less, to a point where said strip changes to 220.0 ft. in width, thence continuing along said 1°00' curve to the right 200.0 ft., more or less, to a point where said strip changes to 200.0 ft. in width, thence continuing along said 1°00' curve to the right 135.5 ft., thence S 64°03'E until said strip crosses the south line of said S $\frac{1}{2}$ excepting all that portion lying within 200.0 ft. of the above described centerline.

Tract contains 0.22 acres, more or less, and is shown on plat as shaded area.

Parcel No. 40

All right and control over the erection, location or maintenance of billboards, signs or any form of advertising whatsoever, upon all that portion of the NW $\frac{1}{4}$ of Sec. 17, Twp. 139 N., Rge. 83 W., in Morton County, North Dakota, within 660 feet of the controlled access limits of Project No. I-IG-94-4(3), Morton County, North Dakota, as shown on right of way plats on file in the office of the Register of Deeds of Morton County, North Dakota.

SYSTEM DIST. HWY. AGREEMENT

SECTION 'J' PROJECT NO. I-IG-94-4(3)
SUPPLEMENT TO PLAT NO. 11 OF 22

Parcel No. 41

15

All that portion of the NE $\frac{1}{4}$ of Sec. 17, Twp. 139 N., Rge. 83 W., 5th P. M., lying within a strip of land 400.0 ft. wide, lying 200.0 ft. on both sides of the following described highway centerline as surveyed and staked over and across said NE $\frac{1}{4}$:

Beginning at a point 488.79 ft. south of the northeast corner of said NE $\frac{1}{4}$; thence from a tangent bearing of N 75°16'W running along a 1°00' curve to the right 1121.67 ft., thence N 64°03'W until said strip crosses the north line of said NE $\frac{1}{4}$ excepting all that portion lying within 33 feet of the section lines.

Tract contains 12.11 acres, more or less, and is shown on plat as shaded area.

Also including all right of access, being the right of ingress to and egress from the remaining property to and from the highway right of way as shown on the right of way plat.

And including all right and control over the erection, location or maintenance of billboards, signs or any form of advertising whatsoever, upon all that portion of the NE $\frac{1}{4}$ of Sec. 17, Twp. 139 N., Rge. 83 W., in Morton County, North Dakota, within 660 feet of the controlled access limits of Project No. I-IG-94-4(3), Morton County, North Dakota, as shown on right of way plats on file in the office of the Register of Deeds of Morton County, North Dakota.

Parcel No. 42

All right and control over the erection, location or maintenance of billboards, signs or any form of advertising whatsoever, upon all that portion of the SW $\frac{1}{4}$ of Sec. 9, Twp. 139 N., Rge. 83 W., in Morton County, North Dakota within 660 feet of the controlled access limits of Project I-IG-94-4(3), Morton County, North Dakota as shown on right of way plats on file in the office of the Register of Deeds of Morton County, North Dakota.

Parcel No. 43

The south 440.0 ft. of the east 100.0 ft. of the SE $\frac{1}{4}$ of Sec. 9, Twp. 139 N., Rge. 83 W., 5th P. M., excepting all that portion lying within 33 feet of the section lines.

Tract contains 0.63 acres, more or less, and is shown on plat as shaded area.

~~Also including all right of access, being the right of ingress to and egress from the remaining property to and from the highway right of way as shown on the right of way plat.~~

And including all right and control over the erection, location or maintenance of billboards, signs or any form of advertising whatsoever, upon all that portion of the SE $\frac{1}{4}$ of Sec. 9, Twp. 139 N., Rge. 83 W., in Morton County, North Dakota within 660 feet of the controlled access limits of Project I-IG-94-4(3), Morton County, North Dakota as shown on right of way plats on file in the office of the Register of Deeds of Morton County, North Dakota.

Parcel No. 44

All that portion of the N $\frac{1}{2}$ of Sec. 16, Twp. 139 N., Rge. 83 W., 5th P. M., lying within a strip of land located on both sides of and measured at right angles to the following described highway centerline as surveyed and staked:

Beginning at a point 710.0 ft. south of the northeast corner of said N $\frac{1}{2}$; where said strip 420.0 ft. wide lying 200.0 ft. on the northerly side and 220.0 ft. on the southerly side of said centerline, thence running N 89°24'W 1451.0 ft. more or less to a point where said strip changes to 400.0 ft. in width lying 200.0 ft. on both sides of said centerline; thence continuing N 89°24'W 2416.4 ft., thence along a 1°00' curve to the right 1413.33 ft. more or less until said strip crosses the west line of said N $\frac{1}{2}$; also including all that portion bounded and described as follows; beginning at a point on the northeast corner of said N $\frac{1}{2}$, thence running west along the section line 100.0 ft., thence south 160.0 ft., thence S 64°02'W 1229.8 ft., thence S 62°50'E 1229.8 ft., thence south 350.0 ft., thence east 100.0 ft. more or less to a point on the east line of said N $\frac{1}{2}$, thence north along said east line 1610.0 ft. more or less to the point of beginning, excepting all that portion previously acquired for public highway right of way and all that portion lying within 33 feet of the section lines.

Tract contains 54.83 acres, more or less, and is shown on plat as shaded area.

Also including all right of access, being the right of ingress to and egress from the remaining property to and from the highway right of way as shown on the right of way plat.

And including all right and control over the erection, location or maintenance of billboards, signs or any form of advertising whatsoever, upon all that portion of the N $\frac{1}{2}$ of Sec. 16, Twp. 139 N., Rge. 83 W., in Morton County, North Dakota within 660 feet of the controlled access limits of Project I-IG-94-4(3), Morton County, North Dakota as shown on right of way plats on file in the office of the Register of Deeds of Morton County, North Dakota.

SYSTEM DIST. HWY. AGREEMENT

FILE

SECTION 'J' PROJECT NO. I-IG-94-4(3)
SUPPLEMENT TO PLAT NO. 12 OF 22

Parcel No. 45

All that portion of the N $\frac{1}{2}$ of Sec. 16, Twp. 139 N., Rge. 83 W., 5th P. M., lying within a strip of land located on both sides of and measured at right angles to the following described highway centerline as surveyed and staked:

Beginning at a point 710.0 ft. south of the northeast corner of said N $\frac{1}{2}$, where said strip is 400.0 ft. wide, lying 200.0 ft. on both sides of said centerline, thence running N 89°24'W 2726.0 ft. more or less to a point where said strip changes to 650.0 ft. in width, lying 450.0 ft. on the northerly side and 200.0 ft. on the southerly side of said centerline, thence continuing N 89°24'W 145.0 ft. more or less to a point where said strip changes to 775.0 ft. in width, lying 450.0 ft. on the northerly side and 325.0 ft. on the southerly side of said centerline, thence continuing N 89°24'W 80.0 ft. more or less to a point where said strip changes to 525.0 ft. in width, lying 200.0 ft. on the northerly side and 325.0 ft. on the southerly side of said centerline, thence continuing N 89°24'W 120.0 ft. more or less to a point where said strip changes to 400.0 ft. in width, lying 200.0 ft. on each side of said centerline, thence continuing N 89°24'W 705.0 ft. more or less to a point where said strip changes to 450.0 ft. in width, lying 200.0 ft. on the northerly side and 250.0 ft. on the southerly side of said centerline, thence continuing N 89°24'E 91.4 ft. more or less to a point where said strip changes to 400.0 ft. in width lying 200.0 ft. on both sides of said centerline, thence along a 1°00' curve to the right until said strip crosses the west line of said N $\frac{1}{2}$, excepting all that portion lying within 200.0 ft. on both sides of the above described highway centerline. Also including all that portion bounded and described as follows; beginning at a point on the highway centerline 710.0 ft. south and 3867.4 ft. N 89°24'W from the northeast corner of said N $\frac{1}{2}$; thence running along a 1°00' curve to the right 833.6 ft., thence N 8°56'E 500.0 ft., thence southerly along a line which is running parallel to and 500.0 ft. distant from the afore described highway centerline 472.09 ft., thence S 28°35'E 596.99 ft. more or less to the point of beginning; excepting all that portion lying within 200.0 ft. of the above described highway centerline and all that portion previously acquired for public highway right of way.

Tract contains 5.63 acres, more or less, and is shown on plat as shaded area.

15




SW 1/4-10-139-83
 Parcel No. 46 0.63 Ac.
 Anton F. and Beatrice Zander h/w
 Mandan, North Dakota

PROJ. NO.	PARCEL	PLAT NO.	SUPPLEMENTS
I-IG-94-4 (3)	46-50	13 OF 22	ONE

SE 1/4-10-139-83
 Parcel No. 47 Advertising Control
 Frank L. and Mary M. Miller
 Mandan, North Dakota

NOTE
 INSTALL PIPE CULVERT
 662 + 48.5' 48" X 340'

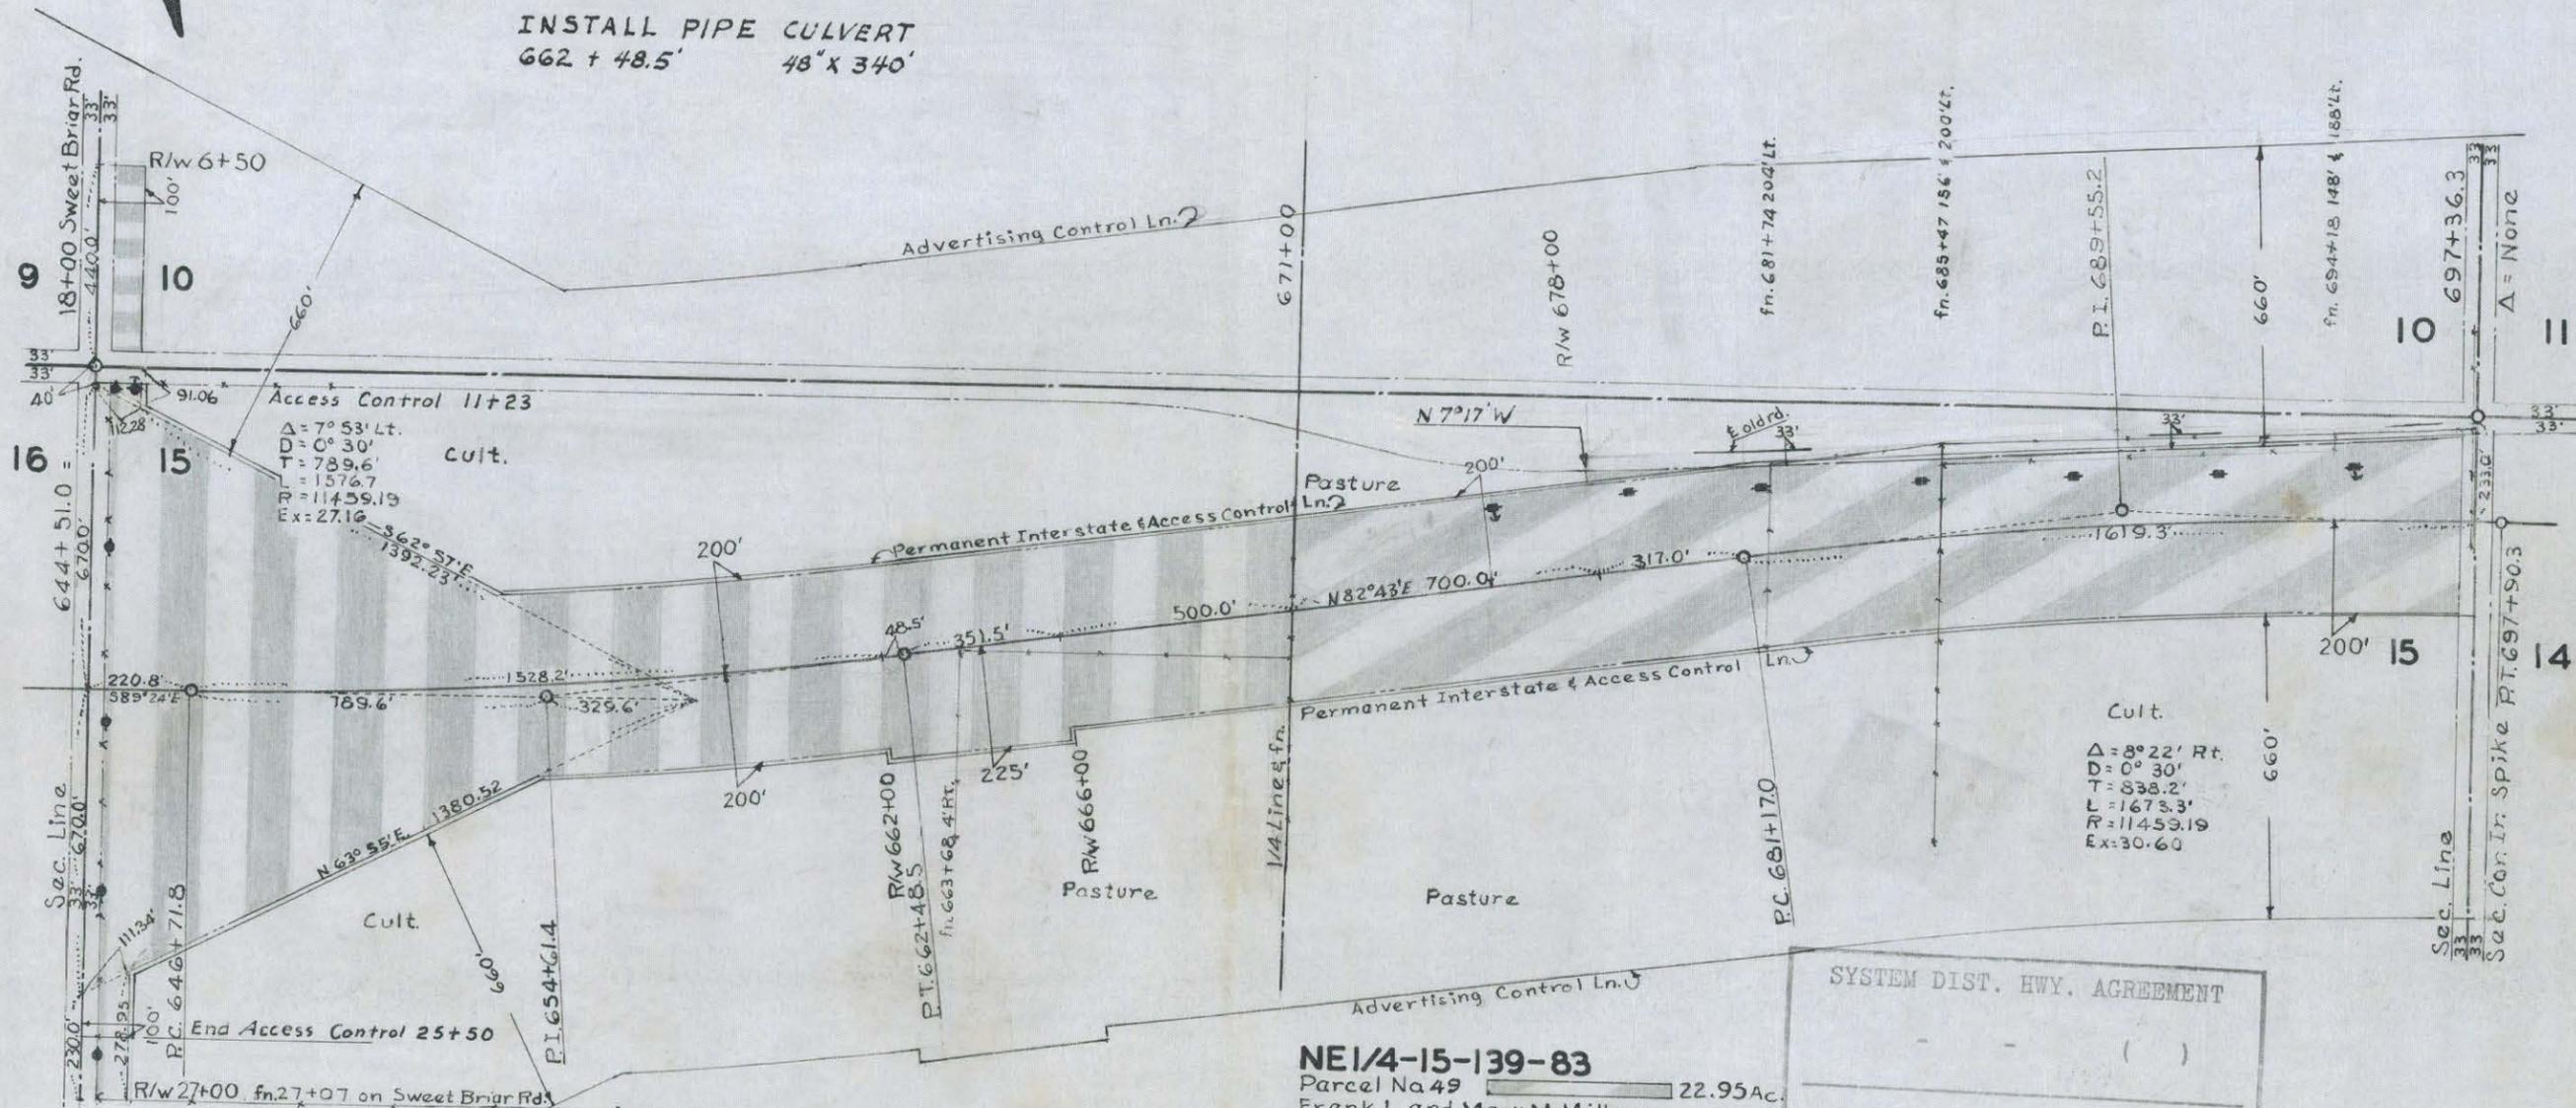

NW 1/4-15-139-83
 Parcel No. 48 34.57 Ac.
 Matilda Gress
 R.F.D., Mandan, North Dakota

NE 1/4-15-139-83
 Parcel No. 49 22.95 Ac.
 Frank L. and Mary M. Miller
 Mandan, North Dakota
 Parcel No. 50 0.15 Ac.
 Temp. slope Easement
 Owner same as Parcel No. 49

SYSTEM DIST. HWY. AGREEMENT

 MILE _____

NORTH DAKOTA
 STATE HIGHWAY DEPARTMENT

RIGHT OF WAY PLAT

PROJECT NO. **I-IG-94-4(3)**

MORTON COUNTY

APPROVED *Robert E. King*
 RIGHT OF WAY ENGINEER

SCALE 1" = 400' DATE **7-31-63**

This document was originally issued and sealed by Robert E. King, Registration Number LS 1001 on ___/___/___ and the original document is stored at the County Recorders Office

MADE BY L.E. Christensen DATE 11-21-62 CHECKED BY J.W.B. DATE 6-5-63

15

Parcel No. 46

The west 100.0 ft. of the south 440.0 ft. of the SW $\frac{1}{4}$ of Sec. 10, Twp. 139 N., Rge. 83 W., 5th P. M., excepting all that portion lying within 33 feet of the section lines.

Tract contains 0.63 acres, more or less, and is shown on plat as shaded area.

~~Also including all right of access, being the right of ingress to and egress from the remaining property to and from the highway right of way as shown on the right of way plat.~~

And including all right and control over the erection, location or maintenance of billboards, signs or any form of advertising whatsoever, upon all that portion of the SW $\frac{1}{4}$ of Sec. 10, Twp. 139 N., Rge. 83 W., in Morton County, North Dakota within 660 feet of the controlled access limits of Project I-IG-94-4(3), Morton County, North Dakota as shown on right of way plats on file in the office of the Register of Deeds of Morton County, North Dakota.

Parcel No. 47

All right and control over the erection, location or maintenance of billboards, signs or any form of advertising whatsoever, upon all that portion of the SE $\frac{1}{4}$ of Sec. 10, Twp. 139 N., Rge. 83 W., in Morton County, North Dakota within 660 feet of the controlled access limits of Project I-IG-94-4(3), Morton County, North Dakota as shown on right of way plats on file in the office of the Register of Deeds of Morton County, North Dakota.

Parcel No. 48

All that portion of the NW $\frac{1}{4}$ of Sec. 15, Twp. 139 N., Rge. 83 W., 5th P.M., lying within a strip of land located on both sides of and measured at right angles to the following described highway centerline as surveyed and staked:

Beginning at a point 710.0 ft. south of the northwest corner of said NW $\frac{1}{4}$; where said strip is 400.0 ft. wide, lying 200.0 ft. on both sides of said centerline; thence running S 89°24'E 220.8 ft., thence along a 0°30' curve to the left 1528.2 ft. more or less to a point where said strip changes to 425.0 ft. in width, lying 200.0 ft. on the northerly side and 225.0 ft. on the southerly side of said centerline, thence continuing along said 0°30' curve to the left 48.5 ft., thence N 82°43'E 351.5 ft. more or less to a point where said strip changes to 400.0 ft. in width, lying 200.0 ft. on both sides of said centerline, thence continuing N 82°43'E 500.0 ft. more or less until said strip crosses the east line of said NW $\frac{1}{4}$; also including all that portion bounded and described as follows; beginning at a point on the northwest corner of said NW $\frac{1}{4}$; thence running south 1610.0 ft., thence east 100.0 ft., thence north 278.95 ft., thence N 63°55'E 1380.52 ft., thence N 62°57'W 1392.23 ft., thence north 91.06 ft., thence west 100.0 ft. more or less to the point of beginning, excepting all that portion lying within 33 feet of the section lines.

Tract contains 34.57 acres, more or less, and is shown on plat as shaded area.

Also including all right of access, being the right of ingress to and egress from the remaining property to and from the highway right of way as shown on the right of way plat.

And including all right and control over the erection, location or maintenance of billboards, signs or any form of advertising whatsoever, upon all that portion of the NW $\frac{1}{4}$ of Sec. 15, Twp. 139 N., Rge. 83 W., in Morton County, North Dakota within 660 feet of the controlled access limits of Project I-IG-94-4(3), Morton County, North Dakota as shown on right of way plats on file in the office of the Register of Deeds of Morton County, North Dakota

SYSTEM DIST. HWY. AGREEMENT

SECTION "J" PROJECT NO. I-IG-94-4(3)

SUPPLEMENT TO PLAT NO. 13 OF 22

Parcel No. 49

MILE

All that portion of the NE $\frac{1}{4}$ of Sec. 15, Twp. 139 N., Rge. 83 W., 5th P. M., lying within a strip of land 400.0 ft. wide, lying 200.0 ft. on both sides of the following described highway centerline as surveyed and staked over and across said NE $\frac{1}{4}$:

Beginning at a point 710.0 ft. south, thence 1010.4 ft. S 89°24'E, thence 1641.1 ft. N 82°43'E from the northwest corner of said Section 15; thence running N 82°43'E 1017.0 ft., thence along a 0°30' curve to the right 1619.3 ft. more or less until said strip crosses the east line of said NE $\frac{1}{4}$, excepting all that portion previously acquired for public highway right of way and all that portion lying within 33 feet of the section lines.

Tract contains 22.95 acres, more or less, and is shown on plat as shaded area.

Also including all right of access, being the right of ingress to and egress from the remaining property to and from the highway right of way as shown on the right of way plat.

And including all right and control over the erection, location or maintenance of billboards, signs or any form of advertising whatsoever, upon all that portion of the NE $\frac{1}{4}$ of Sec. 15, Twp. 139 N., Rge. 83 W., in Morton County, North Dakota within 660 feet of the controlled access limits of Project I-IG-94-4(3), Morton County, North Dakota as shown on right of way plats on file in the office of the Register of Deeds of Morton County, North Dakota

Parcel No. 50

A tract of land lying in the NE $\frac{1}{4}$ of Sec. 15, Twp. 139 N., Rge. 83 W., 5th P. M., said tract being described as follows:

All that portion lying northerly of the northerly Interstate limits and easterly of a line described as follows; beginning at a point 710.0 ft. south, thence 1010.4 ft. S 89°24'E and 2341.1 ft. N 82°43'E from the northwest corner of said Section 15, thence running N 7°17'W until said line intersects the north line of said Section 15, excepting all that portion previously acquired for public highway right of way and all that portion lying within 33 feet of the section line.

Tract contains 0.15 acres, more or less, and is shown on plat as shaded area.

15

S1/2-11-139-83
 Parcel No. 51 Advertising Control
 Simon Vogel
 Mandan, North Dakota

PROJ. NO.	PARCEL	PLAT NO.	SUPPLEMENTS
I-IG-94-4 (3)	51-54	14 OF 22	ONE

SECTION "J"

SYSTEM DIST. HWY. AGREEMENT

_____ () _____

MILE _____


NOTE
 INSTALL STRUCTURES
 699+24.9 DOUBLE 8'x10'x20' BOX
 737+50 STANDARD CATTLE PASS

$\Delta = 8^{\circ} 22' \text{ Rt.}$
 $D = 0^{\circ} 30'$
 $T = 838.2'$
 $L = 1673.3'$
 $R = 11459.19'$
 $Ex = 30.60'$

699+25-221' Lt.
 Dbl. 10'x8'x32' R.C.B.

Ch.Ch. 3+41.4 =
 699+24.9 M.L.

Ch.Ch.
 $\Delta = 45^{\circ} 00' \text{ Rt.}$
 $D = 28^{\circ} 58'$
 $T = 82.8'$
 $L = 157.1'$
 $R = 200.0'$

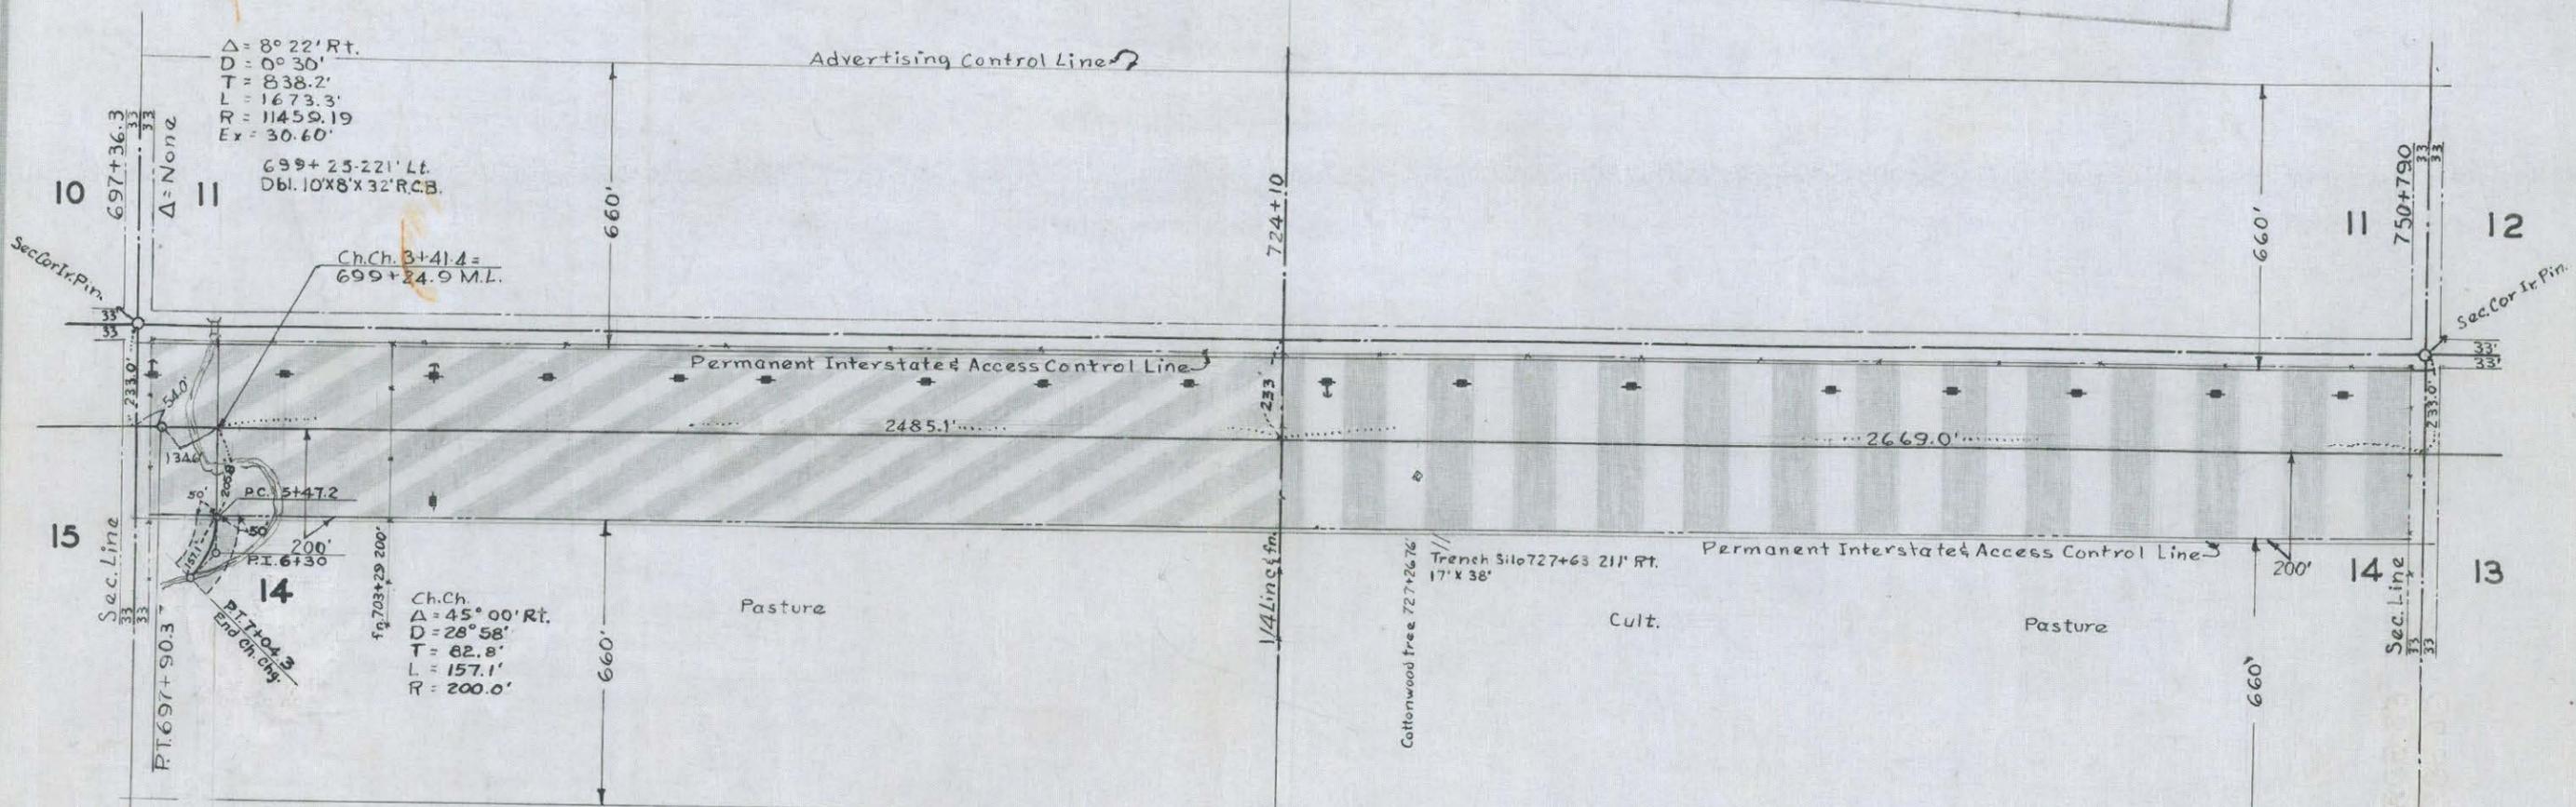

NW1/4-14-139-83
 Parcel No. 52 24.25 Ac.
 Raphael and Katherine Miller h/w
 Mandan, North Dakota
 Parcel No. 53 0.37 Ac.
 Temp. Ch.Ch. Easement
 Owner same as Parcel No. 52

NE1/4-14-139-83
 Parcel No. 54 24.21 Ac.
 Simon Vogel
 Mandan, North Dakota

This document was originally issued and sealed by Robert E. King, Registration Number LS 1001 on _____ and the original document is stored at the County Recorders Office

NORTH DAKOTA
 STATE HIGHWAY DEPARTMENT
RIGHT OF WAY PLAT
 PROJECT NO. I-IG-94-4(3)
 MORTON COUNTY
 APPROVED *Robert E. King*
 RIGHT OF WAY ENGINEER
 SCALE 1" = 400' DATE 7-31-63

MADE BY L. E. Christensen DATE 11-26-62 CHECKED BY J.W.B. DATE 6-6-63

Parcel No. 51

All right and control over the erection, location or maintenance of billboards, signs or any form of advertising whatsoever, upon all that portion of the S $\frac{1}{2}$ of Sec. 11, Twp. 139 N., Rge. 83 W., in Morton County, North Dakota within 660 feet of the controlled access limits of Project I-IG-94-4(3), Morton County, North Dakota as shown on right of way plats on file in the office of the Register of Deeds of Morton County, North Dakota.

Parcel No. 52

All that portion of the NW $\frac{1}{4}$ of Sec. 14, Twp. 139 N., Rge. 83 W., 5th P. M., lying within a strip of land 200 ft. wide, located on the southerly side of and measured at right angles to the following described highway centerline as surveyed and staked:

Beginning at a point 233.0 ft. south of the northeast corner of said NW $\frac{1}{4}$; thence running west 2619.7 ft., thence along a 0°30' curve to the left 54.0 ft. more or less, until said strip crosses the west line of said NW $\frac{1}{4}$; also including all that portion lying northerly of the above described strip, excepting all that portion lying within 33 feet of the section lines.

Tract contains 24.25 acres, more or less, and is shown on plat as shaded area.

Also including all right of access, being the right of ingress to and egress from the remaining property to and from the highway right of way as shown on the right of way plat.

And including all right and control over the erection, location or maintenance of billboards, signs or any form of advertising whatsoever, upon all that portion of the NW $\frac{1}{4}$ of Sec. 14, Twp. 139 N., Rge. 83 W., in Morton County, North Dakota within 660 feet of the controlled access limits of Project I-IG-94-4(3), Morton County, North Dakota as shown on right of way plats on file in the office of the Register of Deeds of Morton County, North Dakota.

~~Parcel No. 53~~

~~All that portion of the NW $\frac{1}{4}$ of Sec. 14, Twp. 139 N., Rge. 83 W., 5th P. M., lying within a strip of land 100 ft. wide, lying 75.0 ft. on the westerly side and 50.0 ft. on the easterly side of the following described channel change centerline as surveyed and staked over and across said NW $\frac{1}{4}$:~~

~~Beginning at a point 233.0 ft. south, thence 2485.1 ft. west and 200.0 ft. south of northeast corner of said NW $\frac{1}{4}$, thence running south 173.6 ft., thence along a 14°00' curve to the left 350.0 ft.~~

~~Tract contains 1.53 acres, more or less, and is shown on plat as shaded area.~~

Parcel No. 54

The north 433.0 ft. of the NE $\frac{1}{4}$ of Sec. 14, Twp. 139 N., Rge. 83 W., 5th P. M., excepting all that portion lying within 33 feet of the section lines.

Tract contains 24.21 acres, more or less, and is shown on plat as shaded area.

Also including all right of access, being the right of ingress to and egress from the remaining property to and from the highway right of way as shown on the right of way plat.

And including all right and control over the erection, location or maintenance of billboards, signs or any form of advertising whatsoever, upon all that portion of the NE $\frac{1}{4}$ of Sec. 14, Twp. 139 N., Rge. 83 W., in Morton County, North Dakota within 660 feet of the *controlled Access* limits of Project I-IG-94-4(3), Morton County, North Dakota as shown on right of way plats on file in the office of the Register of Deeds of Morton County, North Dakota.

SYSTEM DIST. HWY. AGREEMENT

SECTION "J" PROJECT NO. I-IG-94-4(3)
SUPPLEMENT TO PLAT NO. 14 OF 22

Parcel No. 53

15

All that portion of the NW $\frac{1}{4}$ of Sec. 14, Twp. 139 N., Rge. 83 W., 5th P. M., lying within a strip of land 100.0 ft. wide, lying 50.0 ft. on both sides of and measured at right angles to the following described channel change centerline as surveyed and staked:

Beginning at a point 433.0 ft. south, and 2485.1 ft. west from the northeast corner of said NW $\frac{1}{4}$, thence running south 5.8 ft., thence along a 28°58' curve to the right 157.1 ft.

Tract contains 0.37 acres, more or less, and is shown on plat as shaded area.



SW1/4-12-139-83
 Parcel No.55 1.32 Ac.
 Simon Vogel
 Mandan, North Dakota


PROJ. NO.	PARCEL	PLAT NO.	SUPPLEMENTS
I-IG-94-4 (3)	55-61	15 OF 22	TWO

SECTION "J"

Added Parcel No.57A 4-17-64 W.F.U.

SE1/4-12-139-83
 Parcel No.56 16.98 Ac.
 William Schleicher
 Mandan, North Dakota
 Parcel No.57 1.61 Ac.
 Temp. Borrow Easement (clay)
 Owner same as Parcel No.56
 Parcel No.58 2.98 Ac.
 Temp. Slope Easement & Permanent Maintenance
 Owner same as Parcel No.56
 Parcel No.57A 3.56 Ac.
 Temp. Borrow Easement
 Owner same as Parcel No.56

NOTE
 INSTALL PIPE CULVERT
 793+63 48" x 342'

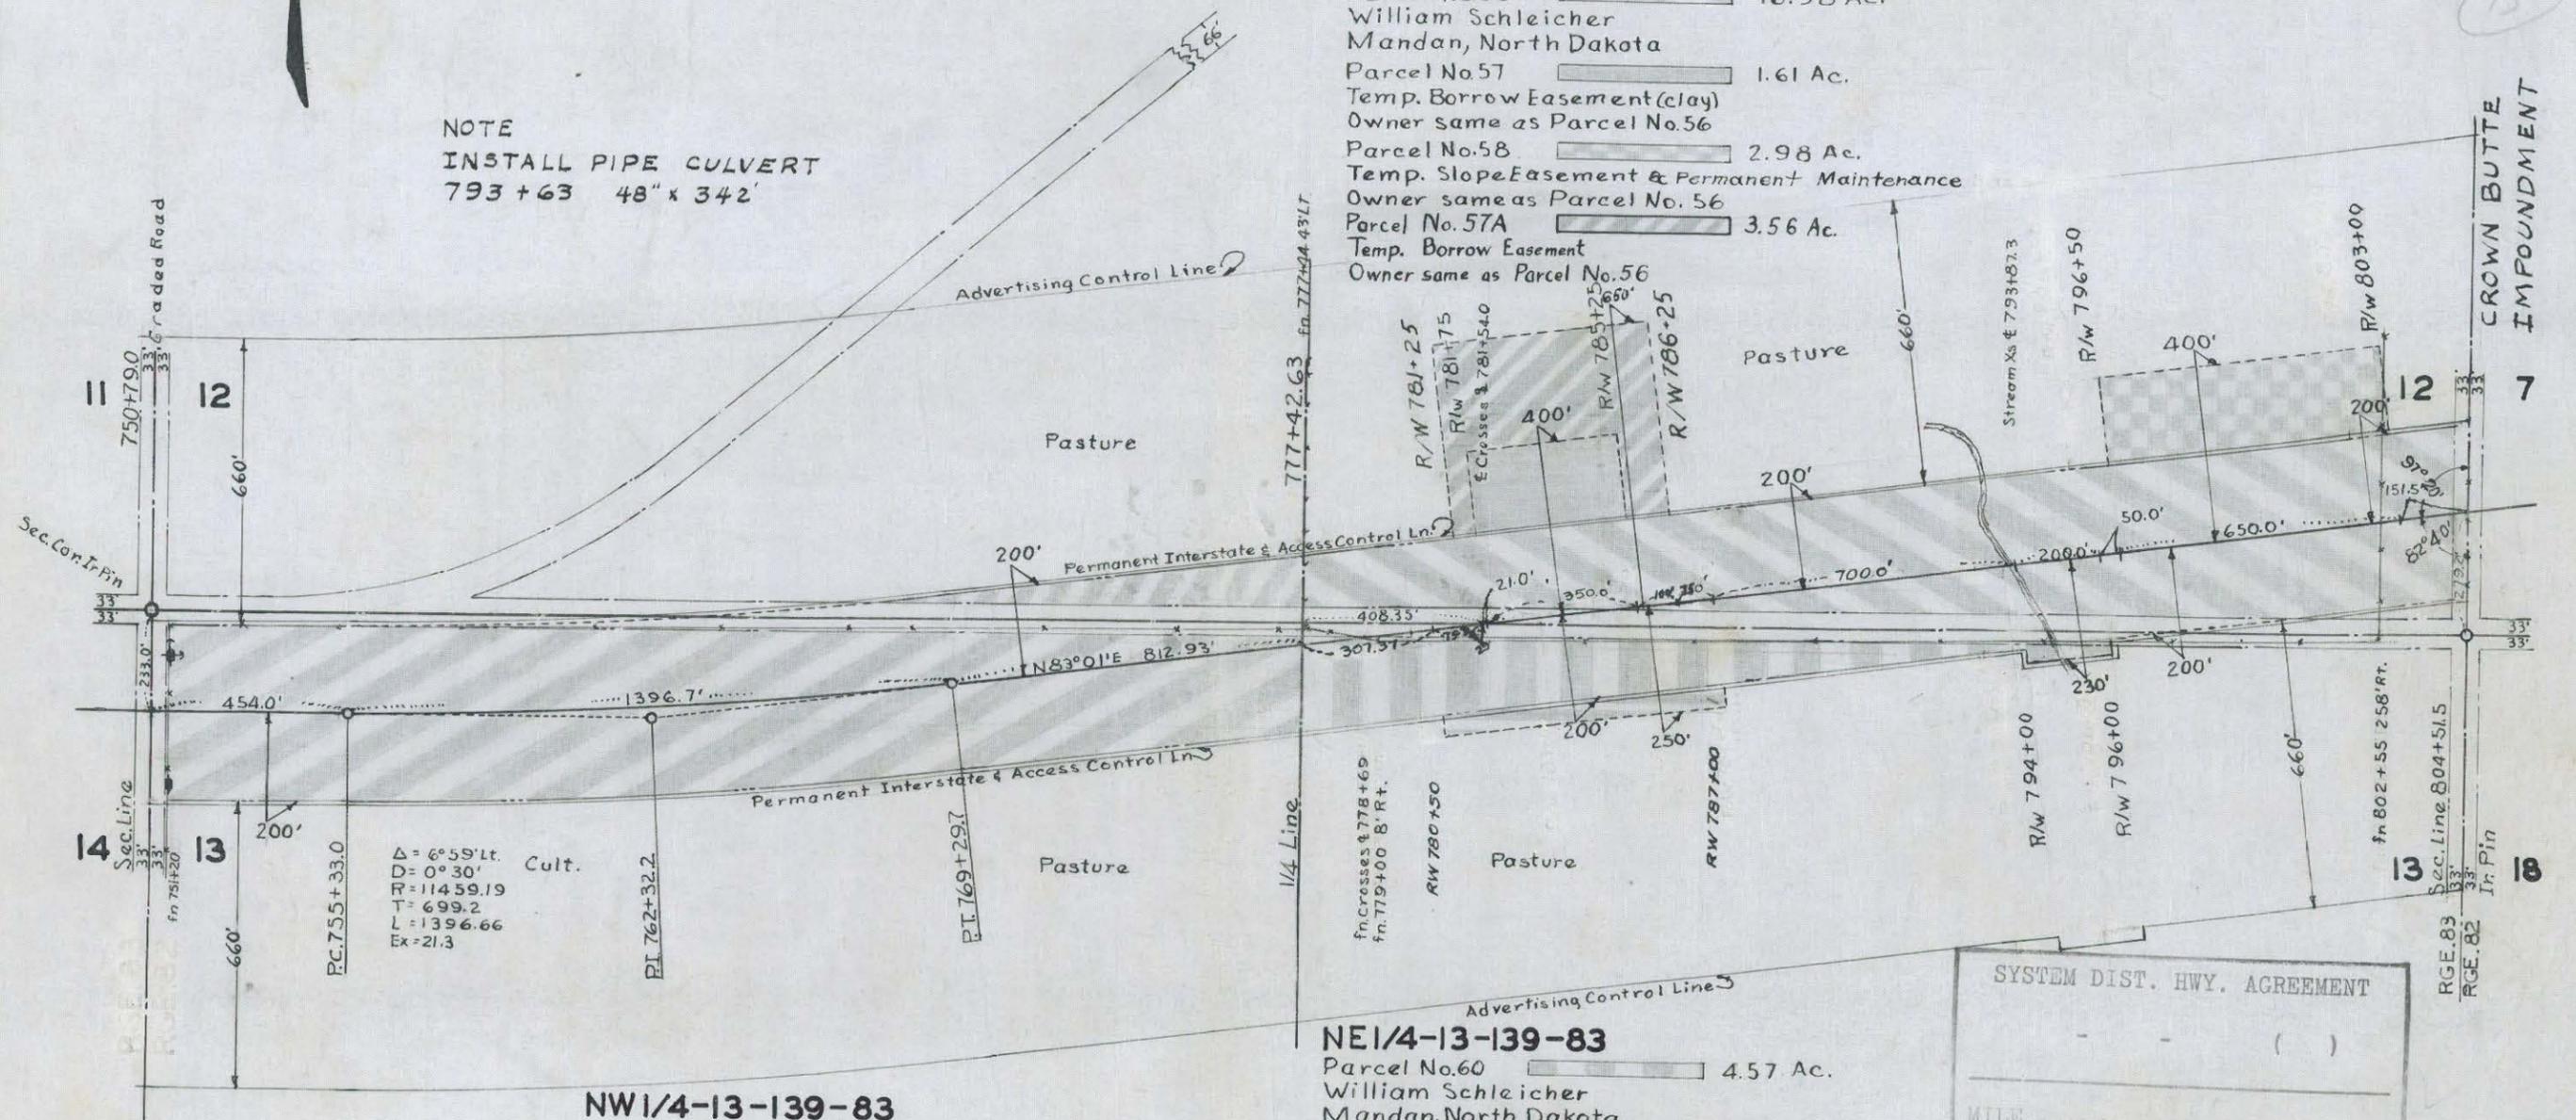

NW1/4-13-139-83
 Parcel No.59 20.73 Ac.
 Joseph Stein
 Mandan, North Dakota

NE1/4-13-139-83
 Parcel No.60 4.57 Ac.
 William Schleicher
 Mandan, North Dakota
 Parcel No.61 0.75 Ac.
 Temp. Waste Easement
 Owner same as Parcel No.60

MADE BY L.E. Christensen DATE 11-27-62 CHECKED BY J.W.B. DATE 6-7-63

SYSTEM DIST. HWY. AGREEMENT

MILE _____

NORTH DAKOTA
 STATE HIGHWAY DEPARTMENT

RIGHT OF WAY PLAT

PROJECT NO. **I-IG-94-4 (3)**

MORTON COUNTY

APPROVED *Robert E. King*
 RIGHT OF WAY ENGINEER

This document was originally issued and sealed by Robert E. King, Registration Number LS 1001 on ___/___/___ and the original document is stored at the County Recorders Office

SCALE 1" = 400' DATE **7-31-63**

Parcel No. 55

All that portion of the SW $\frac{1}{4}$ of Sec. 12, Twp. 139 N., Rge. 83 W., 5th P. M., lying within a strip of land 200.0 ft. wide, located on the northerly side of and measured at right angles to the following described highway centerline as surveyed and staked:

Beginning at a point 233.0 ft. south of the southwest corner of said SW $\frac{1}{4}$; thence running east 454.0 ft., thence along a 0°30' curve to the left 1396.7 ft., thence N 83°01'E 812.93 ft., more or less, until said strip crosses the east line of said NW $\frac{1}{4}$, excepting all that portion lying within 33 feet of the section line.

Tract contains 1.32 acres, more or less, and is shown on plat as shaded area. Also including all right of access, being the right of ingress to and egress from the remaining property to and from the highway right of way as shown on the right of way plat.

And including all right and control over the erection, location or maintenance of billboards, signs or any form of advertising whatsoever, upon all that portion of the SW $\frac{1}{4}$ of Sec. 12, Twp. 139 N., Rge. 83 W., in Morton County, North Dakota within 660 feet of the controlled access limits of Project I-IG-94-4(3), Morton County, North Dakota as shown on right of way plats on file in the office of the Register of Deeds of Morton County, North Dakota.

Parcel No. 56

All that portion of the SE $\frac{1}{4}$ of Sec. 12, Twp. 139 N., Rge. 83 W., 5th P. M., lying within a strip of land 400 ft. wide, lying 200 ft. on each side of the following described highway centerline as surveyed and staked over and across said SE $\frac{1}{4}$:

Beginning at a point 279.2 ft. north of the southeast corner of said SE $\frac{1}{4}$; thence running S 83°01'W until said strip crosses the west and south lines of said SE $\frac{1}{4}$; excepting all that portion lying within 33 feet of the section lines.

Tract contains 16.98 acres, more or less, and is shown on plat as shaded area.

Also including all right of access, being the right of ingress to and egress from the remaining property to and from the highway right of way as shown on the right of way plat.

And including all right and control over the erection, location or maintenance of billboards, signs or any form of advertising whatsoever, upon all that portion of the SE $\frac{1}{4}$ of Sec. 12, Twp. 139 N., Rge. 83 W., in Morton County, North Dakota within 660 feet of the controlled access limits of Project I-IG-94-4(3), Morton County, North Dakota as shown on right of way plats on file in the office of the Register of Deeds of Morton County, North Dakota.

Parcel No. 57

All that portion of the SE $\frac{1}{4}$ of Sec. 12, Twp. 139 N., Rge. 83 W., 5th P. M., lying within a strip of land located on the northerly side of and measured at right angles to the following described highway centerline as surveyed and staked:

Beginning at a point 279.2 ft. north of the southeast corner of said SE $\frac{1}{4}$; where said strip is 200.0 ft. wide; thence running S 83°01'W 1926.5 ft. more or less to a point where said strip changes to 400.0 ft. in width; thence continuing S 83°01'W 350.0 ft. more or less to a point where said strip changes to 200.0 ft. in width; thence continuing S 83°01'W until said strip crosses the west line of said SE $\frac{1}{4}$; excepting all that portion lying within 200.0 ft. of the above described highway centerline.

Tract contains 1.61 acres, more or less, and is shown on plat as shaded area.

SYSTEM DIST. HWY. AGREEMENT

MTLE

SECTION "J" PROJECT NO. I-IG-94-4(3)
1ST SUPPLEMENT TO PLAT NO. 15 OF 22

Parcel No. 58

All that portion of the SE $\frac{1}{4}$ of Sec. 12, Twp. 139 N., Rge. 83 W., 5th P. M., lying within a strip of land located on the northerly side of and measured at right angles to the following described highway centerline as surveyed and staked:

Beginning at a point 279.2 ft. north of the southeast corner of said SE $\frac{1}{4}$; where said strip is 200.0 ft. wide; thence running S 83°01'W 151.5 ft. more or less to a point where said strip changes to 400.0 ft. in width, thence continuing S 83°01'W 650.0 ft. more or less to a point where said strip changes to 200.0 ft. in width, thence continuing S 83°01'W until said strip crosses the west line of said SE $\frac{1}{4}$, excepting all that portion lying within 200.0 ft. of the above described highway centerline.

Tract contains 2.98 acres, more or less, and is shown on plat as shaded area.

Parcel No. 59

All that portion of the NW $\frac{1}{4}$ of Sec. 13, Twp. 139 N., Rge. 83 W., 5th P. M., lying within a strip of land 200.0 ft. wide, located on the southerly side of and measured at right angles to the following described highway centerline as surveyed and staked:

Beginning at a point 233.0 ft. south of the northwest corner of said NW $\frac{1}{4}$; thence running east 454.0 ft., thence along a 0°30' curve to the left 1396.7 ft., thence N 83°01'E 812.93 ft. more or less until said strip crosses the east line of said NW $\frac{1}{4}$; also including all that portion lying northerly of the above described highway centerline, excepting all that portion lying within 33 feet of the section lines.

Tract contains 20.73 acres, more or less, and is shown on plat as shaded area. And including all right of access, being the right of ingress to and egress from the remaining property to and from the highway right of way as shown on the right of way plat.

And including all right and control over the erection, location, or maintenance of billboards, signs or any form of advertising whatsoever, upon all that portion of the NW $\frac{1}{4}$ of Sec. 13, Twp. 139 N., Rge. 83 W., in Morton County, North Dakota within 660 feet of the controlled access limits of Project I-IG-94-4(3), Morton County, North Dakota as shown on right of way plats on file in the office of the Register of Deeds of Morton County, North Dakota.

Parcel No. 60

All that portion of the NE $\frac{1}{4}$ of Sec. 13, Twp. 139 N., Rge. 83 W., 5th P. M., lying within a strip of land located on the southerly side of and measured at right angles to the following described highway centerline as surveyed and staked:

Beginning at a point 279.2 ft. north of the northeast corner of said NE $\frac{1}{4}$; where said strip is 200.0 ft. wide, thence running S 83°01'W 851.5 ft. more or less to a point where said strip changes to 230.0 ft. in width; thence continuing S 83°01'W 200.0 ft. more or less to a point where said strip changes to 200.0 ft. in width; thence continuing S 83°01'W until said strip crosses the west line of said NE $\frac{1}{4}$, also including all that portion lying northerly of the above described strip, excepting all that portion lying within 33 feet of the section line.

Tract contains 4.57 acres, more or less, and is shown on plat as shaded area.

Also including all right of access, being the right of ingress to and egress from the remaining property to and from the highway right of way as shown on the right of way plat.

And including all right and control over the erection, location or maintenance of billboards, signs or any form of advertising whatsoever, upon all that portion of the NE $\frac{1}{4}$ of Sec. 13, Twp. 139 N., Rge. 83 W., in Morton County, North Dakota within 660 feet of the controlled access limits of Project I-IG-94-4(3), Morton County,

Parcel No. 60 Continued

North Dakota as shown on right of way plats on file in the office of the Register of Deeds of Morton County, North Dakota.

Parcel No. 61

All that portion of the NE $\frac{1}{4}$ of Sec. 13, Twp. 139 N., Rge. 83 W., 5th P. M., lying within a strip of land located on the southerly side of and measured at right angles to the following described highway centerline as surveyed and staked: Beginning at a point 279.2 ft. north of the northeast corner of said NE $\frac{1}{4}$, where said strip is 200.0 ft. wide, thence running S 83°01'W 1751.5 ft. more or less to a point where said strip changes to 250.0 ft. in width, thence continuing S 83°01'W 650.0 ft. more or less to a point where said strip changes to 200.0 ft. in width, thence continuing S 83°01'W until said strip crosses the west line of said NE $\frac{1}{4}$; excepting all that portion lying within 200.0 ft. of the above described centerline.

Tract contains 0.75 acres, more or less, and is shown on plat as shaded area.

Parcel No. 57A

All that portion of the SE $\frac{1}{4}$ of Sec. 12, Twp. 139 N., Rge. 83 W., 5th P. M., lying within a strip of land located on the northerly side of and measured at right angles to the following described highway centerline as surveyed and staked: Beginning at a point 279.2 ft. north of the southeast corner of said SE $\frac{1}{4}$; where said strip is 200.0 ft. wide, thence running S 83°01'W 1826.5 ft. more or less to a point where said strip changes to 650.0 ft. in width, thence continuing S 83°01'W 500.0 ft. more or less to a point where said strip changes to 200.0 ft. in width, thence continuing S 83°01'W until said strip crosses the west line of said SE $\frac{1}{4}$, excepting all that portion lying within 200.0 ft. of the above described highway centerline and excepting all that portion known as Parcel No. 57 and previously acquired.

Tract contains 3.56 acres, more or less, and is shown on plat as shaded area.

SECTION "J" PROJECT NO. I-IG-94-4(3)
2ND SUPPLEMENT TO PLAT NO. 15 OF 22

15

SYSTEM DIST. HWY. AGREEMENT	
	()
MILE _____	



SW1/4-7-139-82

Parcel No. 62 23.93 Ac.
Emil Zuger
Mandan, N. D.

Parcel No. 63 2.29 Ac.
Temp. slope Easement & Permanent Maintenance
Owner same as Parcel No. 62

SE1/4-7-139-82

Parcel No. 64 23.51 Ac.
The State of North Dakota

Contract for Deed to
Joe G. Stein
Mandan, N. D.

Parcel No. 65 0.83 Ac.
Temp. slope Easement & Permanent Maintenance
Owner same as Parcel No. 64

PROJ. NO.	PARCEL	PLAT NO.	SUPPLEMENTS
I-IG-94-4 (3)	62-66	16 OF 22	TWO

SECTION "J"


15

DATE 6-10-63

CHECKED BY J.W.B.

DATE 11-27-62

MADE BY L.E. Christensen

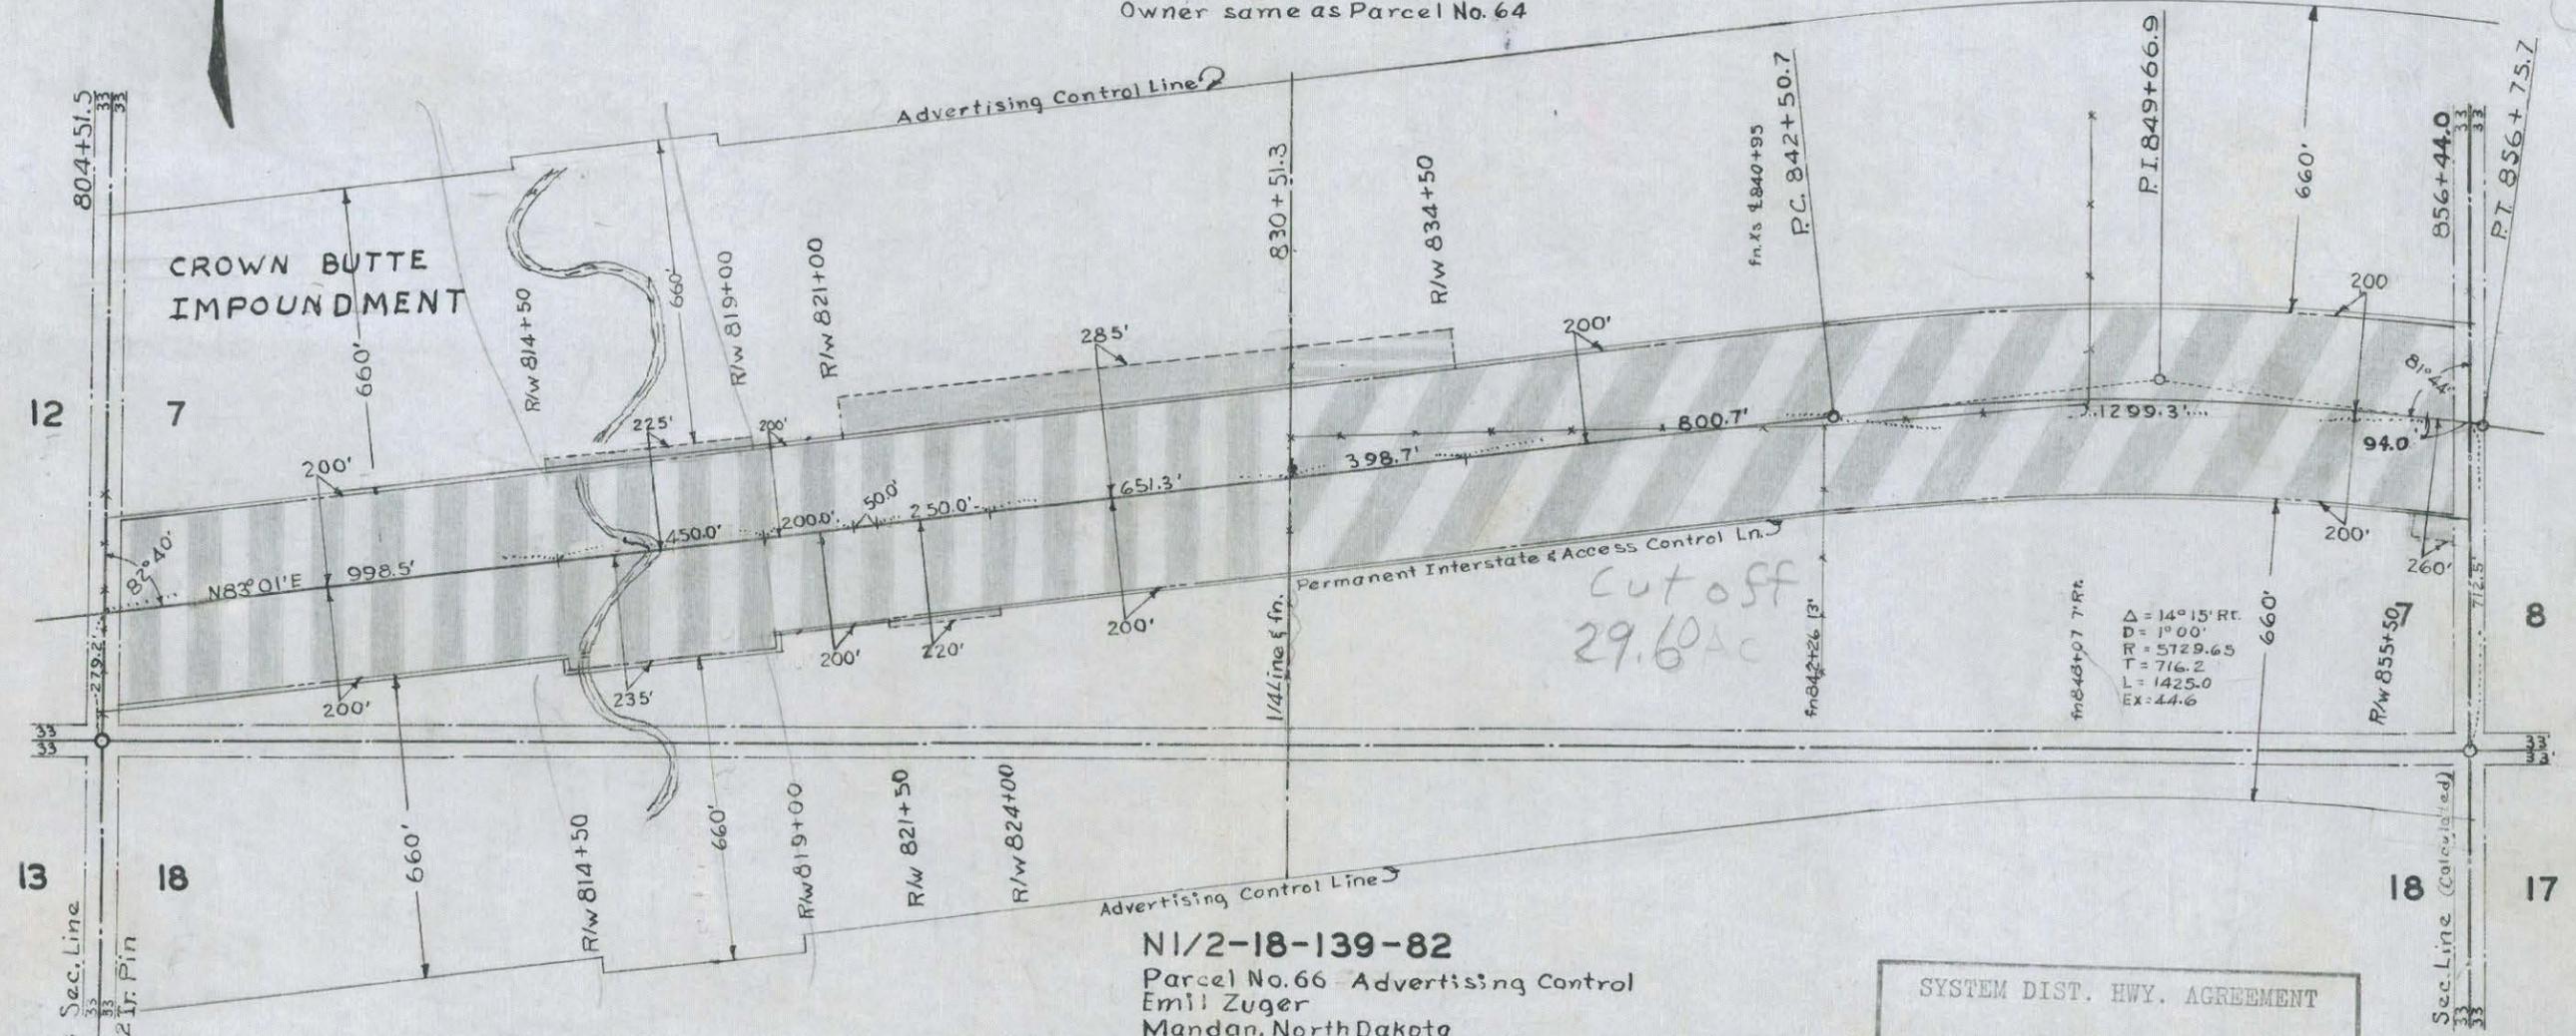

NE1/2-18-139-82
Parcel No. 66 - Advertising Control
Emil Zuger
Mandan, North Dakota

NOTE
 INSTALL PIPE CULVERTS
 815+00 84" x 42' INTO 60" x 220' INTO 96" x 30'
 851+60 STRUCTURAL PLATE PIPE 78" x 286'
 867+43 STRUCTURAL PLATE PIPE 72" x 410'

SYSTEM DIST. HWY. AGREEMENT

MILE _____

This document was originally issued and sealed by Robert E. King, Registration Number LS 1001 on ___/___/___ and the original document is stored at the County Recorders Office

NORTH DAKOTA
 STATE HIGHWAY DEPARTMENT
RIGHT OF WAY PLAT
 PROJECT NO. I-IG-94-4(3)
 MORTON COUNTY
 APPROVED *Robert E. King*
 RIGHT OF WAY ENGINEER

SCALE 1" = 400' DATE 7-31-63

Parcel No. 62

All that portion of the SW $\frac{1}{4}$ of Sec. 7, Twp. 139 N., Rge. 82 W., 5th P. M., lying within a strip of land located on both sides of and measured at right angles to the following described highway centerline as surveyed and staked:

Beginning at a point 279.2 ft. north of the southwest corner of said SW $\frac{1}{4}$; where said strip is 400.0 ft. wide lying 200.0 ft. on both sides of said centerline, thence running N 83°01'E 998.5 ft. more or less to a point where said strip changes to 435.0 ft. in width, lying 200.0 ft. on the northerly side and 235.0 ft. on the southerly side of said centerline; thence continuing N 83°01'E 450.0 ft. more or less to a point where said strip changes to 400.0 ft. in width, lying 200.0 ft. on both sides of said centerline, thence continuing N 83°01'E 1151.3 ft. more or less until said strip crosses the east line of said SW $\frac{1}{4}$, excepting all that portion lying within 33 feet of the section line.

Tract contains 23.93 acres, more or less, and is shown on plat as shaded area.

Also including all right of access, being the right of ingress to and egress from the remaining property to and from the highway right of way as shown on the right of way plat.

And including all right and control over the erection, location or maintenance of billboards, signs or any form of advertising whatsoever, upon all that portion of the SW $\frac{1}{4}$ of Sec. 7, Twp. 139 N., Rge. 82 W., in Morton County, North Dakota within 660 feet of the controlled access limits of Project I-IG-94-4(3), Morton County, North Dakota as shown on right of way plats on file in the office of the Register of Deeds of Morton County, North Dakota.

~~Parcel No. 63~~

~~All that portion of the SW $\frac{1}{4}$ of Sec. 7, Twp. 139 N., Rge. 82 W., 5th P. M., lying within a strip of land located on both sides of and measured at right angles to the following described highway centerline as surveyed and staked:~~

~~Beginning at a point 279.2 ft. north of the southwest corner of said SW $\frac{1}{4}$; where said strip is 400.0 ft. wide lying 200.0 ft. on both sides of said centerline; thence running N 83°01'E 1648.5 ft. more or less to a point where said strip changes to 485.0 ft. in width, lying 285.0 ft. on the northerly side and 200.0 ft. on the southerly side of said centerline, thence continuing N 83°01'E 50.0 ft. more or less to a point where said strip changes to 505.0 ft. in width, lying 285.0 ft. on the northerly side and 220.0 ft. on the southerly side of said centerline, thence continuing N 83°01'E 250.0 ft. more or less to a point where said strip changes to 485.0 ft. in width, lying 285.0 ft. on the northerly side and 200.0 ft. on the southerly side of said centerline, thence continuing N 83°01'E 651.3 ft. more or less until said strip crosses the east line of said SW $\frac{1}{4}$; excepting all that portion lying within a strip of land 400.0 ft. wide, lying 200.0 ft. on both sides of the above described highway centerline.~~

~~Tract contains 2.03 acres, more or less, and is shown on plat as shaded area.~~

Parcel No. 64

All that portion of the SE $\frac{1}{4}$ of Sec. 7, Twp. 139 N., Rge. 82 W., 5th P. M., lying within a strip of land 400.0 ft. wide, lying 200.0 ft. on both sides of the following described highway centerline as surveyed and staked over and across said SE $\frac{1}{4}$:

Beginning at a point 279.2 ft. north and 2599.8 ft. N 83°01'E from the southwest corner of said Section 7; thence running N 83°01'E 1199.4 ft., thence along a 1°00' curve to the right 1393.3 ft. more or less to a point where said strip crosses the east line of said SE $\frac{1}{4}$, excepting all that portion lying within 33 feet of the section line.

Tract contains 23.51 acres, more or less, and is shown on plat as shaded area.

SYSTEM DIST. HWY. AGREEMENT

SECTION "J" PROJECT NO. I-IG-94-4(3)
1ST SUPPLEMENT TO PLAT NO. 16 OF 22

Parcel No. 64 Continued

15

Also including all right of access, being the right of ingress to and egress from the remaining property to and from the highway right of way as shown on the right of way plat.

And including all right and control over the erection, location or maintenance of billboards, signs or any form of advertising whatsoever, upon all that portion of the SE $\frac{1}{4}$ of Sec. 7, Twp. 139 N., Rge. 82 W., in Morton County, North Dakota within 660 feet of the controlled access limits of Project I-IG-94-4(3), Morton County, North Dakota as shown on right of way plats on file in the office of the Register of Deeds of Morton County, North Dakota.

Parcel No. 65

All that portion of the SE $\frac{1}{4}$ of Sec. 7, Twp. 139 N., Rge. 82 W., 5th P. M., lying within a strip of land located on both sides of and measured at right angles to the following described highway centerline as surveyed and staked:

Beginning at a point 279.2 ft. north and 2599.8 ft. N 83°01'E from the southwest corner of said Section 7; where said strip is 485.0 ft. wide lying 285.0 ft. on the northerly side and 200.0 ft. on the southerly side of said highway centerline, thence running N 83°01'E 398.7 ft. more or less to a point where said strip changes to 400.0 ft. in width, lying 200.0 ft. on both sides of said centerline; thence running N 83°01'E 800.7 ft., thence along a 1°00' curve to the right 1299.3 ft. more or less to a point where said strip changes to 460.0 ft. in width, lying 200.0 ft. on the northerly side and 260.0 ft. on the southerly side of said centerline; thence continuing along said 1°00' curve to the right 94.0 ft. more or less until said strip crosses the east line of said SE $\frac{1}{4}$; excepting all that portion lying within a strip of land 400.0 ft. wide, lying 200.0 ft. on both sides of the above described centerline and all that portion lying within 33 feet of the section line.

Tract contains 0.83 acres, more or less, and is shown on plat as shaded area.

Parcel No. 66

All right and control over the erection, location or maintenance of billboards, signs or any form of advertising whatsoever, upon all that portion of the N $\frac{1}{2}$ of Sec. 18, Twp. 139 N., Rge. 82 W., in Morton County, North Dakota within 660 feet of the controlled access limits of Project I-IG-94-4(3), Morton County, North Dakota as shown on right of way plats on file in the office of the Register of Deeds of Morton County, North Dakota.

Parcel No. 63

All that portion of the SW $\frac{1}{4}$ of Sec. 7, Twp. 139 N., Rge. 82 W., 5th P. M., lying within a strip of land, located on both sides of and measured at right angles to the following described highway centerline as surveyed and staked:

Beginning at a point 279.2 ft. north of the southwest corner of said SW $\frac{1}{4}$; where said strip is 400.0 ft. wide lying 200.0 ft. on each side of said centerline; thence running N 83°01'E 998.5 ft., more or less, to a point where said strip changes to 425.0 ft. in width, lying 225.0 ft. on the northerly side and 200.0 ft. on the southerly side of said centerline, thence continuing N 83°01'E 450.0 ft., more or less, to a point where said strip changes to 400.0 ft. in width lying 200.0 ft. on both sides of said centerline; thence continuing N 83°01'E 200.0 ft., more or less, to a point where said strip changes to 485.0 ft. in width lying 285.0 ft. on the northerly side and 200.0 ft. on the southerly side of said centerline, thence continuing N 83°01'E 50.0 ft., more or less, to a point where said strip changes to 505.0 ft. in width, lying 285.0 ft. on the northerly side and 220.0 ft. on the southerly side of said centerline, thence continuing N 83°01'E 250.0 ft., more or less, to a point where said strip changes to 485.0 ft. in width, lying 285.0 ft. on the northerly side and 200.0 ft. on the southerly side of said centerline, thence continuing N 83°01'E 651.3 ft., more or less, until said strip crosses the east line of said SW $\frac{1}{4}$; excepting all that portion lying within a strip of land 400.0 ft. wide, lying 200.0 ft. on each side of the above described highway centerline.

Tract contains 2.29 acres, more or less, and is shown on plat as shaded area.

SECTION "J" PROJECT NO. I-IG-94-4(3)
2ND SUPPLEMENT TO PLAT NO. 16 OF 22

SYSTEM DIST. HWY. AGREEMENT
()
MILE _____

15

Δ = 14° 15' Rt.
 D = 1000'
 R = 5729.65
 T = 716.2'
 L = 1425.0'
 Ex = 44.6'



SW/4ANDWI/2SE1/4-8-139-82

Parcel No. 67 35.49 Ac.
 Joe and Caroline Schmidt h/w
 Mandan, N.D.

Contract for Deed to
 Leo J. Boehm Mandan, N.D.

Parcel No. 68 0.61 Ac.
 Temp. Slope Easement & Permanent Maintenance
 Owner same as Parcel No 67

Parcel No. 69 1.27 Ac.
 Temp. Waste Easement
 Owner same as Parcel No 67

PROJ. NO.	PARCEL	PLAT NO.	SUPPLEMENTS
I-IG-94-4 (3)	67-71	17 OF 22	ONE

SECTION "J"

Parcel No. 69A eliminated, 8-27-63, by F.J.S.

E1/2SE1/4-8-139-82


Parcel No. 70 8.22 Ac. (15)
 Eva and Thomas Pope h/w Mandan, N.D.
 Rose Mary and John Pope h/w Mandan, N.D.
 Clarence and Opal Gress h/w Odessa, Texas
 Anton Jr. and Lila Gress h/w Odessa, Texas

DATE 6-11-63

CHECKED BY J.W.B.

DATE 4-18-63

MADE BY L.E. Christensen

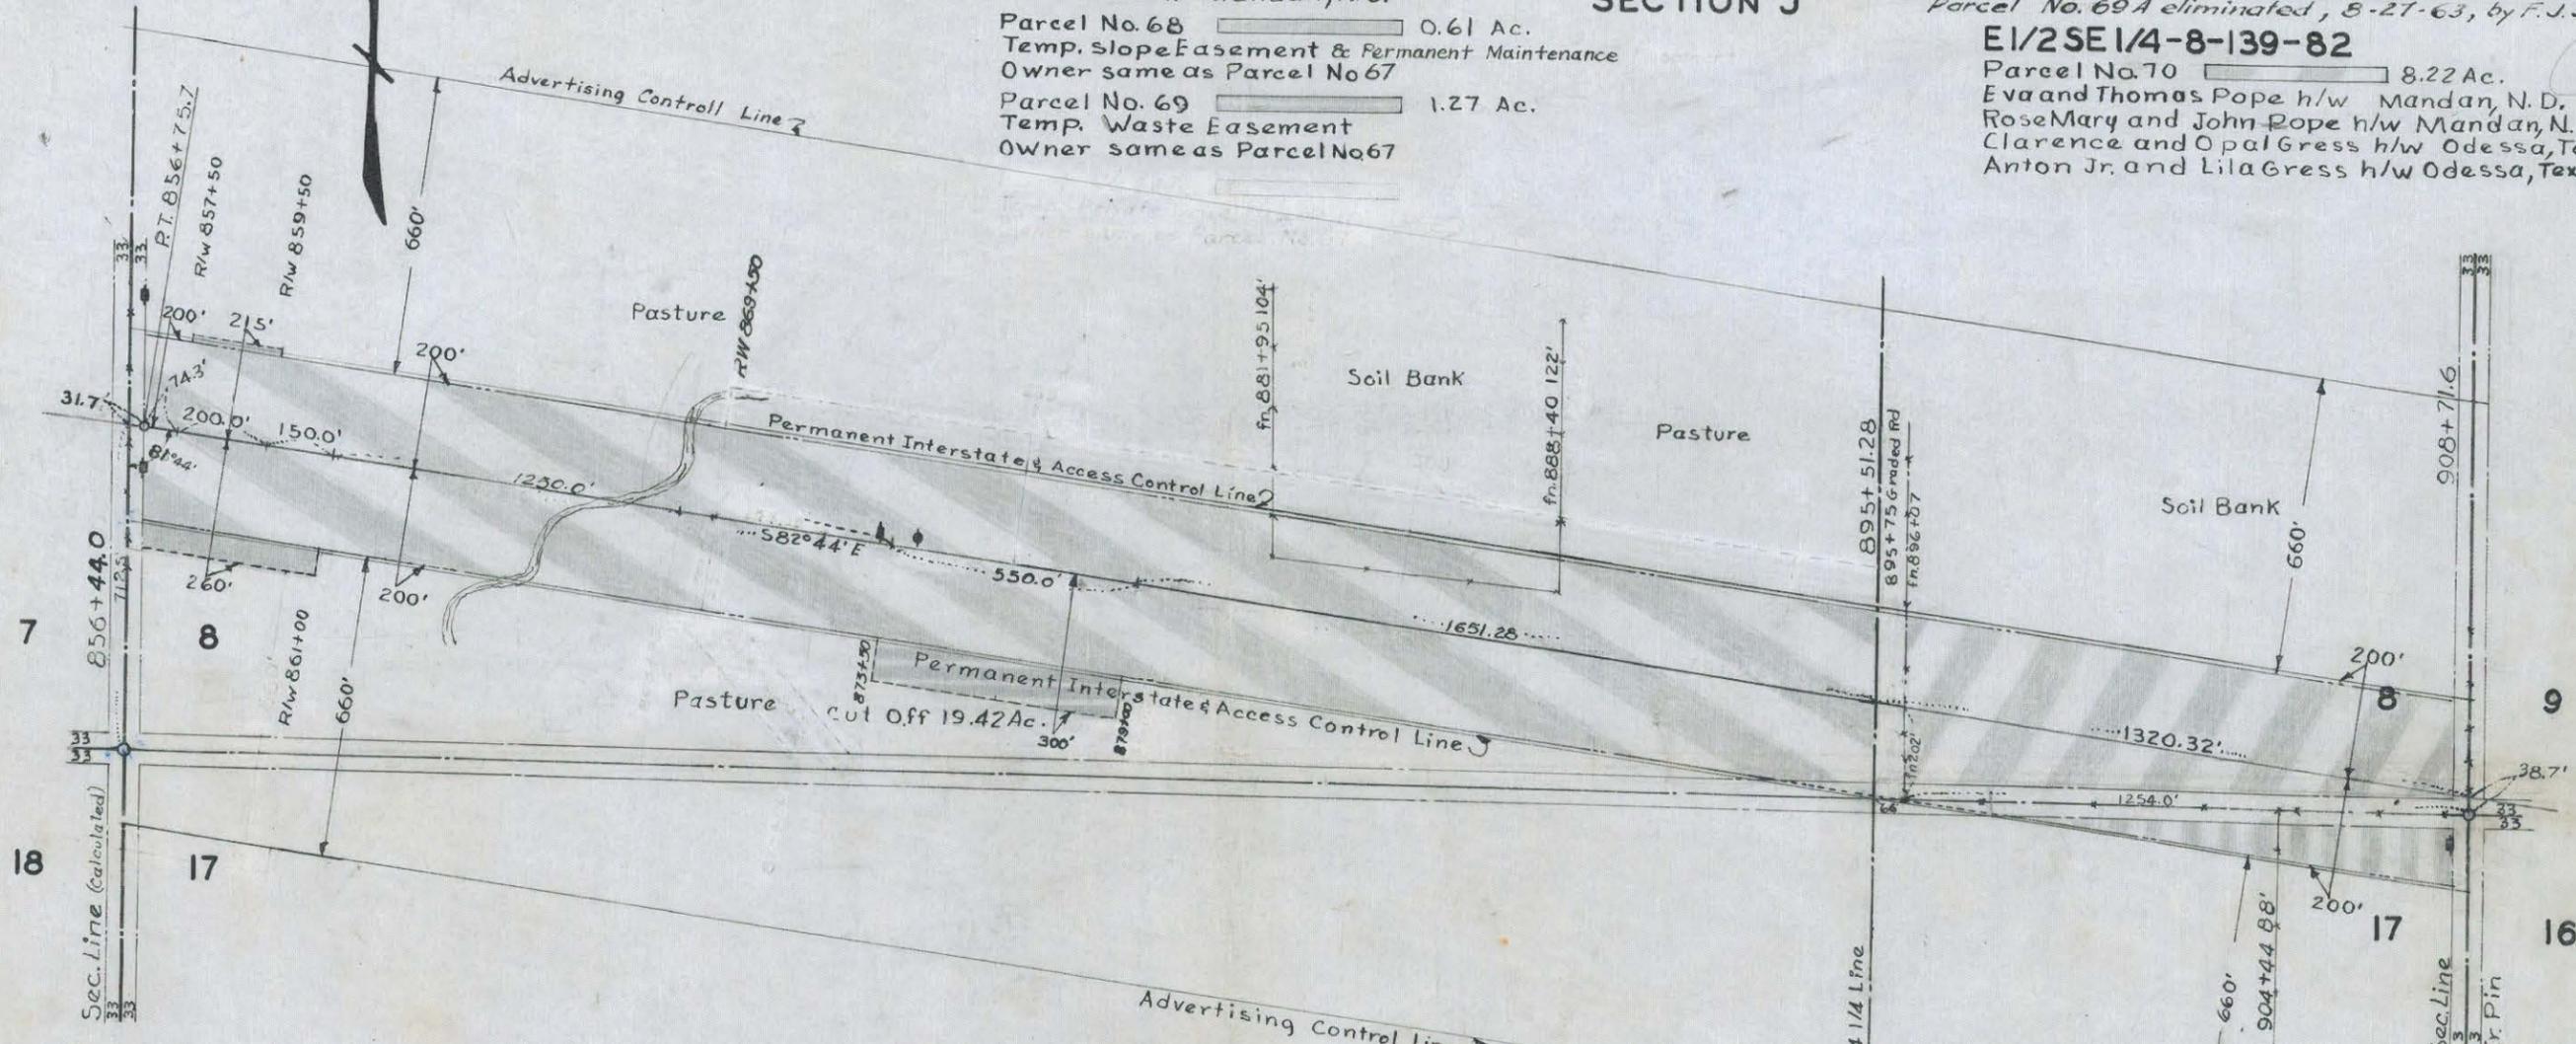

NOTE
 INSTALL THE INTERCHANGE
 370+00 TO 375+00 X 244' X 130'

NE1/2-17-139-82
 Parcel No. 71 1.42 Ac.
 Joe and Caroline Schmidt h/w
 Mandan, North Dakota
 Contract for Deed to
 Leo J. Boehm
 Mandan, N.D.

SYSTEM DIST. HWY. AGREEMENT

MILE _____

This document was originally issued and sealed by Robert E. King, Registration Number LS 1001 on ___/___/___ and the original document is stored at the County Recorders Office

NORTH DAKOTA
 STATE HIGHWAY DEPARTMENT

RIGHT OF WAY PLAT

PROJECT NO. **I-IG-94-4(3)**

MORTON COUNTY

APPROVED *Robert E. King*
 RIGHT OF WAY ENGINEER

SCALE 1" = 400'

DATE **7-31-63**

Parcel No. 67

All that portion of the SW $\frac{1}{4}$ and W $\frac{1}{2}$ SE $\frac{1}{4}$ of Sec. 8, Twp. 139 N., Rge. 82 W., 5th P. M., lying within a strip of land 400.0 ft. wide, lying 200.0 ft. on both sides of the following described highway centerline as surveyed and staked over and across said SW $\frac{1}{4}$ and W $\frac{1}{2}$ SE $\frac{1}{4}$:

Beginning at a point 38.7 ft. north and 1320.32 ft. N 82°44'W; from the southeast corner of said Section 8; thence running N 82°44'W 3875.58 ft., thence along a 1°00' curve to the left 31.7 ft. more or less until said strip crosses the west line of said Section 8, excepting all that portion lying within 33 feet of the section lines.

Tract contains 35.49 acres, more or less, and is shown on plat as shaded area.

Also including all right of access, being the right of ingress to and egress from the remaining property to and from the highway right of way as shown on the right of way plat.

And including all right and control over the erection, location or maintenance of billboards, signs or any form of advertising whatsoever, upon all that portion of the SW $\frac{1}{4}$ and W $\frac{1}{2}$ SE $\frac{1}{4}$ of Sec. 8, Twp. 139 N., Rge. 82 W., in Morton County, North Dakota within 660 feet of the controlled access limits of Project I-IG-94-4(3), Morton County, North Dakota as shown on right of way plats on file in the office of the Register of Deeds of Morton County, North Dakota.

Parcel No. 68

All that portion of the SW $\frac{1}{4}$ and W $\frac{1}{2}$ SE $\frac{1}{4}$ of Sec. 8, Twp. 139 N., Rge. 82 W., 5th P. M., lying within a strip of land located on both sides of and measured at right angles to the following described highway centerline as surveyed and staked:

Beginning at a point 38.7 ft. north and 4771.6 ft. N 82°44'W; from the southeast corner of said Section 8; where said strip is 460.0 ft. wide lying 200.0 ft. on the northerly side and 260.0 ft. on the southerly side of said centerline, thence running N 82°44'W 150.0 ft. more or less to a point where said strip changes to 475.0 ft. in width, lying 215.0 ft. on the northerly side and 260.0 ft. on the southerly side of said centerline; thence continuing N 82°44'W 200.0 ft. more or less to a point where said strip changes to 460.0 ft. in width, lying 200.0 ft. on the northerly side and 260.0 ft. on the southerly side of said centerline; thence continuing N 82°44'W 74.3 ft., thence along a 1°00' curve to the left 31.7 ft. more or less until said strip crosses the west line of said Section 8; excepting all that portion lying within 200.0 ft. on each side of the above described centerline and all that portion lying within 33 feet of the section line.

Tract contains 0.61 acres, more or less, and is shown on plat as shaded area.

Parcel No. 69

All that portion of the SW $\frac{1}{4}$ and W $\frac{1}{2}$ SE $\frac{1}{4}$ of Sec. 8, Twp. 139 N., Rge. 82 W., 5th P. M., lying within a strip of land located on the southerly side of and measured at right angles to the following described highway centerline as surveyed and staked:

Beginning at a point 38.7 ft. north and 2971.6 ft. N 82°44'W from the southeast corner of said Section 8; where said strip is 300.0 ft. wide, thence running N 82°44'W 550.0 ft. more or less to a point where said strip changes to 200.0 ft. in width; thence continuing N 82°44'W until said strip crosses the west line of said Section 8; excepting all that portion lying within 200.0 ft. of the above described centerline.

Tract contains 1.27 acres, more or less, and is shown on plat as shaded area.

Parcel No. 70

All that portion of the E $\frac{1}{2}$ SE $\frac{1}{4}$ of Sec. 8, Twp. 139 N., Rge. 82 W., 5th P.M.,

SYSTEM DIST. HWY. AGREEMENT

SECTION "J" PROJECT NO. I-IG-94-4(3)

SUPPLEMENT TO PLAT NO. 17 OF 22

Tie to point of beginning corrected on Parcel No. 69A, 8-14-63, F.J.S.
Parcel No. 69A eliminated, 8-27-63, F.J.S.

Parcel No. 70 Continued

MILE _____

lying within a strip of land 200.0 ft. wide, located on the northerly side of and measured at right angles to the following described highway centerline as surveyed and staked:

Beginning at a point 38.7 ft. north of the southeast corner of said SE $\frac{1}{4}$; thence running N 82°44'W 1320.32 ft. more or less until said strip crosses the west line of said E $\frac{1}{2}$ SE $\frac{1}{4}$; also including all that portion lying southerly of the above described centerline, excepting all that portion previously acquired for public highway right of way and all that portion lying within 33 feet of the section lines.

Tract contains 8.22 acres, more or less, and is shown on plat as shaded area.

Also including all right of access, being the right of ingress to and egress from the remaining property to and from the highway right of way as shown on the right of way plat.

And including all right and control over the erection, location or maintenance of billboards, signs or any form of advertising whatsoever, upon all that portion of the E $\frac{1}{2}$ SE $\frac{1}{4}$ of Sec. 8, Twp. 139 N., Rge. 82 W., in Morton County, North Dakota within 660 feet of the controlled access limits of Project I-IG-94-4(3), Morton County, North Dakota as shown on right of way plats on file in the office of the Register of Deeds of Morton County, North Dakota.

Parcel No. 71

All that portion of the N $\frac{1}{2}$ of Sec. 17, Twp. 139 N., Rge. 82 W., 5th P. M., lying within a strip of land 200.0 ft. wide, located on the southerly side of and measured at right angles to the following described highway centerline as surveyed and staked:

Beginning at a point 38.7 ft. north of the northeast corner of said N $\frac{1}{2}$; thence running N 82°44'W until said strip crosses the north line of said N $\frac{1}{2}$, excepting all that portion lying within 33 feet of the section lines.

Tract contains 1.42 acres, more or less, and is shown on plat as shaded area.

Also including all right of access, being the right of ingress to and egress from the remaining property to and from the highway right of way as shown on the right of way plat.

And including all right and control over the erection, location or maintenance of billboards, signs or any form of advertising whatsoever, upon all that portion of the N $\frac{1}{2}$ of Sec. 17, Twp. 139 N., Rge. 82 W., in Morton County, North Dakota within 660 feet of the controlled access limits of Project I-IG-94-4(3), Morton County, North Dakota as shown on right of way plats on file in the office of the Register of Deeds of Morton County, North Dakota.

~~Parcel No. 69A~~

~~All that portion of the SW $\frac{1}{4}$ & W $\frac{1}{2}$ SE $\frac{1}{4}$ of Sec. 8, Twp. 139 N., Rge. 82 W., 5th P.M., lying within a strip of land located on the northerly side of and measured at right angles to the following described highway centerline as surveyed and staked:~~

~~Beginning at a point 38.7 ft. north and 1320.32 ft. N 82°44'W from the southeast corner of said Section 8; where said strip is 285.0 ft. wide, thence running N 82°44'W 2601.28 ft., more or less, to a point where said strip changes to 200.0 ft. in width, thence continuing N 82°44'W until said strip crosses the west line of said Section 8, excepting all that portion lying within 200.0 ft. of the above described centerline;~~

~~Also including all that portion lying within a strip of land 100.0 ft. wide, lying 50.0 ft. on both sides of the following described private drive centerline: Beginning at a point 38.7 ft. north, thence 200.10 ft. N 82°44'W and 200.0 ft. S 7°16'W from the southeast corner of said Section 8; thence running S 32°58'W until said strip crosses the south line of said Section 8; excepting all that portion lying within 33 feet of the section line and is shown on plat as shaded area.~~

SI/2-9-139-82

Parcel No.72 3.71 Ac.
 Vincent J. Boehm
 Mandan, N.D.
 Parcel No.73 0.28 Ac.
 Temp. Waste Easement
 Owner same as Parcel No.72
 Parcel No.74 0.25 Ac.
 Temp slope Easement & Permanent Maintenance
 Owner same as Parcel No.72

PROJ. NO.	PARCEL	PLAT NO.	SUPPLEMENTS
I-IG-94-4(3)	72-79	18 OF 22	TWO

SECTION "J"


15

DATE 6-12-63

CHECKED BY J.W.B.

DATE 4-22-63

MADE BY L.E.Christensen

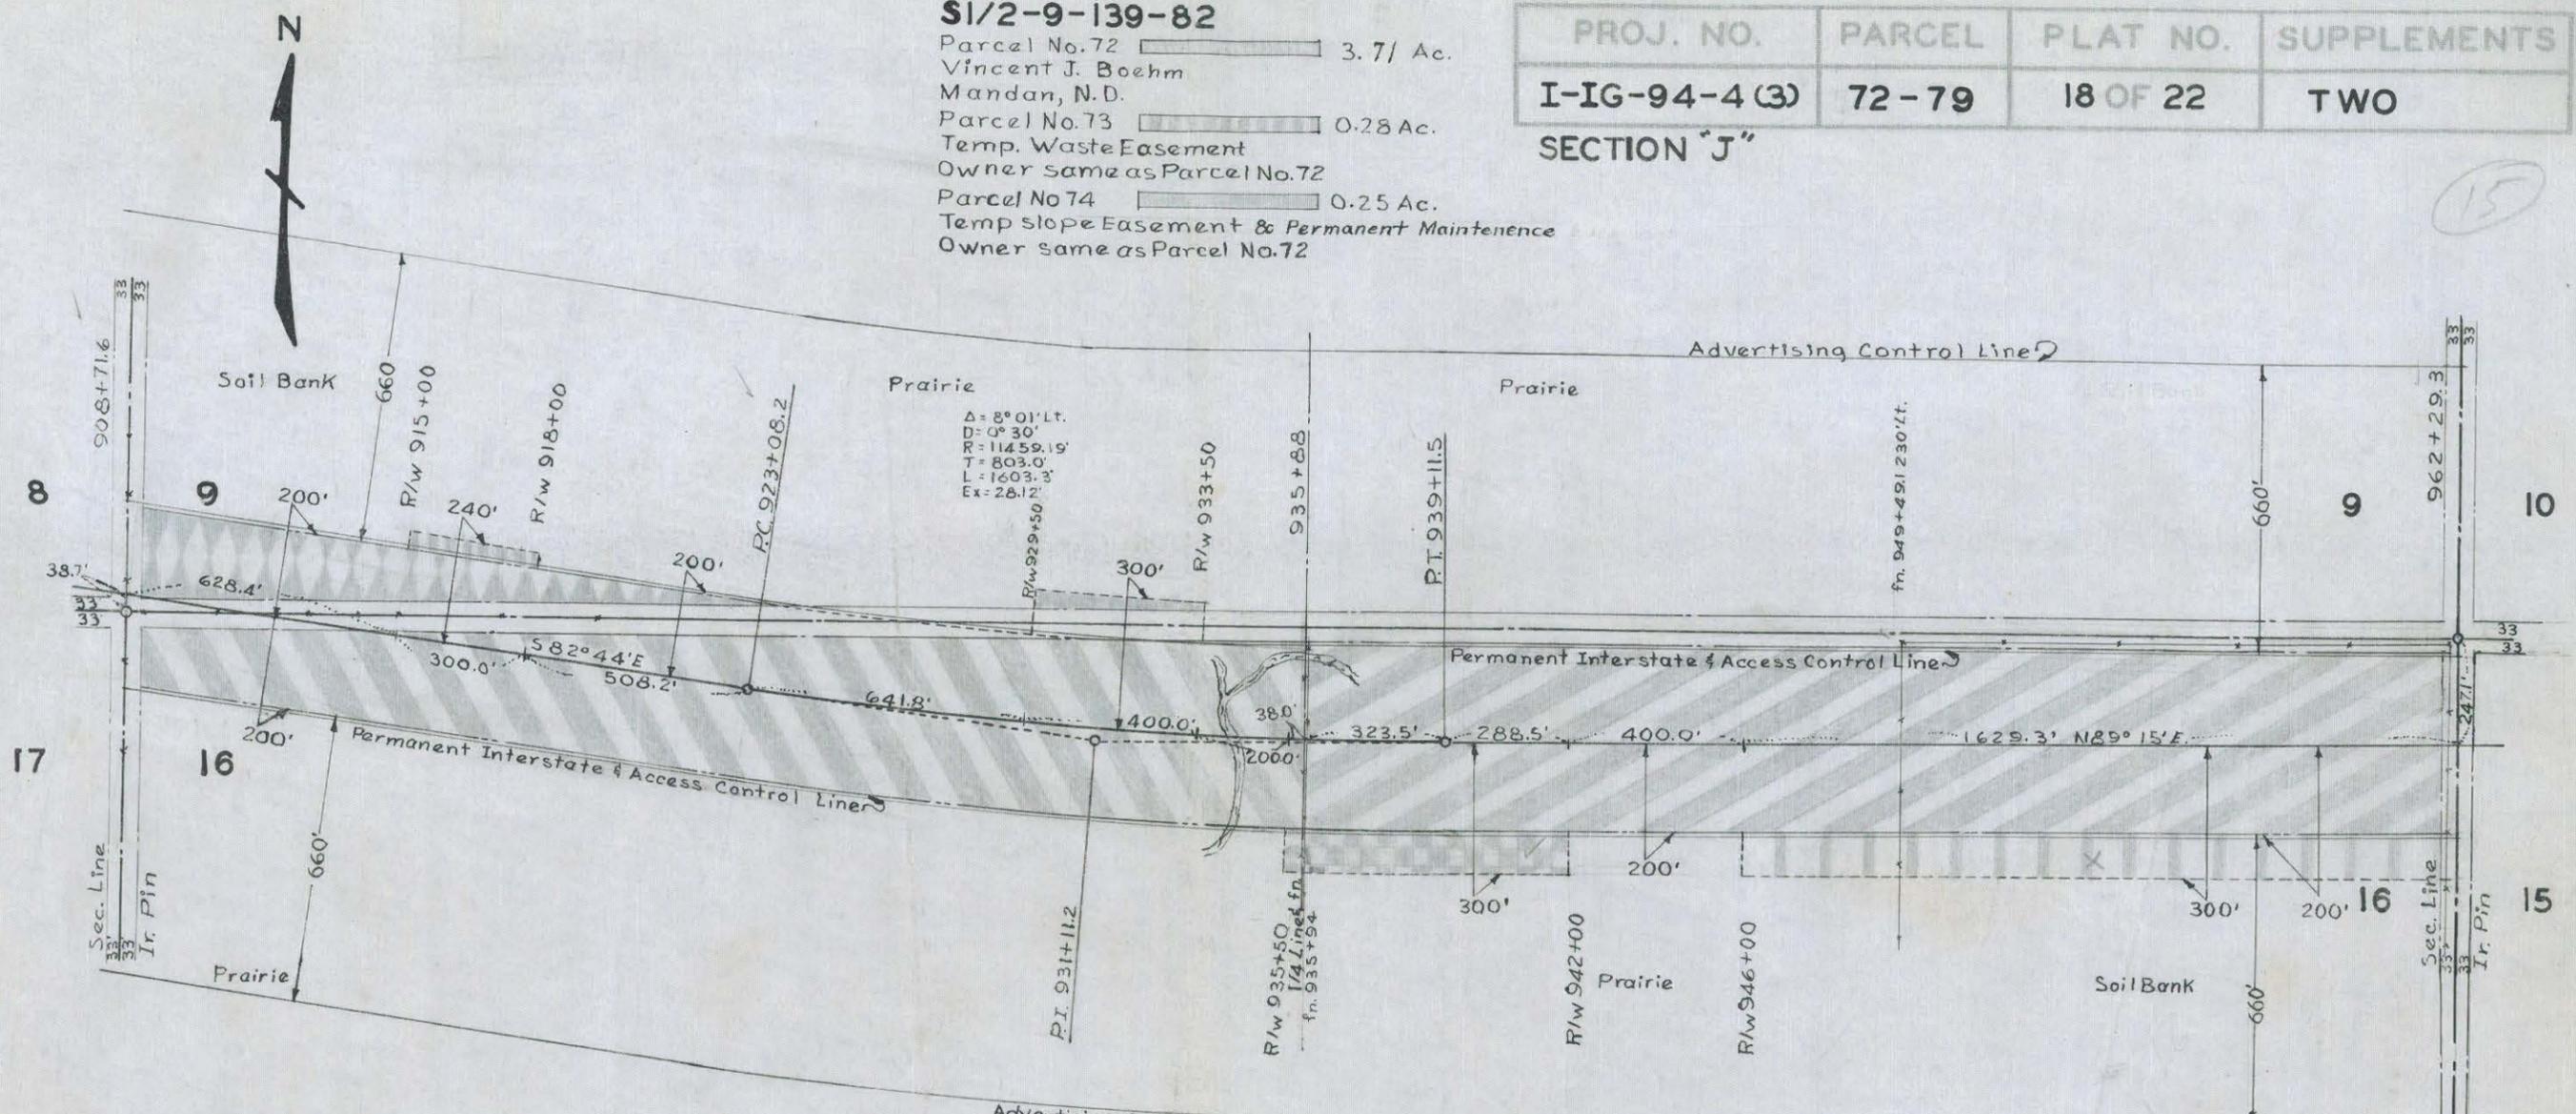

NW1/4-16-139-82

Parcel No.75 18.00 Ac.
 Joe and Caroline Schmidt
 Mandan, North Dakota
 Contract for Deed to
 Leo J Boehm
 Mandan, N.D.
 Parcel No.76 0.09 Ac.
 Temp. slope Easement & Permanent Maintenance
 Owner same as Parcel No.75

NE1/4-16-139-82

Parcel No.77 24.80 Ac.
 Vincent J. Boehm
 Mandan N. D.
 Parcel No.78 1.42 Ac.
 Temp. slope Easement & Permanent Maintenance
 Owner same as Parcel No.77
 Parcel No.79 3.66 Ac.
 Temp. Waste Easement
 Owner same as Parcel No.77

SYSTEM DIST. HWY. AGREEMENT
- - - ()
TITLE _____

NOTE
 INSTALL PIPE CULVERTS
 924+30 48" X 302'
 934+00 48" X 314'

This document was originally issued and sealed by Robert E. King, Registration Number LS 1001 on ___/___/___ and the original document is stored at the County Recorders Office

NORTH DAKOTA
 STATE HIGHWAY DEPARTMENT

RIGHT OF WAY PLAT

PROJECT NO. I-IG-94-4(3)

MORTON COUNTY

APPROVED *Robert E. King*
 RIGHT OF WAY ENGINEER

SCALE 1" = 400' DATE 7-31-63

Parcel No. 72

All that portion of the S $\frac{1}{2}$ of Sec. 9, Twp. 139 N., Rge. 82 W., 5th P. M., lying within a strip of land 200.0 ft. wide, located on the northerly side of and measured at right angles to the following described highway centerline as surveyed and staked:

Beginning at a point 38.7 ft. north of the southwest corner of said S $\frac{1}{2}$; thence running S 82°44'E 1436.6 ft., thence along a 0°30' curve to the left until said strip crosses the south line of said S $\frac{1}{2}$, ~~excepting all that portion lying within 33 feet of the section lines.~~

Tract contains 3.71 acres, more or less, and is shown on plat as shaded area.

Also including all right of access, being the right of ingress to and egress from the remaining property to and from the highway right of way as shown on the right of way plat.

And including all right and control over the erection, location or maintenance of billboards, signs or any form of advertising whatsoever, upon all that portion of the S $\frac{1}{2}$ of Sec. 9, Twp. 139 N., Rge. 82 W., in Morton County, North Dakota within 660 feet of the controlled access limits of Project I-IG-94-4(3), Morton County, North Dakota as shown on right of way plats on file in the office of the Register of Deeds of Morton County, North Dakota.

Parcel No. 73

All that portion of the S $\frac{1}{2}$ of Sec. 9, Twp. 139 N., Rge. 82 W., 5th P. M., lying within a strip of land located on the northerly side of and measured at right angles to the following described highway centerline as surveyed and staked:

Beginning at a point 38.7 ft. north of the southwest corner of said S $\frac{1}{2}$; where said strip is 200.0 ft. wide, thence running S 82°44'E 628.4 ft. more or less to a point where said strip changes to 240.0 ft. in width, thence continuing S 82°44'E 300.0 ft. more or less to a point where said strip changes to 200.0 ft. in width, thence continuing S 82°44'E 508.2 ft., thence along a 0°30' curve to the left until said strip crosses the south line of said S $\frac{1}{2}$, excepting all that portion lying within 200.0 ft. of the above described centerline.

Tract contains 0.28 acres, more or less, and is shown on plat as shaded area.

Parcel No. 74

All that portion of the S $\frac{1}{2}$ of Sec. 9, Twp. 139 N., Rge. 82 W., 5th P. M., lying within a strip of land located on the northerly side of and measured at right angles to the following described highway centerline as surveyed and staked:

Beginning at a point 38.7 ft. north of the southwest corner of said S $\frac{1}{2}$; where said strip is 200.0 ft. wide; thence running S 82°44'E 1436.6 ft.; thence along a 0°30' curve to the left 641.8 ft. more or less to a point where said strip changes to 300.0 ft. in width, thence continuing along said 0°30' curve to the left 400.0 ft. more or less to a point where said strip changes to 200.0 ft. in width, thence continuing along said 0°30' curve to the left until said strip crosses the east line of the SW $\frac{1}{4}$ of said Section 9; excepting all that portion lying within 200.0 ft. of the above described centerline and all that portion lying within 33 feet of the section line.

Tract contains 0.25 acres, more or less, and is shown on plat as shaded area.

SYSTEM DIST. HWY. AGREEMENT

MILE

SECTION "J" PROJECT NO. I-IG-94-4(3)
1ST SUPPLEMENT TO PLAT NO. 18 OF 22

Parcel No. 75

All that portion of the NW $\frac{1}{4}$ of Sec. 16, Twp. 139 N., Rge. 82 W., 5th P. M., lying within a strip of land 200.0 ft. wide, located on the southerly side of and measured at right angles to the following described highway centerline as surveyed and staked:

Beginning at a point 38.7 ft. north of the northwest corner of said NW $\frac{1}{4}$; thence running S 82°44'E 1436.6 ft., thence along a 0°30' curve to the left 1279.8 ft. more or less until said strip crosses the east line of said NW $\frac{1}{4}$; also including all that portion lying northerly of the above described centerline, excepting all that portion lying within 33 feet of the section lines.

Tract contains 18.00 acres, more or less, and is shown on plat as shaded area.

Also including all right of access, being the right of ingress to and egress from the remaining property to and from the highway right of way as shown on the right of way plat.

And including all right and control over the erection, location or maintenance of billboards, signs or any form of advertising whatsoever, upon all that portion of the NW $\frac{1}{4}$ of Sec. 16, Twp. 139 N., Rge. 82 W., in Morton County, North Dakota within 660 feet of the controlled access limits of Project I-IG-94-4(3), Morton County, North Dakota as shown on right of way plats on file in the office of the Register of Deeds of Morton County, North Dakota.

Parcel No. 76

All that portion of the NW $\frac{1}{4}$ of Sec. 16, Twp. 139 N., Rge. 82 W., 5th P. M., lying within a strip of land located on the southerly side of and measured at right angles to the following described highway centerline as surveyed and staked:

Beginning at a point 38.7 ft. north of the northwest corner of said NW $\frac{1}{4}$; where said strip is 200.0 ft. wide; thence running S 82°44'E 1436.6 ft., thence along a 0°30' curve to the left 1241.8 ft. more or less to a point where said strip changes to 300.0 ft. in width, thence continuing along said 0°30' curve to the left 38.0 ft. more or less until said strip crosses the east line of said NW $\frac{1}{4}$; excepting all that portion lying within 200.0 ft. of the above described centerline.

Tract contains 0.09 acres, more or less, and is shown on plat as shaded area.

Parcel No. 77

All that portion of the NE $\frac{1}{4}$ of Sec. 16, Twp. 139 N., Rge. 82 W., 5th P. M., lying within a strip of land 200.0 ft. wide, located on the southerly side of and measured at right angles to the following described highway centerline as surveyed and staked:

Beginning at a point 247.1 ft. south of the northeast corner of said NE $\frac{1}{4}$; thence running S 89°15'W 2317.8 ft., thence along a 0°30' curve to the right 323.5 ft. more or less until said strip crosses the west line of said NE $\frac{1}{4}$; also including all that portion lying northerly of the above described centerline, excepting all that portion lying within 33 feet of the section lines.

Tract contains 24.80 acres, more or less, and is shown on plat as shaded area.

Also including all right of access, being the right of ingress to and egress from the remaining property to and from the highway right of way as shown on the right of way plat.

And including all right and control over the erection, location or maintenance of billboards, signs or any form of advertising whatsoever, upon all that portion of the NE $\frac{1}{4}$ of Sec. 16, Twp. 139 N., Rge. 82 W., in Morton County, North Dakota within 660 feet of the controlled access limits of Project I-IG-94-4(3), Morton County, North Dakota as shown on right of way plats on file in the office of the Register of Deeds of Morton County, North Dakota.

(Continued on Supplement No. 2)

including all that portion lying southerly of the above described strip

15

Parcel No. 78

All that portion of the NE $\frac{1}{4}$ of Sec. 16, Twp. 139 N., Rge. 82 W., 5th P. M., lying within a strip of land located on the southerly side of and measured at right angles to the following described highway centerline as surveyed and staked:

Beginning at a point 247.1 ft. south of the northeast corner of said NE $\frac{1}{4}$; where said strip is 200.0 ft. wide; thence running S 89°15'W 2029.3 ft. more or less to a point where said strip changes to 300.0 ft. in width; thence continuing S 89°15'W 288.5 ft., thence along a 0°30' curve to the right 323.5 ft. more or less until said strip crosses the west line of said NE $\frac{1}{4}$; excepting all that portion lying within 200.0 ft. of the above described centerline.

Tract contains 1.42 acres, more or less, and is shown on plat as shaded area.

Parcel No. 79

All that portion of the NE $\frac{1}{4}$ of Sec. 16, Twp. 139 N., Rge. 82 W., 5th P. M., lying within a strip of land, located on the southerly side of and measured at right angles to the following described highway centerline as surveyed and staked:

Beginning at a point 247.1 ft. south of the northeast corner of said NE $\frac{1}{4}$; where said strip is 300.0 ft. wide; thence running S 89°15'W 1629.3 ft. more or less to a point where said strip changes to 200.0 ft. in width, thence continuing S 89°15'W 688.5 ft., thence along a 0°30' curve to the right 323.5 ft. more or less until said strip crosses the west line of said NE $\frac{1}{4}$; excepting all that portion lying within 200.0 ft. of the above described centerline and all that portion lying within 33 feet of the section line.

Tract contains 3.66 acres, more or less, and is shown on plat as shaded area.

SECTION "J" PROJECT NO. I-IG-94-4(3)
2ND SUPPLEMENT TO PLAT NO. 18 OF 22

SYSTEM DIST. HWY. AGREEMENT	
-	()
MILE _____	

15

Parcel No. 80

All that portion of the S $\frac{1}{2}$ of Sec. 10, Twp. 139 N., Rge. 82 W., 5th P. M., lying southeasterly of a line extending between two points, said points lying respectively 336.95 ft. north along the section line and 672.11 ft. west along the section line from the southeast corner of said Section 10, excepting all that portion previously acquired for public highway right of way and all that portion lying within 33.0 feet of the section lines.

Tract contains 1.30 acres, more or less, and is shown on plat as shaded area.

Also including all right of access, being the right of ingress to and egress from the remaining property to and from the highway right of way as shown on the right of way plat.

And including all right and control over the erection, location or maintenance of billboards, signs or any form of advertising whatsoever, upon all that portion of the S $\frac{1}{2}$ of Sec. 10, Twp. 139 N., Rge. 82 W., in Morton County, North Dakota within 660 feet of the *Controlled access* limits of Project I-IG-94-4-(3), Morton County, North Dakota as shown on right of way plats on file in the office of the Register of Deeds of Morton County, North Dakota.

Parcel No. 81

All that portion of the SE $\frac{1}{4}$ of Sec. 10, Twp. 139 N., Rge. 82 W., 5th P. M., lying northwesterly of a line extending between two points, said points lying respectively 336.95 ft. north along the section line and 672.11 ft. west along the section line from the southeast corner of said Section 10 and lying within a strip of land 200.0 ft. wide, lying 100.0 ft. on each side of the following described service road centerline as surveyed and staked over and across said SE $\frac{1}{4}$:

Beginning at a point 233.0 ft. south along the section line, thence 643.3 ft. S 89°15'W, thence 178.1 ft. N 0°45'W, thence 668.7 ft. N 55°35'W from the southeast corner of said Section 10, said point being the true point of beginning, thence running S 55°35'E 130.0 ft., thence along a 9°00' curve to the left 893.5 ft., thence N 44°00'E 414.15 ft., more or less, until said strip crosses the east line of said Section 10. ^{Also including all that portion lying southerly of the above described strip and easterly of the present Hwy.} excepting all that portion previously acquired for public highway right of way and all that portion lying within 33.0 ft. of the section lines.

Tract contains 5.15 acres, more or less, and is shown on plat as shaded area.

Parcel No. 82

All that portion of the NW $\frac{1}{4}$ of Sec. 15, Twp. 139 N., Rge. 82 W., 5th P. M., lying within a strip of land 200.0 ft. wide, located on the southerly side of and measured at right angles to the following described highway centerline as surveyed and staked:

Beginning at a point on the section line 247.1 ft. south of the northwest corner of said NW $\frac{1}{4}$, thence running N 89°15'E 2649.7 ft., more or less, until said strip crosses the east line of said NW $\frac{1}{4}$, also including all that portion lying northerly of the above described highway centerline, excepting all that portion lying within 33 feet of the section lines.

Tract contains 24.66 acres, more or less, and is shown on plat as shaded area.

Also including all right of access, being the right of ingress to and egress from the remaining property to and from the highway right of way as shown on right of way plat.

And including all right and control over the erection, location or maintenance of billboards, signs or any form of advertising whatsoever, upon all that portion of the NW $\frac{1}{4}$ of Sec. 15, Twp. 139 N., Rge. 82 W., in Morton County, North Dakota within 660 feet of the *Controlled Access* limits of Project I-IG-94-4(3), Morton County, North Dakota as shown on right of way plats on file in the office of the Register

SYSTEM DIST. HWY. AGREEMENT

MILE _____

of Deeds of Morton County, North Dakota.

PROJECT NO. I-IG-94-4(3)

SUPPLEMENT TO PLAT NO. 19 OF 22

Parcel No. 82 Continued

15

Parcel No. 82A

All that portion of the NW $\frac{1}{4}$ of Sec. 15, Twp. 139 N., Rge. 82 W., 5th P. M., lying within a strip of land 300.0 ft. wide, located on the southerly side of and measured at right angles to the following described highway centerline as surveyed and staked:

Beginning at a point on the section line 247.1 ft. south of the northwest corner of said NW $\frac{1}{4}$, where said strip is 200.0 ft. wide, thence running N 89°15'E 720.7 ft., more or less, to a point where said strip changes to 300.0 ft. in width, thence continuing N 89°15'E 1300.0 ft., more or less, to a point where said strip changes to 200.0 ft., ^{in width} thence continuing N 89°15'E 629.0 ft., more or less, until said strip crosses the east line of said NW $\frac{1}{4}$, excepting all that portion lying within 200.0 ft. of the above described centerline.

Tract contains 2.98 acres, more or less, and is shown on plat as shaded area.

Parcel No. 83

All that portion of the NE $\frac{1}{4}$ of Sec. 15, Twp. 139 N., Rge. 82 W., 5th P. M., lying within a strip of land, located on the southerly side of and measured at right angles to the following described highway centerline as surveyed and staked:

Beginning at a point on the section line 233.0 ft. south of the northeast corner of said Section 15, where said strip is 200.0 ft. in width, thence running S 89°15'W 1730.4 ft., more or less, to a point where said strip changes to 240.0 ft. in width, thence continuing S 89°15'W 325.0 ft., more or less, to a point where said strip changes to 200.0 ft. in width, thence continuing S 89°15'W 596.0 ft., more or less, until said strip crosses the west line of said NE $\frac{1}{4}$. Also including all that portion lying northerly of the above described highway centerline and all that portion bounded and described as follows: Beginning at a point on the section line 905.57 ft. south of the northeast corner of said Section 15; thence running west 136.51 ft., thence north 115.87 ft., thence N 64°07'W 773.33 ft., thence N 89°15'E to a point on the east line of said Section 15, thence south along the east line of said Section 15 to the point of beginning, excepting all that portion previously acquired for public highway right of way and all that portion lying within 33.0 feet of the section lines.

Tract contains 27.49 acres, more or less, and is shown on plat as shaded area.

Also including all right of access, being the right of ingress to and egress from the remaining property to and from the highway right of way as shown on the right of way plat.

And including all right and control over the erection, location or maintenance of billboards, signs or any form of advertising whatsoever, upon all that portion of the NE $\frac{1}{4}$ of Sec. 15, Twp. 139 N., Rge. 82 W., in Morton County, North Dakota within 660 feet of the *Controlled Access* limits of Project I-IG-94-4(3), Morton County, North Dakota as shown on right of way plats on file in the office of the Register of Deeds of Morton County, North Dakota.

Parcel No. 84

A tract of land lying in the NE $\frac{1}{4}$ of Sec. 15, Twp. 139 N., Rge. 82 W., 5th P. M., said tract being described as follows:

Beginning at a point on the section line 1100.52 ft. south of the northeast corner of said Section 15, thence running N 52°11'W 1071.63 ft., thence S 64°07'E 773.33 ft., thence south 115.87 ft., thence east 136.51 ft., more or less, to a point on the east line of said Section 15, thence south along the section line to the point of beginning.

Tract contains 1.85 acres, more or less, and is shown on plat as shaded area.

MADE BY Ted Peters

CHECKED BY Leonard Christensen

DATE

DATE 10-15-87

Parcel No. 81A

All that portion of the SE 1/4 of Sec. 10, Twp. 139 N., Rge. 82 W., 5th P.M., lying within a strip of land 200.0 ft. wide, measured 100.0 ft. on each side of the following described highway centerline as surveyed and staked over and across said SE 1/4:

Said strip and centerline begin a distance of 233.0 ft. south along the section line, thence a distance of 643.3 ft. S89°15'W, thence a distance of 178.1 ft. N0°45'W, thence a distance of 668.7 ft. N55°35'W, more or less, from the southeast corner of said Section 10, thence running S55°35'E a distance of 130.0 ft., thence along a 9°00' curve to the left a distance of 893.5 ft., thence N44°00'E a distance of 414.15 ft., more or less, until said strip crosses the east line of said SE 1/4.

Also including all that portion lying southeasterly of the above described strip and northwesterly of a sight distance, described as a tract of land lying northwesterly of a line extended between two points, said points lying respectively a distance of 336.95 ft. north along the section line and a distance of 672.11 ft. west along the section line, more or less, from the southeast corner of said SE 1/4.

Excepting all that portion lying within the above described sight distance and all that portion lying within the east 100.0 ft. of said SE 1/4.


Tract is shown on the plat as Parcel No. 81A and contains 5.81 acres, excepting all that portion lying within 33 feet of the section line.

Reserving to the grantor all right of access to and from the highway right of way, excepting as shown on the right of way plat.

PROJ. NO.	PARCEL	PLAT NO.	SUPPLEMENTS
I-IG-94-4(3)	81A	19A OF 22	NONE
MILE. 128			

In For Recording 10-23-87

SE 1/4-10-139-82
Parcel No. 81A 5.81 Ac.
North Dakota State Highway Dept.
Quit Claim To
Morton County
Mandan, N D
10-22-87

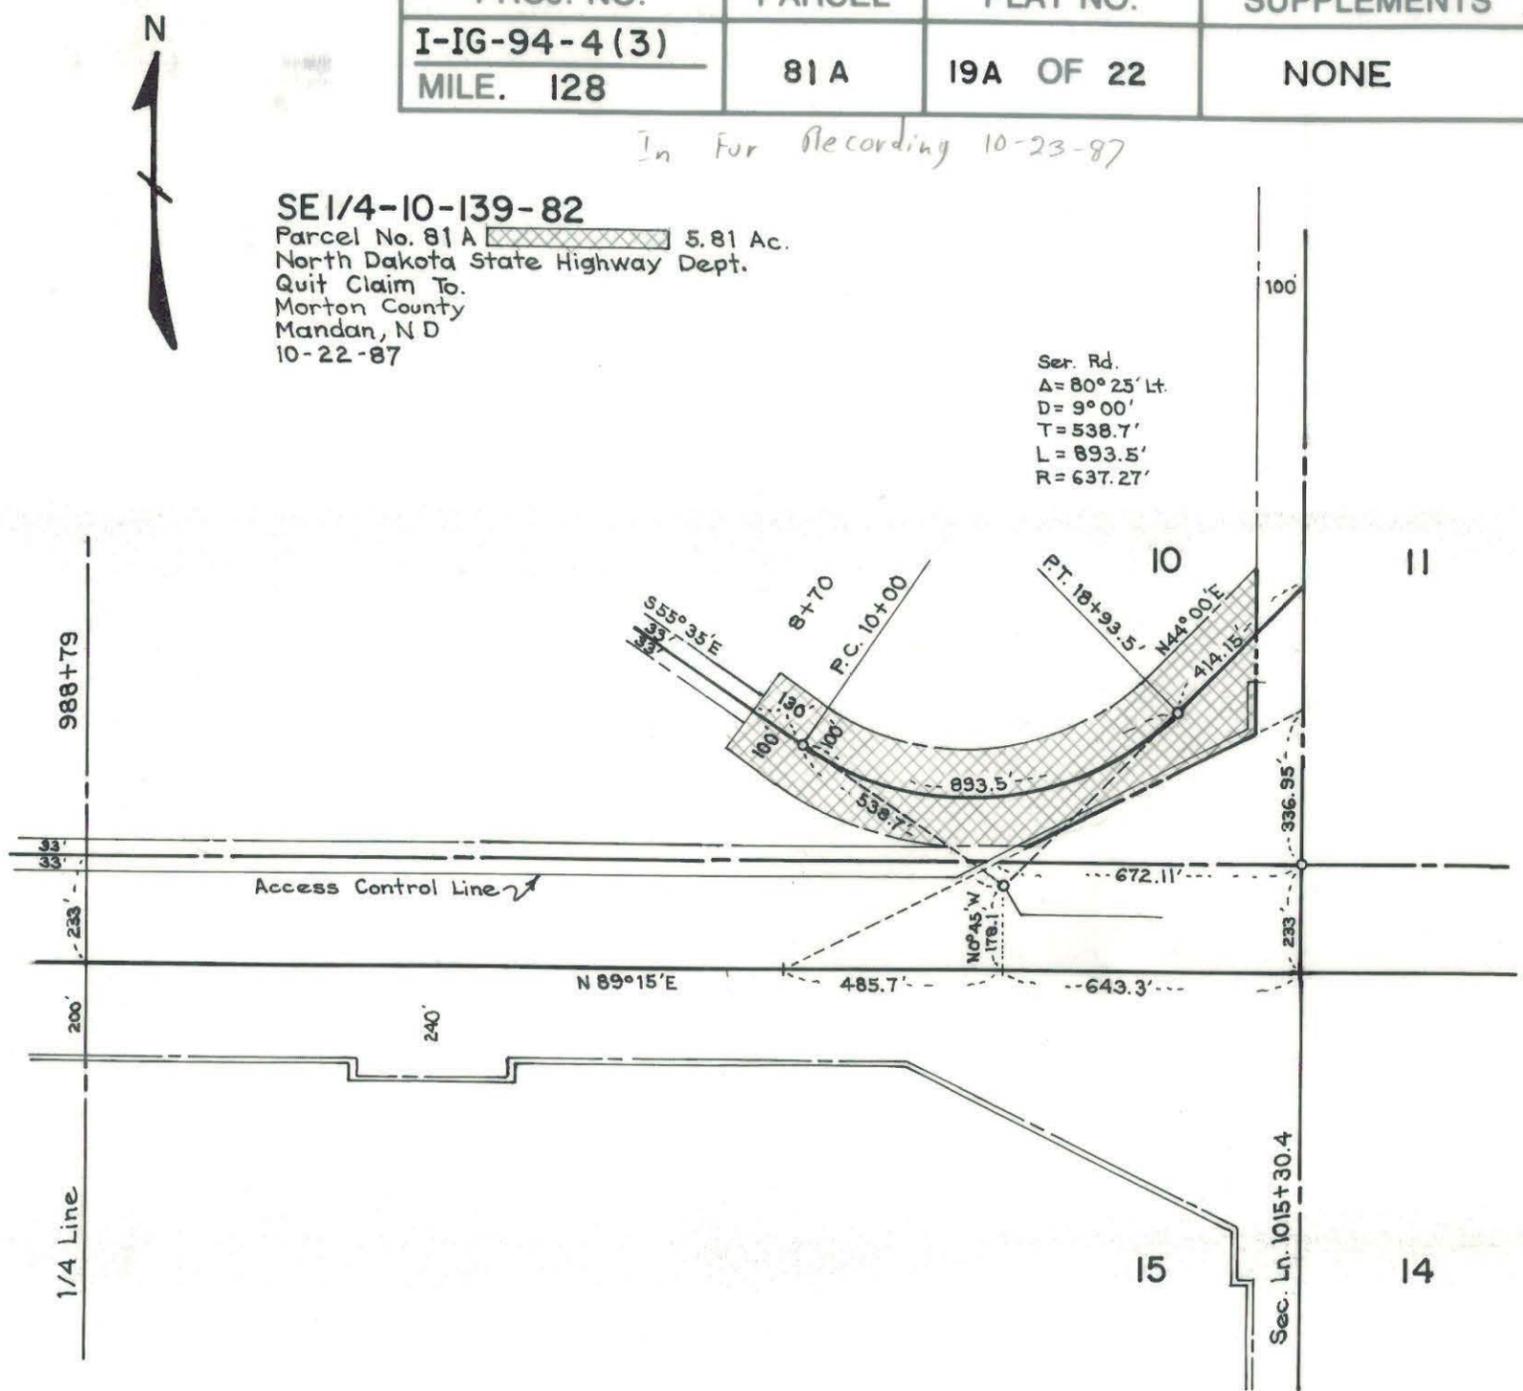

NORTH DAKOTA
STATE HIGHWAY DEPARTMENT
RIGHT OF WAY PLAT

PROJECT NO. I-IG-94-4(3)128

MORTON COUNTY
APPROVED *Dane E. Leftwich*
ENGINEER

SCALE 1"=400' DATE 10/23/87

This document was originally issued and sealed by Dave E. Leftwich, Registration Number LS 1971 on ___/___/___ and the original document is stored at the County Recorders Office

SI/2-II-139-82

Parcel No. 85 1.06 Ac.
 Adam F. and Eleanor Boehm h/w
 Mandan, North Dakota
 Parcel No. 86 3.91 Ac.
 Service Road
 Owner same as Parcel No. 85

West 210 ft. of South 208 ft. of SW 1/4:
 Parcel No. 86 A: 0.55 Ac.
 Square Butte School District # 1
 of Morton County, State of N.D.

PROJ. NO.	PARCEL	PLAT NO.	SUPPLEMENTS
I-IG-94-4 (3)	85 - 90	20 OF 22	TWO

SECTION "J" 10/14/63 Ch.Ch. Corrected. D.C.D. Parcel No. 90

SYSTEM DIST. HWY. AGREEMENT	
MILES	


Note: All distances shown on Hwy # 25
 Cross-over are on section line,
 not on Office Location E.

DATE 7-16-63

CHECKED BY Fremont Sturm

DATE

MADE BY L.E. Christensen

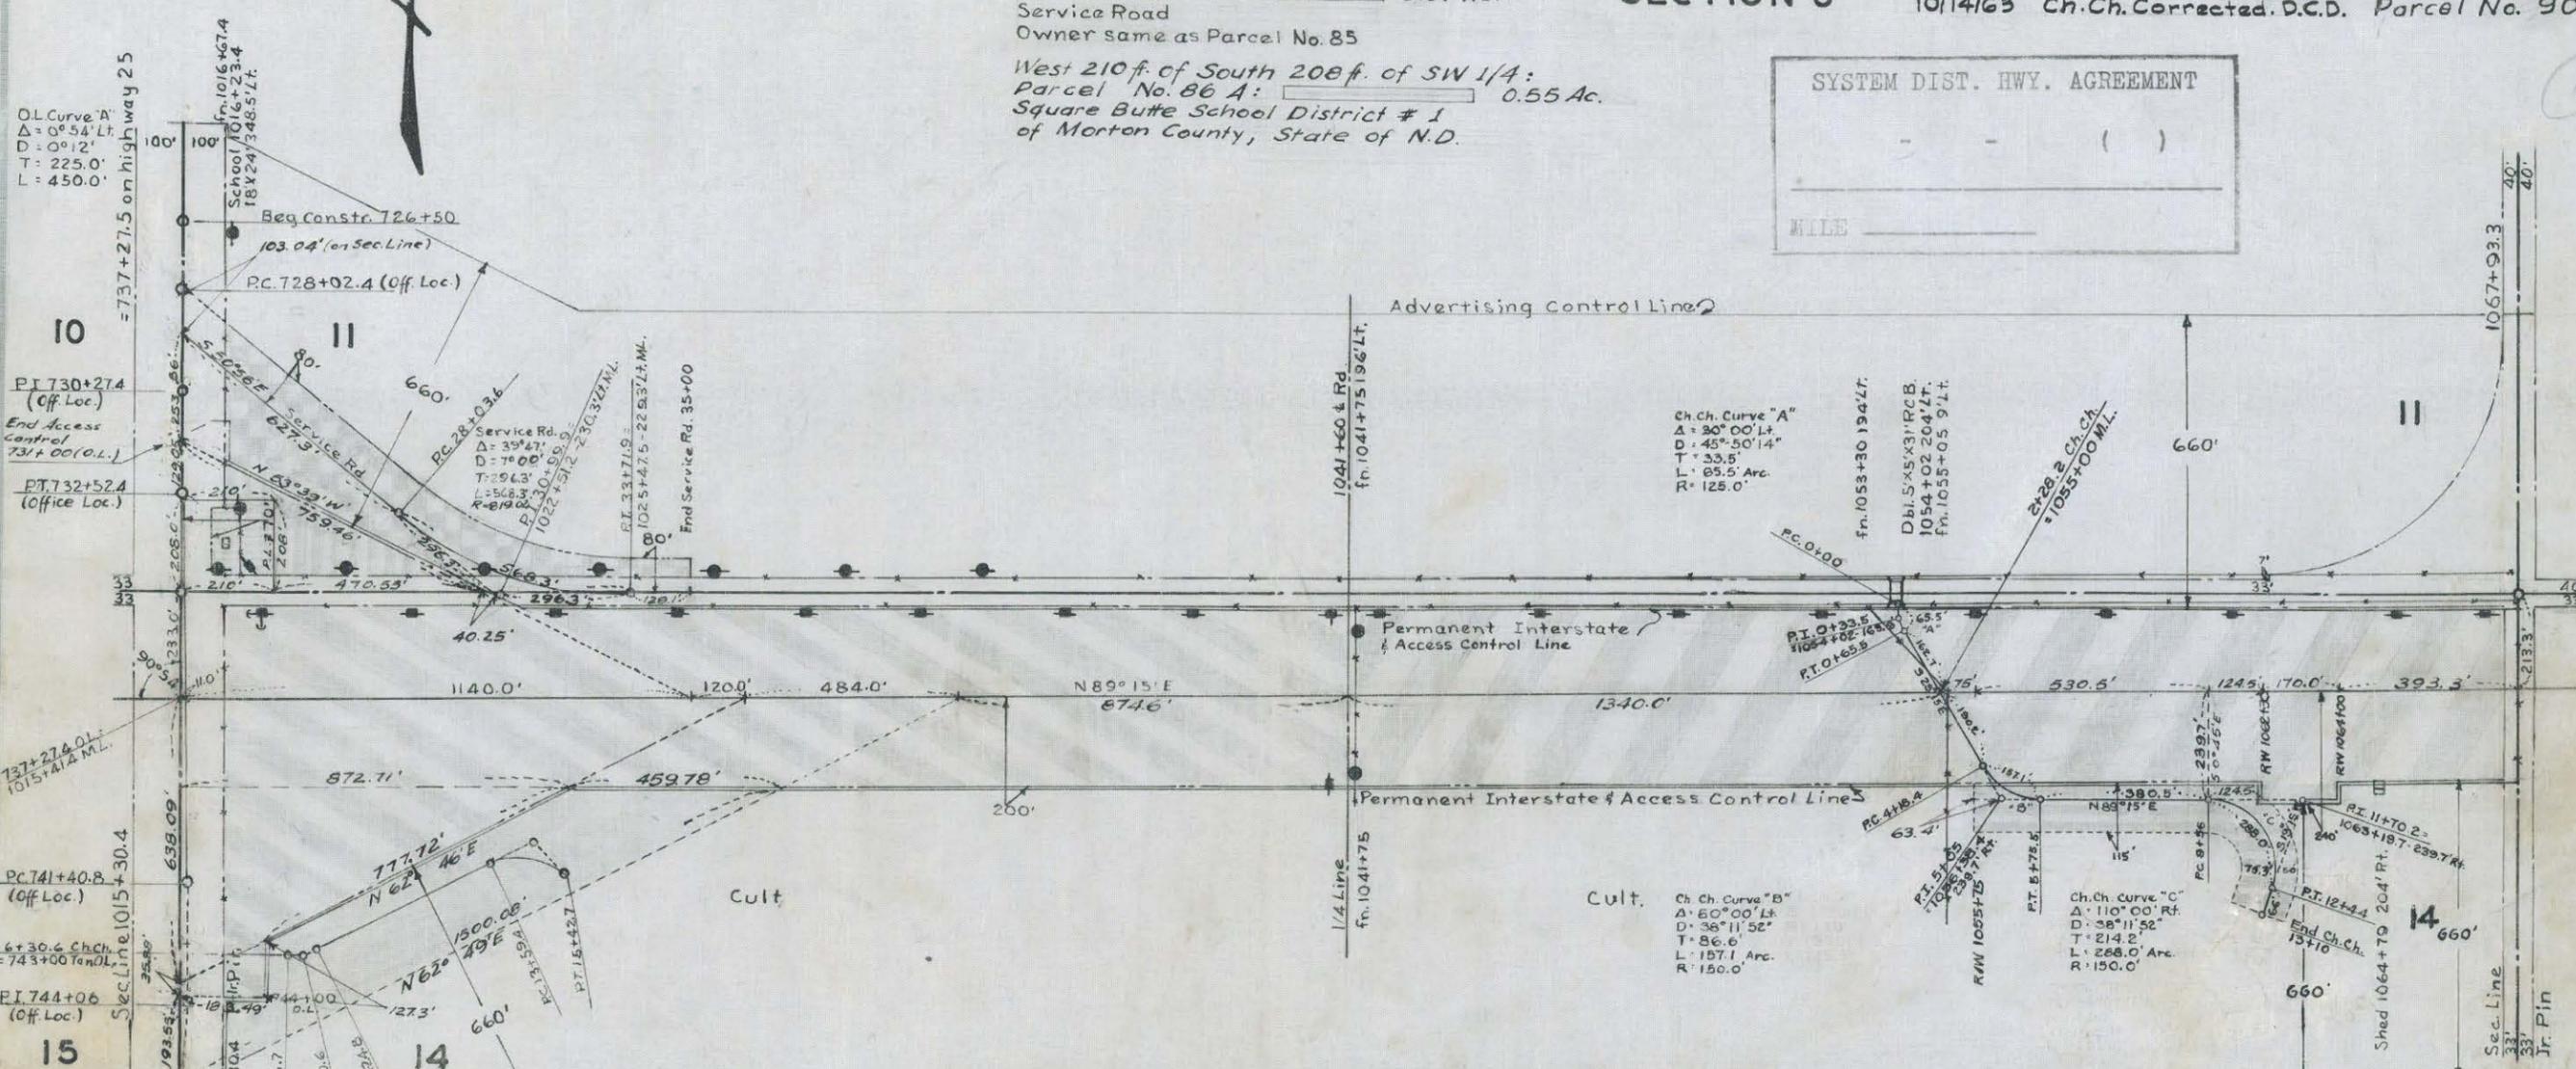

NWI/4-14-139-82

Parcel No. 87 26.53 Ac.
 Joseph A. Vogel
 Mandan, North Dakota
 Parcel No. 88 5.09 Ac.
 Temp. Ch.Ch. Easement
 Owner same as Parcel No. 87

NE1/4-14-139-82

Parcel No. 89 23.02 Ac.
 Adam F. and Eleanor V. Boehm h/w
 Mandan, North Dakota
 Parcel No. 90 2.30 Ac.
 Temp. Ch.Ch. Easement
 Owner same as Parcel No. 89

This document was originally issued and sealed by Robert E. King, Registration Number LS 1001 on _____ and the original document is stored at the County Recorders Office

NORTH DAKOTA
 STATE HIGHWAY DEPARTMENT

RIGHT OF WAY PLAT

PROJECT NO. I-IG-94-4 (3)

MORTON COUNTY

APPROVED *Robert E. King*
 RIGHT OF WAY ENGINEER

SCALE 1" = 400'

DATE 7-31-63

Parcel No. 85

A tract of land lying in the S $\frac{1}{2}$ of Sec. 11, Twp. 139 N., Rge. 82 W., 5th P.M., said tract being described as follows:

Beginning at a point on the southwest corner of said Sec. 11, thence running east along the section line 680.55 ft., thence N 53°39'W 759.46 ft., more or less, to a point on the west line of said Sec. 11, thence south along the section line, 337.05 ft., more or less, to the point of beginning; excepting all that portion lying within the west 210.0 ft. of the south 208.0 ft. of said Sec. 11, all that portion previously acquired for public highway right of way and all that portion lying within 33 feet of the section lines.

Tract contains 1.06 acres, more or less, and is shown on plat as shaded area.

Also including all right of access, being the right of ingress to and egress from the remaining property to and from the highway right of way, as shown on the right of way plat.

And including all right and control over the erection, location or maintenance of billboards, signs or any form of advertising whatsoever, upon all that portion of the S $\frac{1}{2}$ of Sec. 11, Twp. 139 N., Rge. 82 W., in Morton County, North Dakota within 660 feet of the controlled access limits of Project No. I-IG-94-4(3), Morton County, North Dakota as shown on right of way plats on file in the office of the Register of Deeds of Morton County, North Dakota.

Parcel No. 86

All that portion of the S $\frac{1}{2}$ of Sec. 11, Twp. 139 N., Rge. 82 W., 5th P. M., lying within a strip of land 80.0 ft. wide, located on the northeasterly side of and measured at right angles to the following described service road centerline as surveyed and staked:

Beginning at a point on the section line 1145.2 ft. east of the southwest corner of said Sec. 11, thence running west along the section line 128.1 ft., thence along a 7°00' curve to the right 568.3 ft., thence N 50°56'W 627.3 ft., more or less, until said strip crosses the west line of said Sec. 11, also including all that portion lying southwesterly of the above described service road centerline and northeasterly of a line extending between two points, said points lying respectively 337.05 ft. north along the section line and 680.55 ft. east along the section line from the southwest corner of said Sec. 11, excepting all that portion previously acquired for public highway right of way and all that portion lying within 33 feet of the section lines.

Tract contains 3.91 acres, more or less, and is shown on plat as shaded area.

Parcel No. 86A

The west 210.0 ft. of the south 208.0 ft. of the SW $\frac{1}{4}$ of Sec. 11, Twp. 139 N., Rge. 82 W., 5th P. M., excepting all that portion previously acquired for public highway right of way and all that portion lying within 33 feet of the section lines.

Tract contains 0.55 acres, more or less, and is shown on plat as shaded area.

~~Also including all right of access, being the right of ingress to and egress from the remaining property to and from the highway right of way, as shown on the right of way plat.~~

~~And including all right and control over the erection, location or maintenance of billboards, signs or any form of advertising whatsoever, upon all that portion of the SW $\frac{1}{4}$ of Sec. 11, Twp. 139 N., Rge. 82 W., in Morton County, North Dakota within 660 feet of the controlled access limits of Project No. I-IG-94-4(3), Morton County, North Dakota as shown on right of way plats on file in the office of the Register of Deeds of Morton County, North Dakota.~~

SYSTEM DIST. HWY. AGREEMENT

MILE _____

PROJECT NO. I-IG-94-4(3)

1ST SUPPLEMENT TO PLAT NO. 20 OF 22

Tie to Sec. Cor. corrected on Parcel No. 88; 8-13-63; F.J.S.

Parcel No. 87

All that portion of the NW $\frac{1}{4}$ of Sec. 14, Twp. 139 N., Rge. 82 W., 5th P. M., lying within a strip of land 200.0 ft. wide, located on the southerly side of and measured at right angles to the following described highway centerline as surveyed and staked:

Beginning at a point on the section line 233.0 ft. south of the northwest corner of said Sec. 14, thence running N 89°15'E 2629.6 ft., more or less, until said strip crosses the east line of said NW $\frac{1}{4}$, also including all that portion lying northerly of the above described centerline and all that portion bounded and described as follows:

Beginning at a point on the section line 906.97 ft. south of the northwest corner of said NW $\frac{1}{4}$, thence running east 183.49 ft., thence north 127.3 ft., thence N 62°46'E 777.72 ft., thence S 89°15'W 872.71 ft., more or less, to a point on the west line of said Sec. 14, thence south along the section line to the point of beginning excepting all that portion previously acquired for public highway right of way and all that portion lying within 33 feet of the section lines.

Tract contains 26.53 acres, more or less, and is shown on plat as shaded area.

Also including all right of access, being the right of ingress to and egress from the remaining property to and from the highway right of way, as shown on the right of way plat.

And including all right and control over the erection, location or maintenance of billboards, signs or any form of advertising whatsoever, upon all that portion of the NW $\frac{1}{4}$ of Sec. 14, Twp. 139 N., Rge. 82 W., in Morton County, North Dakota within 660 feet of the Controlled Access limits of Project No. I-IG-94-4(3), Morton County, North Dakota as shown on right of way plats on file in the office of the Register of Deeds of Morton County, North Dakota.

Parcel No. 88

A tract of land lying in the NW $\frac{1}{4}$ of Sec. 14, Twp. 139 N., Rge. 82 W., 5th P. M., said tract being described as follows:

Beginning at a point on the section line 1100.52 ft. south of the northwest corner of said Sec. 14, thence running north along the section line 193.55 ft., thence east 183.49 ft., thence north 127.3 ft., thence N 62°46'E 777.72 ft., thence N 89°15'E 459.78 ft., thence S 62°49'W 1500.08 ft., more or less, to the point of beginning, excepting all that portion previously acquired for public highway right of way and all that portion lying within 33 feet of the section line.

Tract contains 5.09 acres, more or less, and is shown on plat as shaded area.

Parcel No. 89

All that portion of the NE $\frac{1}{4}$ of Sec. 14, Twp. 139 N., Rge. 82 W., 5th P. M., lying within a strip of land lying on the southerly side of the following described highway centerline as surveyed and staked over and across said NE $\frac{1}{4}$:

Beginning at a point on the section line 213.3 ft. south of the northeast corner of said Sec. 14, where said strip is 200.0 ft. wide; thence running S 89°15'W 393.3 ft., more or less, to a point where said strip changes to 240.0 ft. in width, thence continuing S 89°15'W 170.0 ft., more or less, to a point where said strip changes to 200.0 ft. in width, thence continuing S 89°15'W 2070.0 ft., more or less, until said strip crosses the west line of said NE $\frac{1}{4}$; also including all that portion lying northerly of the above described centerline excepting all that portion lying within 33 feet of the section lines.

Tract contains 23.02 acres, more or less, and is shown on plat as shaded area.

Also including all right of access, being the right of ingress to and egress from the remaining property to and from the highway right of way, as shown on the right of way plat.

And including all right and control over the erection, location or maintenance of billboards, signs or any form of advertising whatsoever, upon all that portion of the NE $\frac{1}{4}$ of Sec. 14, Twp. 139 N., Rge. 82 W., in Morton County, North Dakota within 660 feet of the controlled access limits of Project I-IG-94-4(3), Morton County, North Dakota as shown on right of way plats on file in the office of the Register of Deeds of Morton County, North Dakota.

Parcel No. 90

All that portion of the NE $\frac{1}{4}$ of Sec. 14, Twp. 139 N., Rge. 82 W., 5th P. M., lying within a strip of land lying on the southerly side of the following described highway centerline as surveyed and staked over and across said NE $\frac{1}{4}$:

Beginning at a point on the section line, 213.3 ft. south of the northeast corner of said Sec. 14, where said strip is 240.0 ft. wide, thence running S 89°15'W 687.8 ft., more or less, to a point where said strip changes to 315.0 ft. in width, thence continuing S 89°15'W 530.5 ft., more or less, to a point where said strip changes to 200.0 ft. in width; thence continuing S 89°15'W 1415.0 ft., more or less, until said strip crosses the west line of said NE $\frac{1}{4}$; also including all that portion lying southerly of a line running parallel to and 232.7 ft. south of the above described highway centerline and lying within a strip of land 125.3 ft. wide, lying 75.3 ft. on the westerly side and 50.0 ft. on the easterly side of the following described channel change centerline: Beginning at a point 213.3 ft. south, 687.8 ft. S 89°15'W and 232.7 ft. S 0°45'E from the northeast corner of said Sec. 14; thence from a tangent bearing of N 89°15'E running along a 38°11'52" curve to the right 288.0 ft., thence S 19°15'W 66.0 ft. excepting all that portion lying within a strip of land lying on the southerly side of the following described highway centerline: Beginning at a point on the section line, 213.3 ft. south of the northeast corner of said Section 14, where said strip is 240.0 ft. wide; thence running S 89°15'W 563.3 ft., more or less, to a point where said strip changes to 200.0 ft. in width, thence continuing S 89°15'W until said strip crosses the west line of said NE $\frac{1}{4}$.

Tract contains 2.30 acres, more or less, and is shown on plat as shaded area.

PROJECT NO. I-IG-94-4(3)
2ND. SUPPLEMENT TO PLAT NO. 20 OF 22

SYSTEM DIST. HWY. AGREEMENT	
-	()
MILE _____	

15

Parcel No. 91

The south 118.6 ft. of the east 437.8 ft. and the south 140.0 ft. of the west 250.0 ft. of the east 687.8 ft. of the S $\frac{1}{2}$ of Sec. 12, Twp. 139 N., Rge. 82 W., 5th P. M., excepting all that portion previously acquired for public highway right of way and all that portion lying within 33 feet of the section lines.

Tract contains 1.36 acres, more or less, and is shown on plat as shaded area.

And including all right and control over the erection, location or maintenance of billboards, signs or any form of advertising whatsoever, upon all that portion of the S $\frac{1}{2}$ of Sec. 12, Twp. 139 N., Rge. 82 W., in Morton County, North Dakota within 660 feet of the controlled access limits of Project I-IG-94-4(3), Morton County, North Dakota as shown on right of way plats on file in the office of the Register of Deeds of Morton County, North Dakota.

Parcel No. 92

All that portion of the S $\frac{1}{2}$ of Sec. 12, Twp. 139 N., Rge. 82 W., 5th P. M., lying within a strip of land 75.0 ft. wide, lying 35.0 ft. on the northerly side of and 40.0 ft. on the southerly side of the following described channel change centerline as surveyed and staked over and across said S $\frac{1}{2}$:

Beginning at a point on the section line 162.8 ft. north of the southeast corner of said Sec. 12, thence running west 259.7 ft., thence along a 38°12' curve to the right 117.8 ft, more or less, excepting all that portion lying within 33 feet of the section line.

Tract contains 0.60 acres, more or less, and is shown on plat as shaded area.

Parcel No. 93

All that portion of the N $\frac{1}{2}$ of Sec. 13, Twp. 139 N., Rge. 82 W., 5th P. M., lying within a strip of land lying on the southerly side of the following described highway centerline as surveyed and staked over and across said N $\frac{1}{2}$:

Beginning at a point on the section line 213.3 ft. south of the northwest corner of said Sec. 13, where said strip is 200.0 ft. wide; thence running N 89°15'E 4166.7 ft., more or less, to a point where said strip changes to 225.0 ft. in width, thence continuing N 89°15'E 240.0 ft., more or less, to a point where said strip changes to 200.0 ft. in width, thence continuing N 89°15'E 937.8 ft., more or less, until said strip crosses the east line of said Sec. 13; also including all that portion lying northerly of the above described highway centerline excepting all that portion previously acquired for public highway right of way and all that portion lying within 33 feet of the section lines.

Tract contains 47.88 acres, more or less, and is shown on plat as shaded area.

Also including all right of access, being the right of ingress to and egress from the remaining property to and from the highway right of way, as shown on the right of way plat.

And including all right and control over the erection, location or maintenance of billboards, signs or any form of advertising whatsoever, upon all that portion of the N $\frac{1}{2}$ of Sec. 13, Twp. 139 N., Rge. 82 W., in Morton County, North Dakota within 660 feet of the controlled access limits of Project I-IG-94-4(3), Morton County, North Dakota as shown on right of way plats on file in the office of the Register of Deeds of Morton County, North Dakota.

SYSTEM DIST. HWY. AGREEMENT

FILE _____

PROJECT NO. I-IG-94-4(3)
SUPPLEMENT TO PLAT NO. 21 OF 22

Parcel No. 94

All that portion of the N $\frac{1}{2}$ of Sec. 13, Twp. 139 N., Rge. 82 W., 5th P. M., lying within a strip of land located on both sides of and measured at right angles to the following described channel change centerline as surveyed and staked:

Beginning at a point 240.7 ft. south and 757.8 ft. S 89°15'W from the northeast corner of said N $\frac{1}{2}$, where said strip is 190.0 ft. wide lying 90.0 ft. on the southeasterly side and 100.0 ft. on the northwesterly side of the following described channel change centerline; thence running S 17°00'W 185.1 ft., thence along a 38°12' curve to the right 130.9 ft., more or less, to a point where said strip changes to 160.0 ft. in width lying 60.0 ft. on the southeasterly side and 100.0 ft. on the northwesterly side of said channel change centerline; thence running S 73°00'W 119.0 ft. excepting all that portion lying within a strip of land lying on the southerly side of the following described centerline; beginning at a point 240.7 ft. south of the northeast corner of said Section 13; where said strip is 200.0 ft. wide, thence running S 89°15'W 937.8 ft., more or less, to a point where said strip changes to 225.0 ft. in width, thence continuing S 89°15'W 240.0 ft., more or less, to a point where said strip changes to 200.0 ft. in width, thence continuing S 89°15'W until said strip crosses the west line of said Section 13.

Tract contains 0.87 acres, more or less, and is shown on plat as shaded area.

Parcel No. 92A

The south 240.0 ft. of the west 200.0 ft. of the east 887.8 ft. of the S $\frac{1}{2}$ of Sec. 12, Twp. 139 N., Rge. 82 W., 5th P. M., excepting all that portion previously acquired for public highway right of way and all that portion lying within 33 feet of the section line.

Tract contains 0.85 acres, more or less, and is shown on plat as shaded area.

PROJ. NO.	PARCEL	PLAT NO.	SUPPLEMENTS
I-IG-94-4(3)	95-97	22 OF 22	ONE

SECTION "J"

SYSTEM DIST. HWY. AGREEMENT

()

MILE _____

15

SW1/4-7-139-81

Parcel No. 95 0.92 Ac. - Service Road
 Adam F. Boehm
 R.F.D. #1, Mandan, N.D.

Parcel No. 96 1.29 Ac.
 Temporary Ch. Ch. easement
 Owner same as parcel no. 95




DATE 9-9-63

CHECKED BY Fremont Sturm

DATE 12-14-62

MADE BY L.E. Christensen

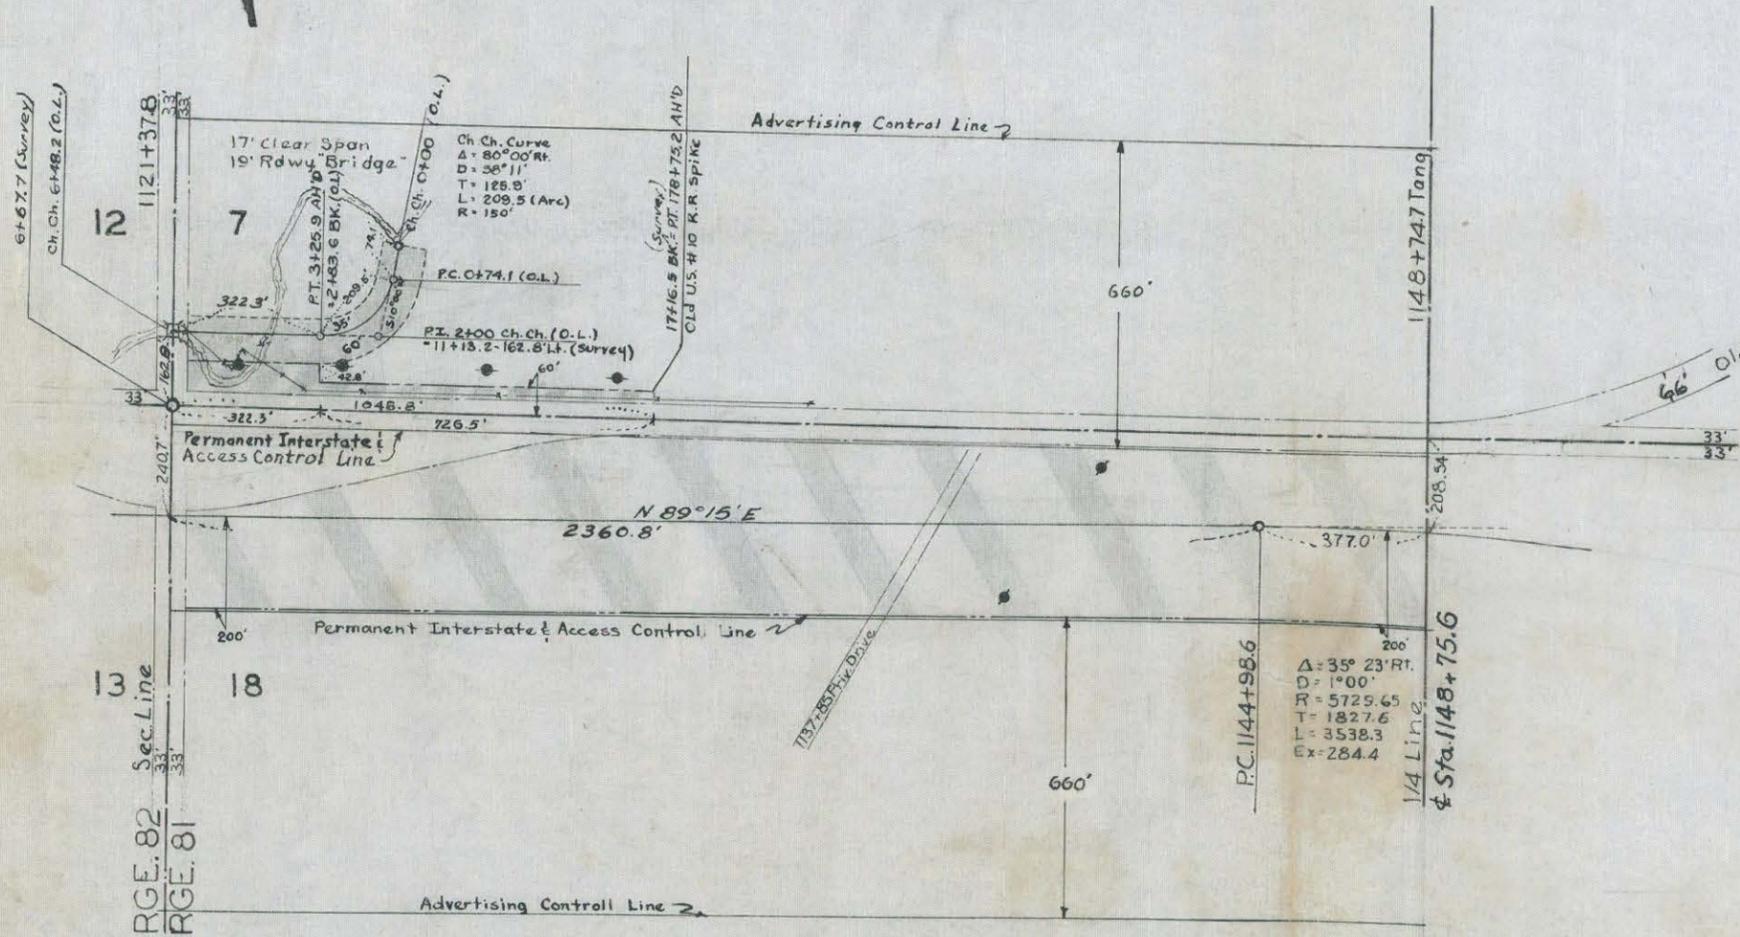

NW1/4-18-139-81

Parcel No. 97 22.00 Ac.
 Mathilda B. Gress
 Rt. #1, Mandan, N.D.

NORTH DAKOTA
 STATE HIGHWAY DEPARTMENT

RIGHT OF WAY PLAT

PROJECT NO. I-IG-94-4(3)

MORTON COUNTY

APPROVED *Duane L. Meiers, P.E.*
 ASST. RIGHT OF WAY ENGINEER

This document was originally issued and sealed by Duane L. Meiers, Registration Number LS 585 on ___/___/___ and the original document is stored at the County Recorders Office

SCALE 1" = 400'

DATE 9-19-63

Parcel No. 95

The south 102.8 ft. of the west 322.3 ft. and the south 60.0 ft. of the east 26.5 ft. of the west 1048.8 ft. of the SW $\frac{1}{4}$ of Sec. 7, Twp. 139 N., Rge. 81 W., 5th P. M., excepting all that portion lying within 33 feet of the section lines.

Tract contains 0.92 acres, more or less, and is shown on plat as shaded area.

And including all right and control over the erection, location or maintenance of billboards, signs or any form of advertising whatsoever, upon all that portion of the SW $\frac{1}{4}$ of Sec. 7, Twp. 139 N., Rge. 81 W., in Morton County, North Dakota within 660 feet of the controlled access limits of Project I-IG-94-4(3), Morton County, North Dakota as shown on right of way plats on file in the office of the Register of Deeds of Morton County, North Dakota.

Parcel No. 96

All that portion of the SW $\frac{1}{4}$ of Sec. 7, Twp. 139 N., Rge. 81 W., 5th P. M., lying within a strip of land 95.0 ft. wide, lying 60.0 ft. on the southerly side and 35.0 ft. on the northerly side of the following described channel change centerline as surveyed and staked over and across said SW $\frac{1}{4}$:

Beginning at a point 162.8 ft. north of the southwest corner of said SW $\frac{1}{4}$; thence running east 322.3 ft., thence along a 38°11' curve to the left 209.5 ft., thence N10°00'E 74.1 ft. ^{more or less} excepting all that portion lying within 33 feet of the section line.

Tract contains 1.29 acres, more or less, and is shown on plat as shaded area.

Parcel No. 97

All that portion of the NW $\frac{1}{4}$ of Sec. 18, Twp. 139 N., Rge. 81 W., 5th P. M., lying within a strip of land 200.0 ft. wide, located on the southerly side of and measured at right angles to the following described highway centerline as surveyed and staked:

Beginning at a point 240.7 ft. south of the northwest corner of said NW $\frac{1}{4}$; thence running N 89°15'E 2360.8 ft., thence along a 1°00' curve to the right 377.0 ft., more or less, until said strip crosses the east line of said NW $\frac{1}{4}$; also including all that portion lying northerly of the above described highway centerline excepting all that portion previously acquired for public highway right of way and all that portion lying within 33 feet of the section lines.

Tract contains 22.00 acres, more or less, and is shown on plat as shaded area.

Also including all right of access, being the right of ingress to and egress from the remaining property to and from the highway right of way, as shown on the right of way plat.

And including all right and control over the erection, location or maintenance of billboards, signs or any form of advertising whatsoever, upon all that portion of the NW $\frac{1}{4}$ of Sec. 18, Twp. 139 N., Rge. 81 W., in Morton County, North Dakota within 660 feet of the controlled access limits of Project I-IG-94-4(3), Morton County, North Dakota as shown on right of way plats on file in the office of the Register of Deeds of Morton County, North Dakota.

PROJECT NO. I-IG-94-4(3)
SUPPLEMENT TO PLAT NO. 22 OF 22

SYSTEM DIST. HWY. AGREEMENT	
-	()
MILE _____	

15

PROJ. NO.	PARCEL	PLAT NO.	SUPPLEMENTS
I-IG-94-4(3)	22A-1 to 22A-2	22A OF 22	ONE
MILE 128			

SECTION "J"


In for Recording 10-21-87

DATE 11/19/86

CHECKED BY *sc*

DATE 11-19-86

MADE BY Ted Peters

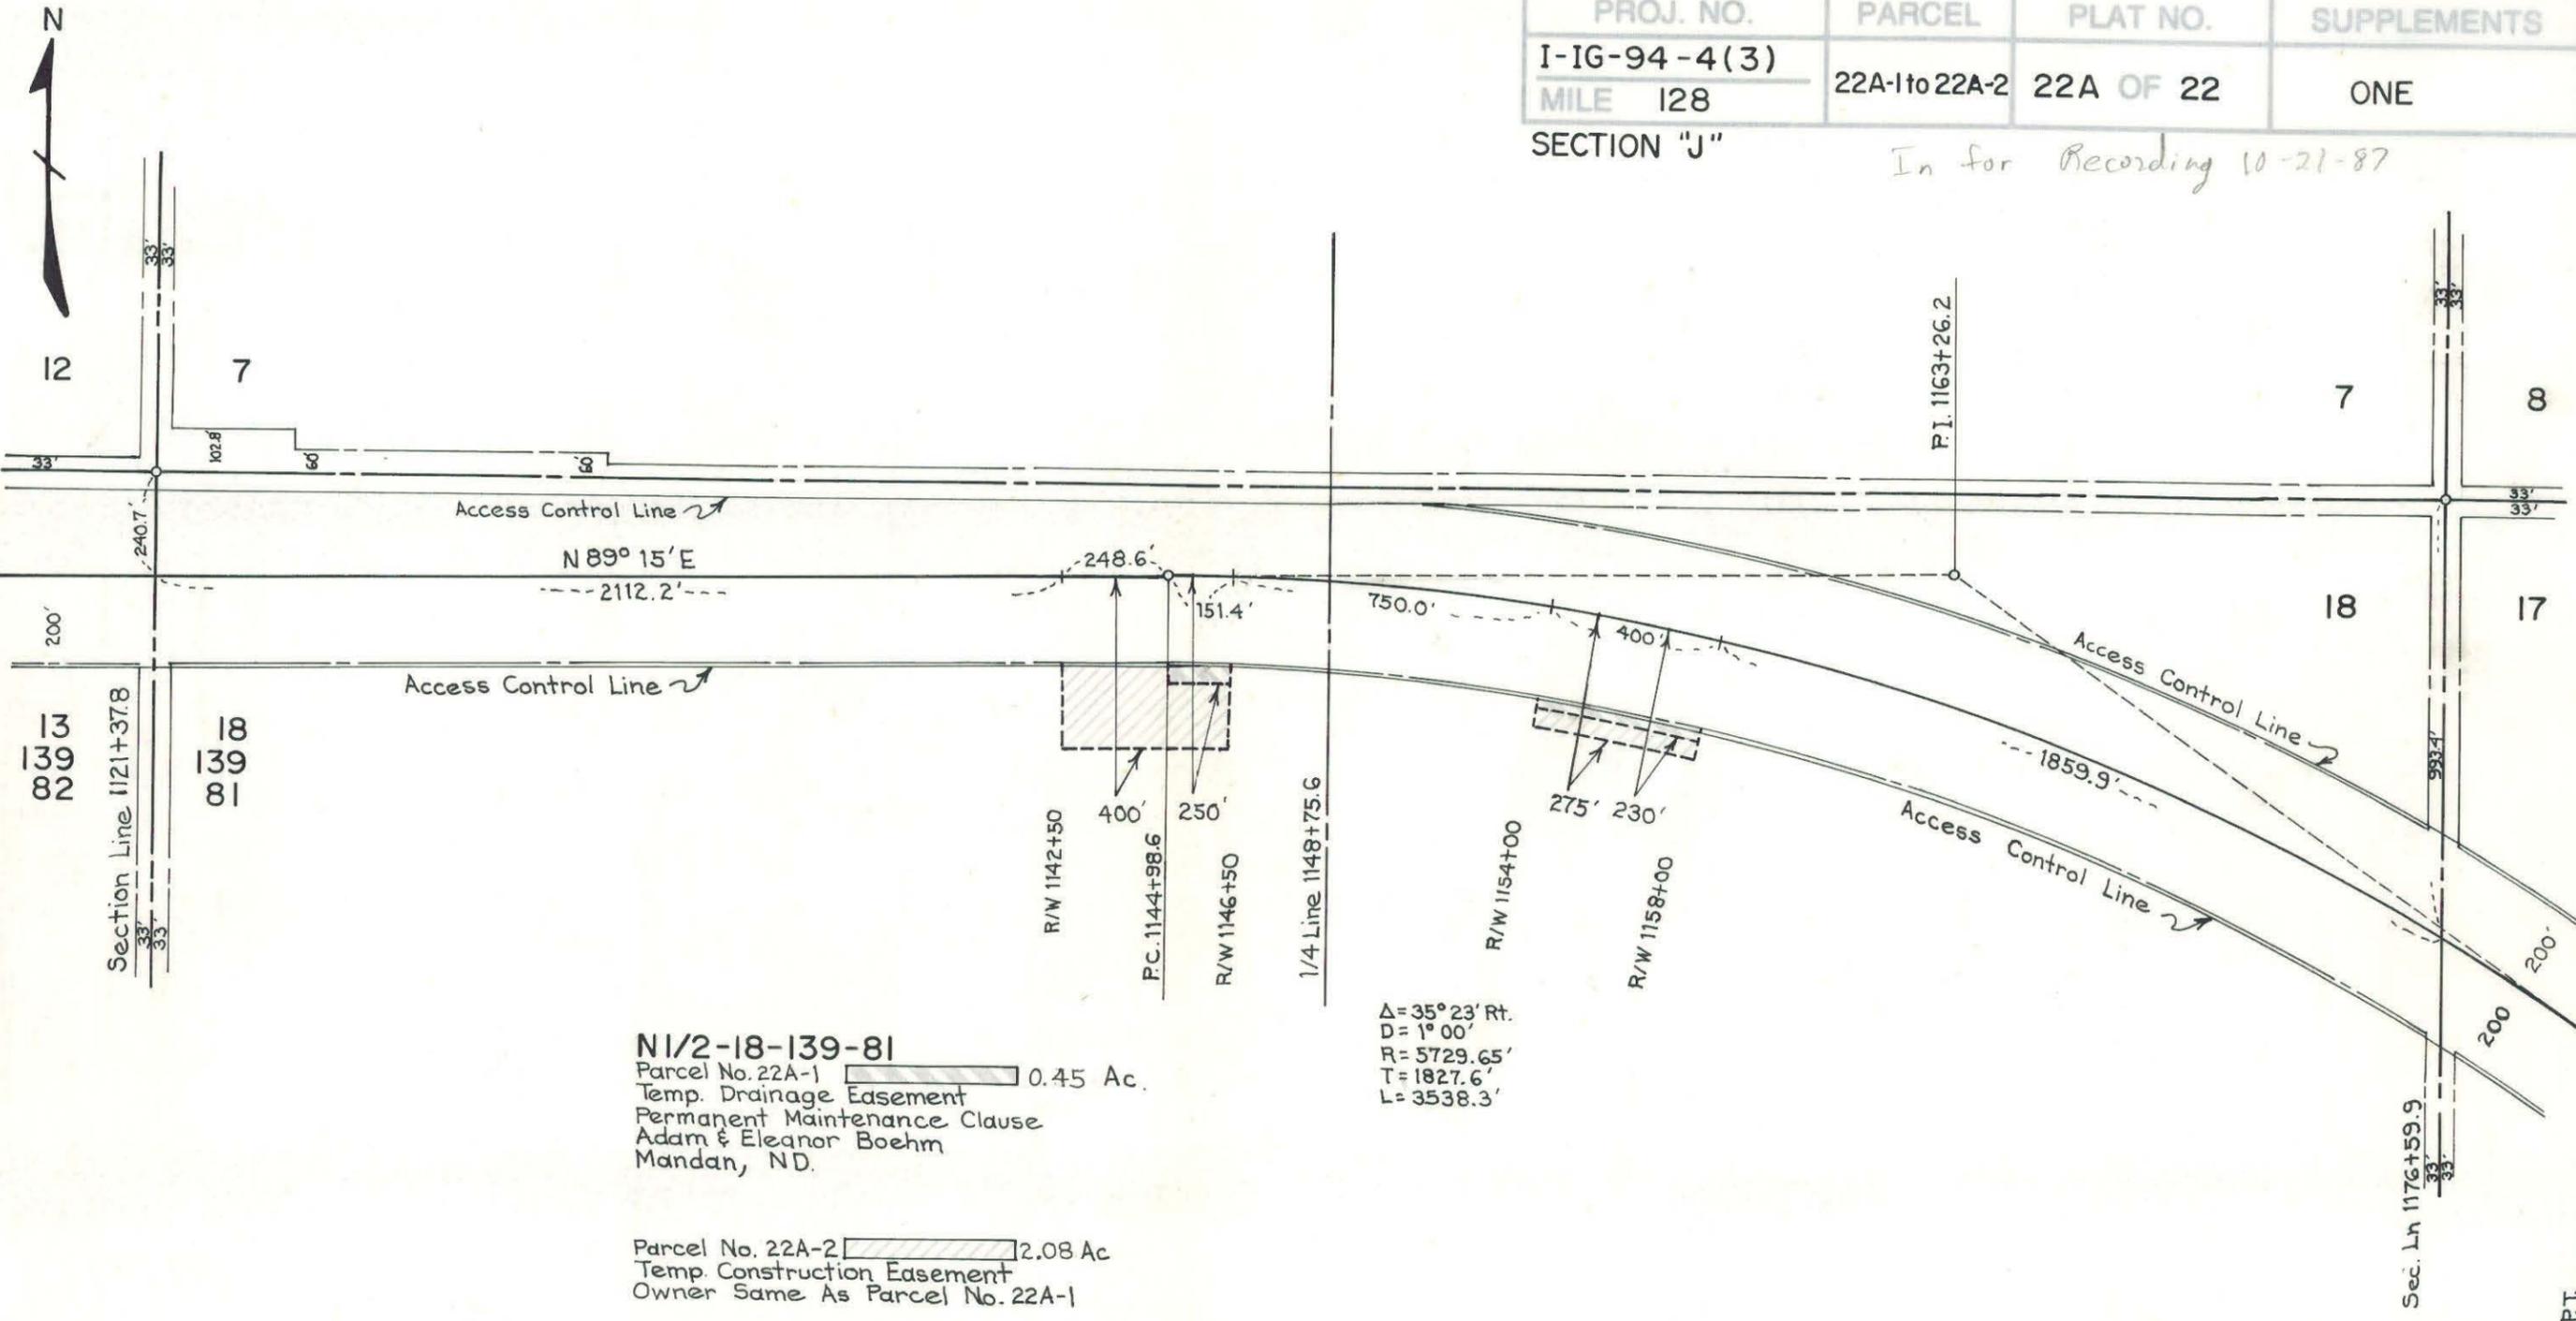

N1/2-18-139-81
 Parcel No. 22A-1 0.45 Ac.
 Temp. Drainage Easement
 Permanent Maintenance Clause
 Adam & Eleanor Boehm
 Mandan, ND.

Parcel No. 22A-2 2.08 Ac.
 Temp. Construction Easement
 Owner Same As Parcel No. 22A-1

NORTH DAKOTA
 STATE HIGHWAY DEPARTMENT

RIGHT OF WAY PLAT

PROJECT NO. I-IG-94-4(3)128

MORTON COUNTY
 APPROVED *Dave E. Leftwich*
 ENGINEER

This document was originally issued and sealed by Dave E. Leftwich, Registration Number LS 1971 on ___/___/___ and the original document is stored at the County Recorders Office

SCALE 1"=400' DATE 10/21/87

Parcel No. 22A-1

All that portion of the N $\frac{1}{2}$ of Sec. 18, Twp. 139 N., Rge. 81 W., 5th P.M., lying within a strip of land, measured on the southerly side of the following described highway centerline as surveyed and staked over and across said N $\frac{1}{2}$:

Said strip and centerline begin on the west line of said N $\frac{1}{2}$ where said centerline is located 240.7 ft. south of the northwest corner of said N $\frac{1}{2}$, where said strip is 200.0 ft. wide, thence running N89°15'E a distance of 2360.8 ft., more or less, to a point where said strip changes to 250.0 ft. in width, thence along a 1°00' curve to the right a distance of 151.4 ft., more or less, to a point where said strip changes to 200.0 ft. in width, thence continuing along said 1°00' curve to the right a distance of 750.0 ft., more or less, to a point where said strip changes to 230.0 ft. in width, thence continuing along said 1°00' curve to the right a distance of 400.0 ft.

Excepting all that portion of said N $\frac{1}{2}$ lying within 200.0 ft. of the above described centerline. Said strip is shown on the plat as Parcel No. 22A-1 and contains 0.45 acres.

Parcel No. 22A-2

All that portion of the N $\frac{1}{2}$ of Sec. 18, Twp. 139 N., Rge. 81 W., 5th P.M., lying within a strip of land, measured between two lines, said lines lying on the southerly side of the following described highway centerline as surveyed and staked over and across said N $\frac{1}{2}$:

Said highway centerline begins where said centerline is located 240.7 ft. south and 2112.2 ft. N89°15'E from the northwest corner of said N $\frac{1}{2}$, where said lines lie respectively 200.0 ft. and 400.0 ft. southerly of said centerline, thence running N89°15'E a distance of 248.6 ft., more or less, to a point where said lines lie respectively 250.0 ft. and 400.0 ft. southerly of said centerline, thence along a 1°00' curve to the right a distance of 151.4 ft., more or less, to a point where said lines lie respectively, each at 200 ft. southerly of said centerline, thence continuing along said 1°00' curve to the right a distance of 750.0 ft., more or less, to a point where said lines lie respectively 230.0 ft. and 275.0 ft. southerly of said centerline, thence continuing along said 1°00' curve to the right a distance of 400.0 ft.

Said strip is shown on the plat as Parcel No. 22A-2 and contains 2.08 acres.